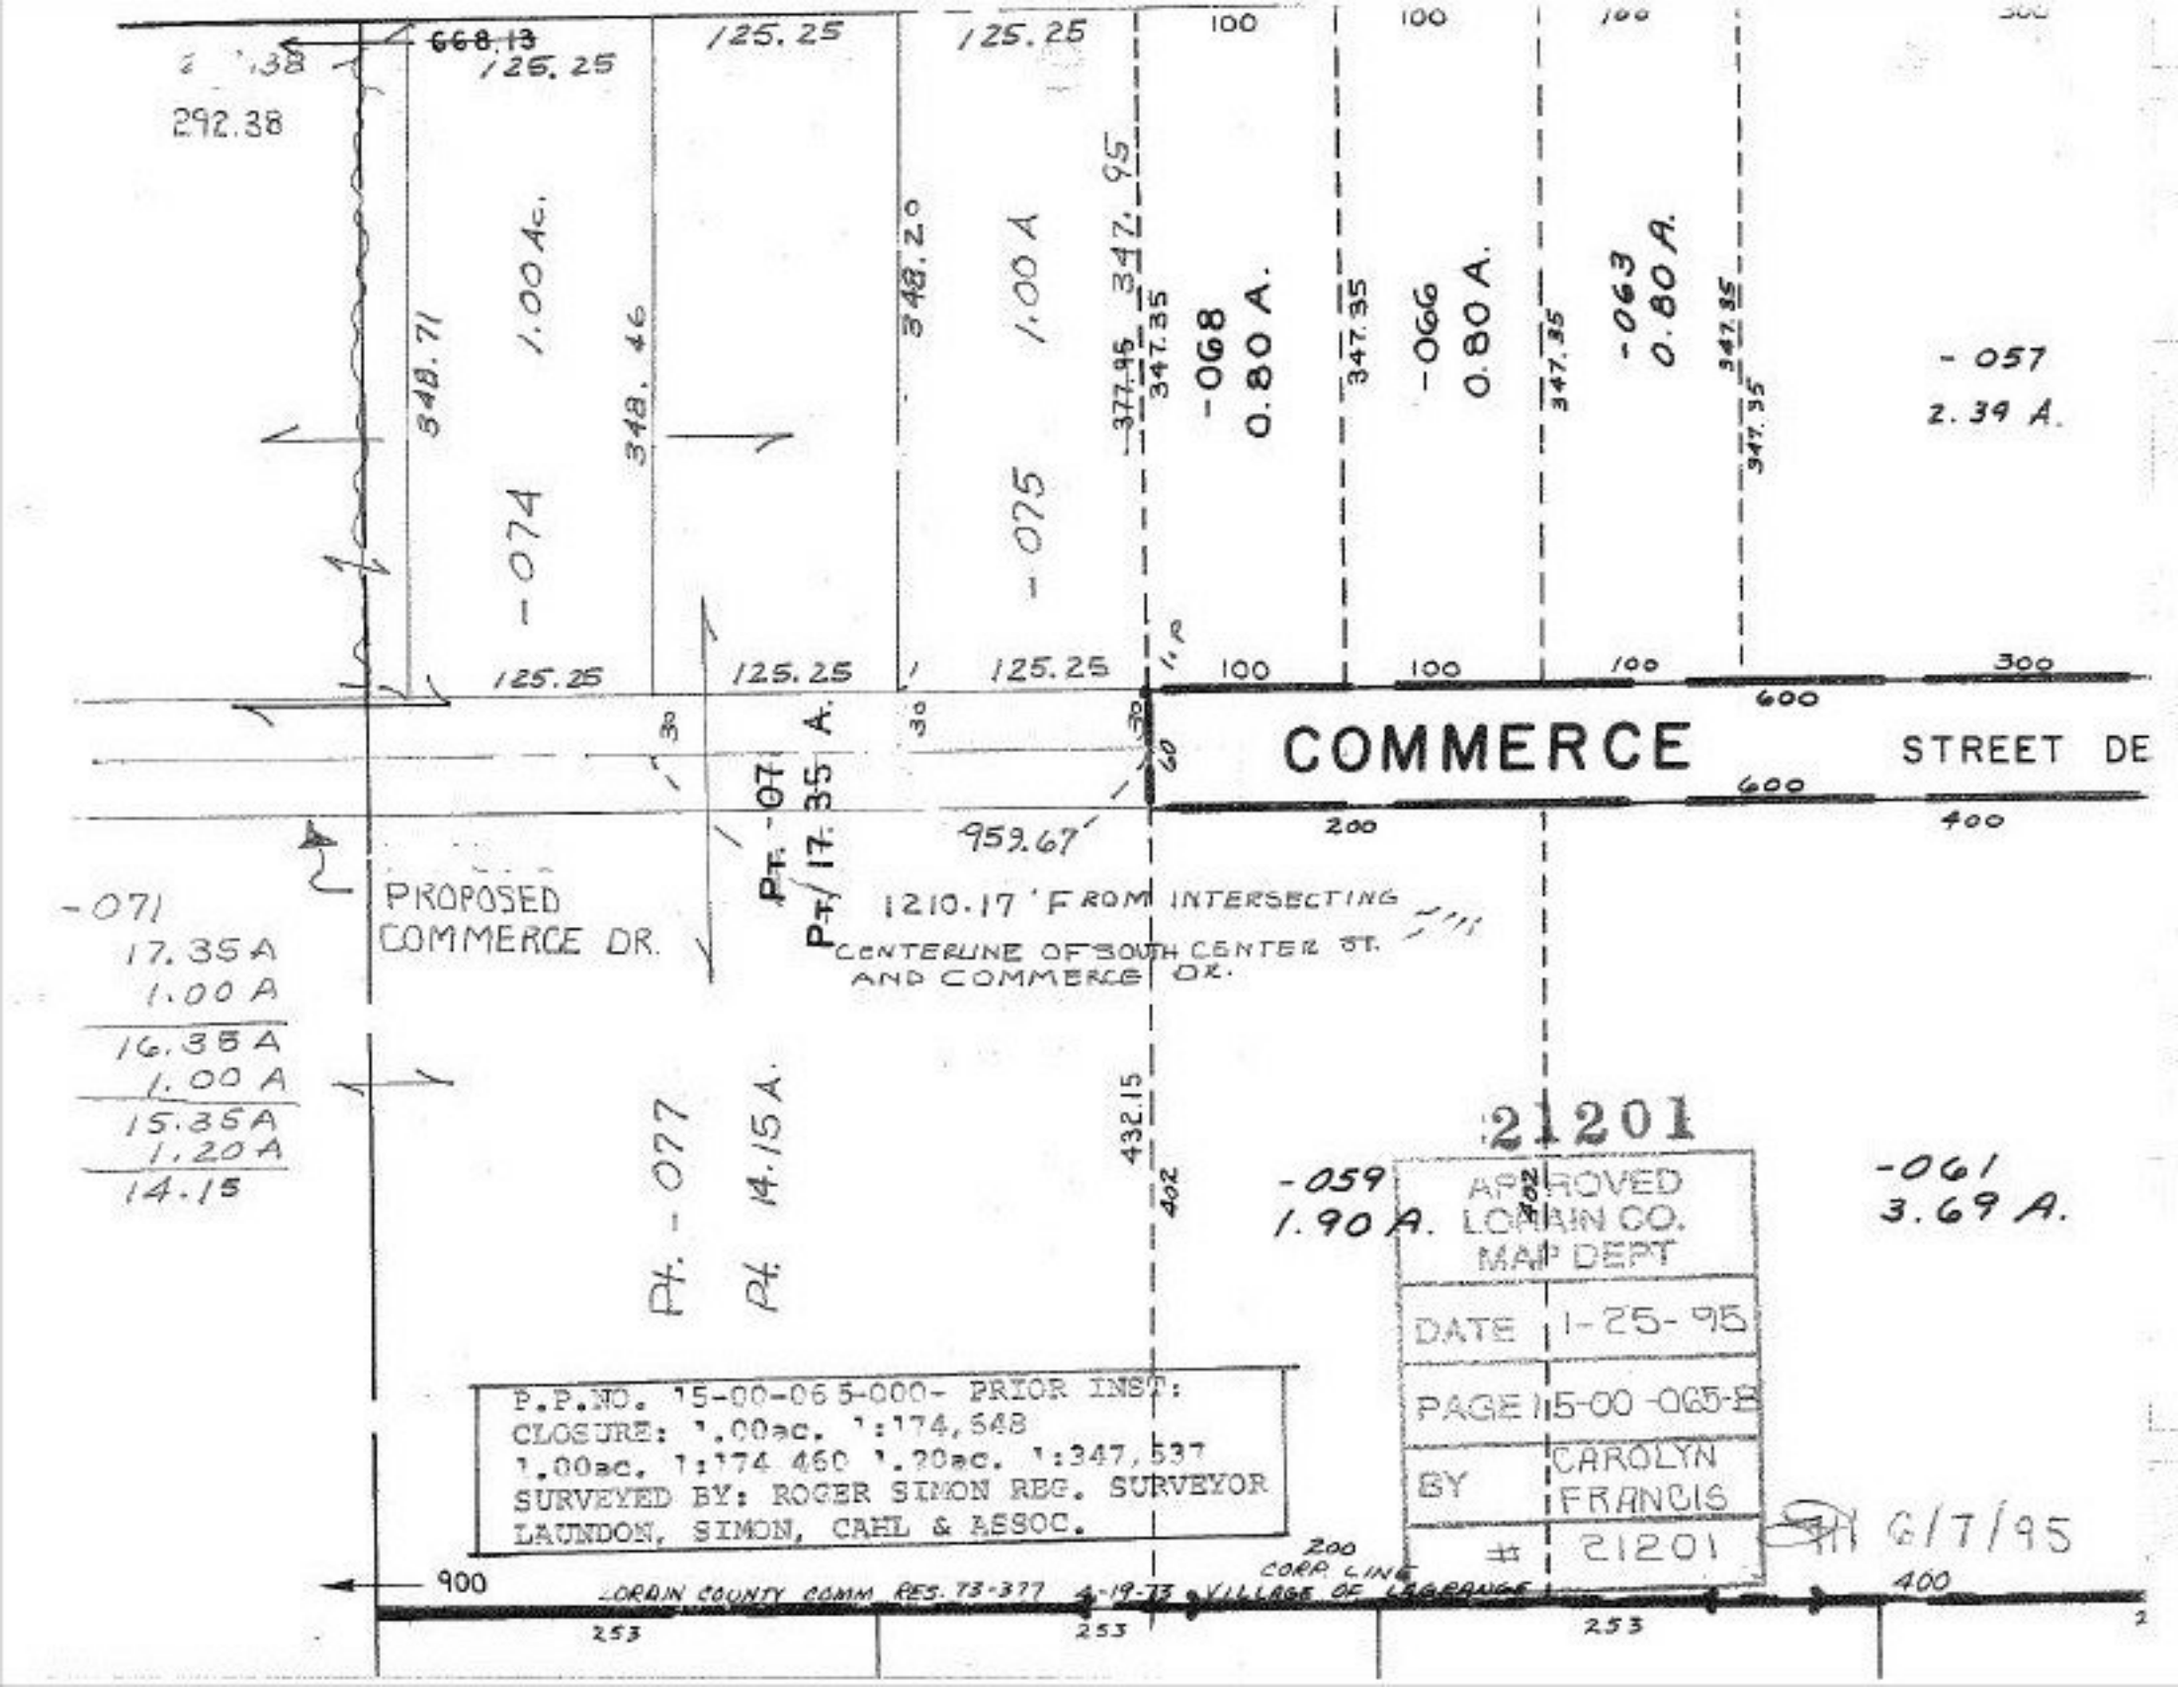
668.13
125.25
125.25
125.25
100
100
100
292.38
348.71
1.00 Ac.
348.46
348.20
1.00 A
347.95
347.35
-068
0.80 A.
-066
0.80 A.
-063
0.80 A.
-057
2.39 A.
-074
-075
125.25
125.25
125.25
100
100
100
300
600
COMMERCE
STREET DE
600
400
200
959.67
PROPOSED
COMMERCE DR.
Pt. -07
Pt. 17.35 A.
1210.17' FROM INTERSECTING
CENTERLINE OF SOUTH CENTER ST.
AND COMMERCE DR.
-071
17.35 A
1.00 A
16.35 A
1.00 A
15.35 A
1.20 A
14.15
Pt. -077
Pt. 14.15 A.
432.15
402
302
21201
-059
1.90 A.
-061
3.69 A.
APPROVED
LORAIN CO.
MAP DEPT
DATE 1-25-95
PAGE 15-00-065-B
BY CAROLYN FRANCIS
21201
6/7/95
P.P.NO. 15-00-065-000- PRIOR INST:
CLOSURE: 1.00ac. 1:174,548
1.00ac. 1:174 460 1.20ac. 1:347,537
SURVEYED BY: ROGER SIMON REG. SURVEYOR
LAUNDON, SIMON, CAHL & ASSOC.
900
LORAIN COUNTY COMM. RES. 73-377 4-19-73 VILLAGE OF LAGRANGE
200
CORP LINE
400
253
253
253
2