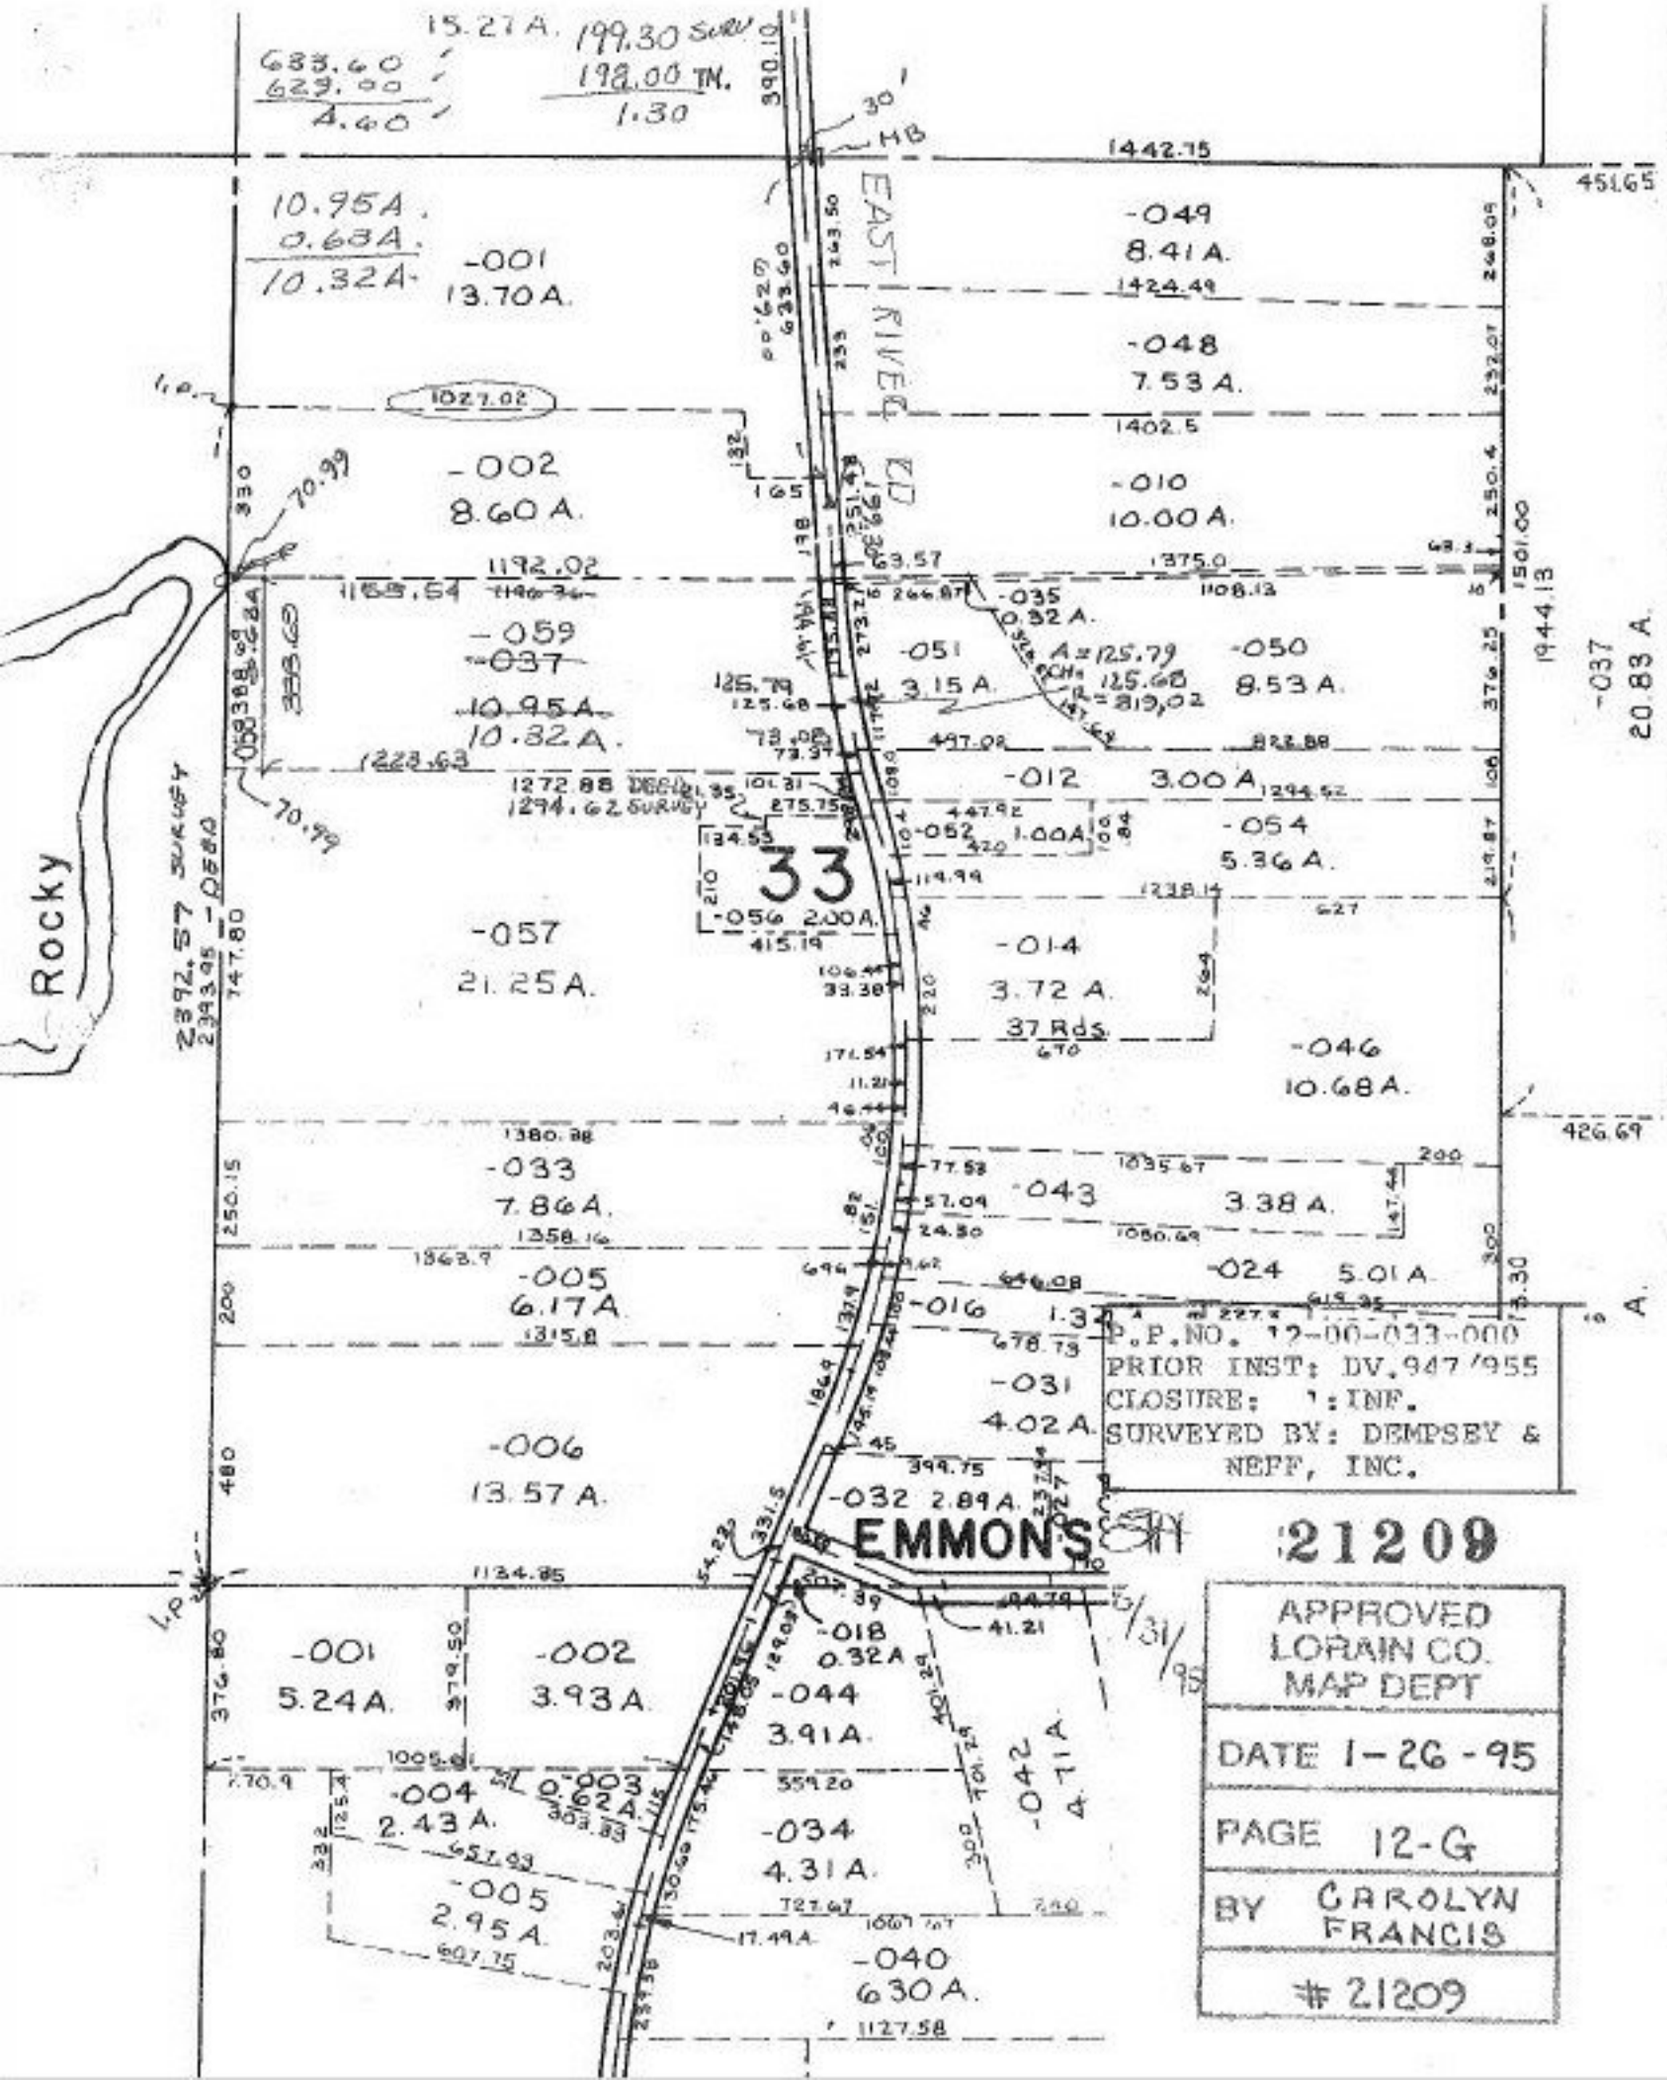
15.27 A. 199.30 Surv
198.00 TM.
1.30
633.60
629.00
4.40
1442.75
451.65
10.95A.
0.63A.
10.32A.
-001
13.70A.
-049
8.41A.
1424.49
-048
7.53A.
1402.5
-002
8.60A.
-010
10.00A.
1192.02
1159.54
-059
-037
10.95A.
10.82A.
1223.63
1272.88 DEED
1294.62 SURVEY
-035
0.32A.
-051
3.15A.
-050
8.53A.
-012
3.00A
-052
1.00A
-054
5.36A.
33
-056 2.00A.
-057
21.25A.
-014
3.72A.
37 Rds.
-046
10.68A.
2392.57 SURVEY
2393.95 DEED
747.80
Rocky
1380.38
-033
7.86A.
1358.16
-005
6.17A.
1315.8
-006
13.57A.
-043
3.38A.
-024
5.01A.
-016
1.3
-031
4.02A.
-032 2.89A.
EMMONS
1134.85
-001
5.24A.
-002
3.93A.
-018
0.32A
-044
3.91A.
-042
4.11A.
-003
0.62A.
-004
2.43A.
-034
4.31A.
-005
2.95A.
17.49A.
-040
630A.
1127.58
P.P.NO. 12-06-033-000
PRIOR INST: DV.947/955
CLOSURE: 1:INF.
SURVEYED BY: DEMPSEY & NEFF, INC.
21209
APPROVED
LORAIN CO.
MAP DEPT
DATE 1-26-95
PAGE 12-G
BY CAROLYN FRANCIS
21209