21213-D

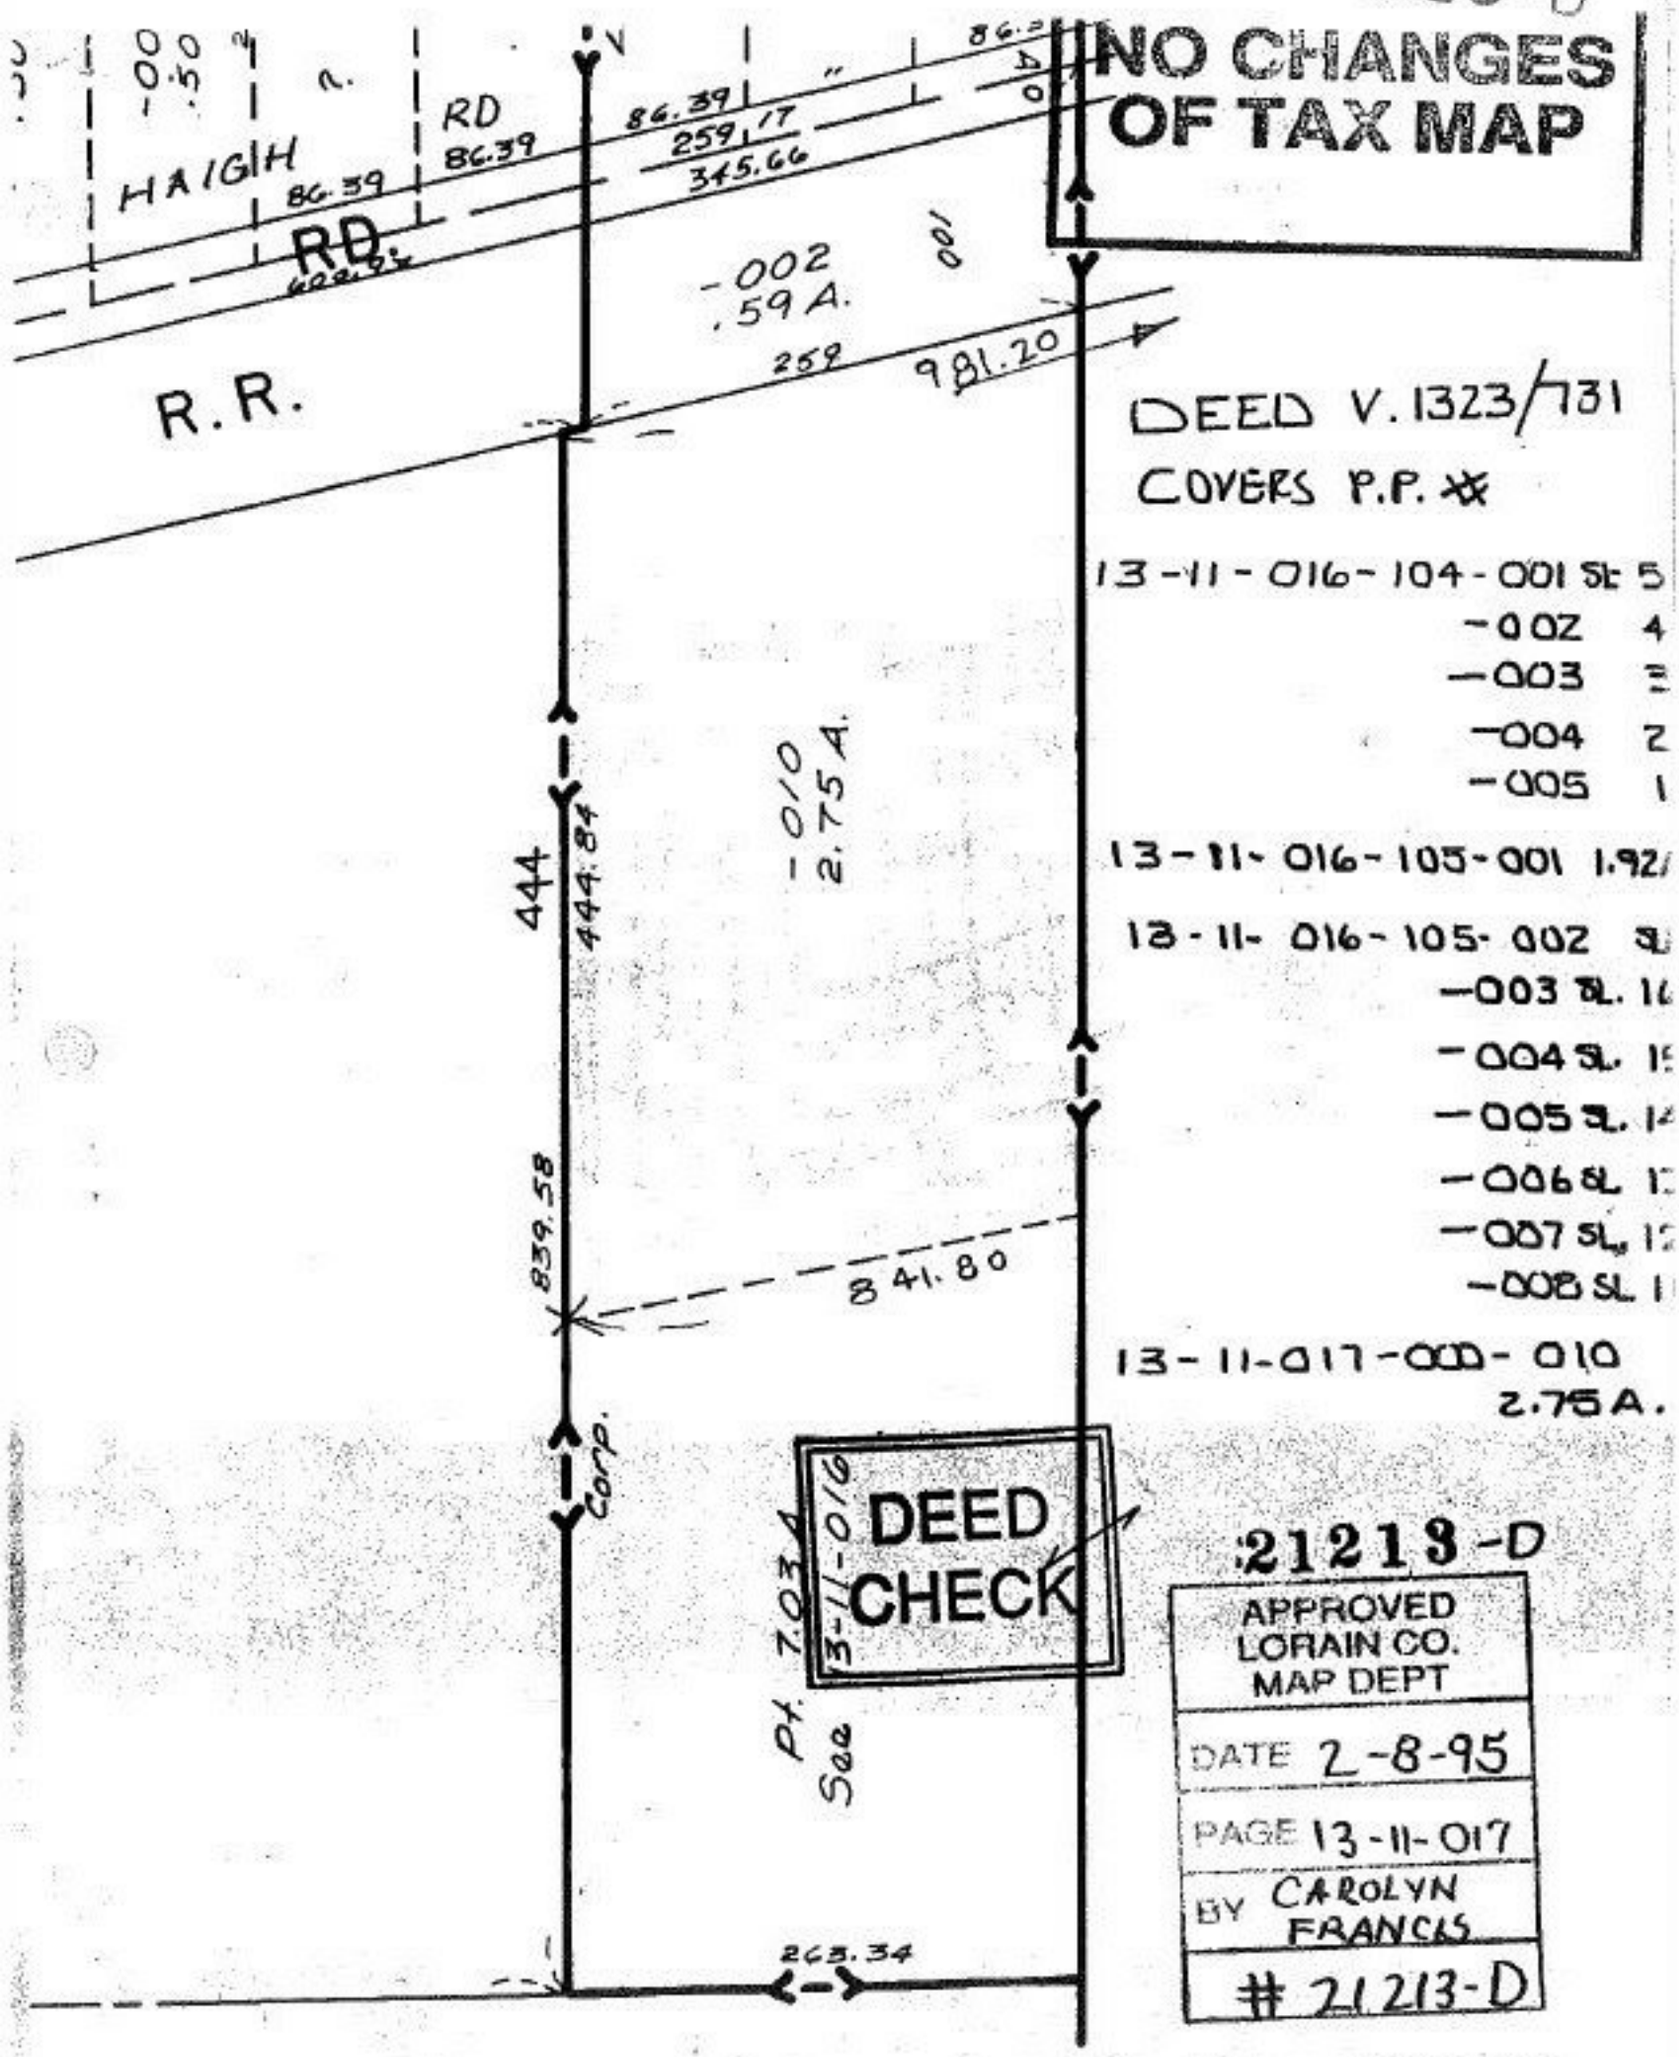
NO CHANGES OF TAX MAP
HAIGH RD
86.39
RD
86.39
259.17
345.66
RD
60ft.R's
-002
.59 A.
001
R.R.
259
981.20
DEED V. 1323/731
COVERS P.P. *
13-11-016-104-001 St 5
-002 4
-003 3
-004 2
-005 1
13-11-016-105-001 1.92
13-11-016-105-002 SL
-003 SL. 1
-004 SL. 1
-005 SL. 1
-006 SL 1
-007 SL, 1
-008 SL 1
444
444.84
-010
2.75 A.
839.58
841.80
13-11-017-000-010
2.75 A.
Corp.
DEED CHECK
13-11-016
Pt. 7.03 A.
See
263.34
21213-D
APPROVED LORAIN CO. MAP DEPT
DATE 2-8-95
PAGE 13-11-017
BY CAROLYN FRANCIS
21213-D