21214

P.P.NO. 05-00-057-000
PRIOR INST: O.R.805/162
CLOSURE: 1:INF.
SURVEYED BY: KS ASSOC.

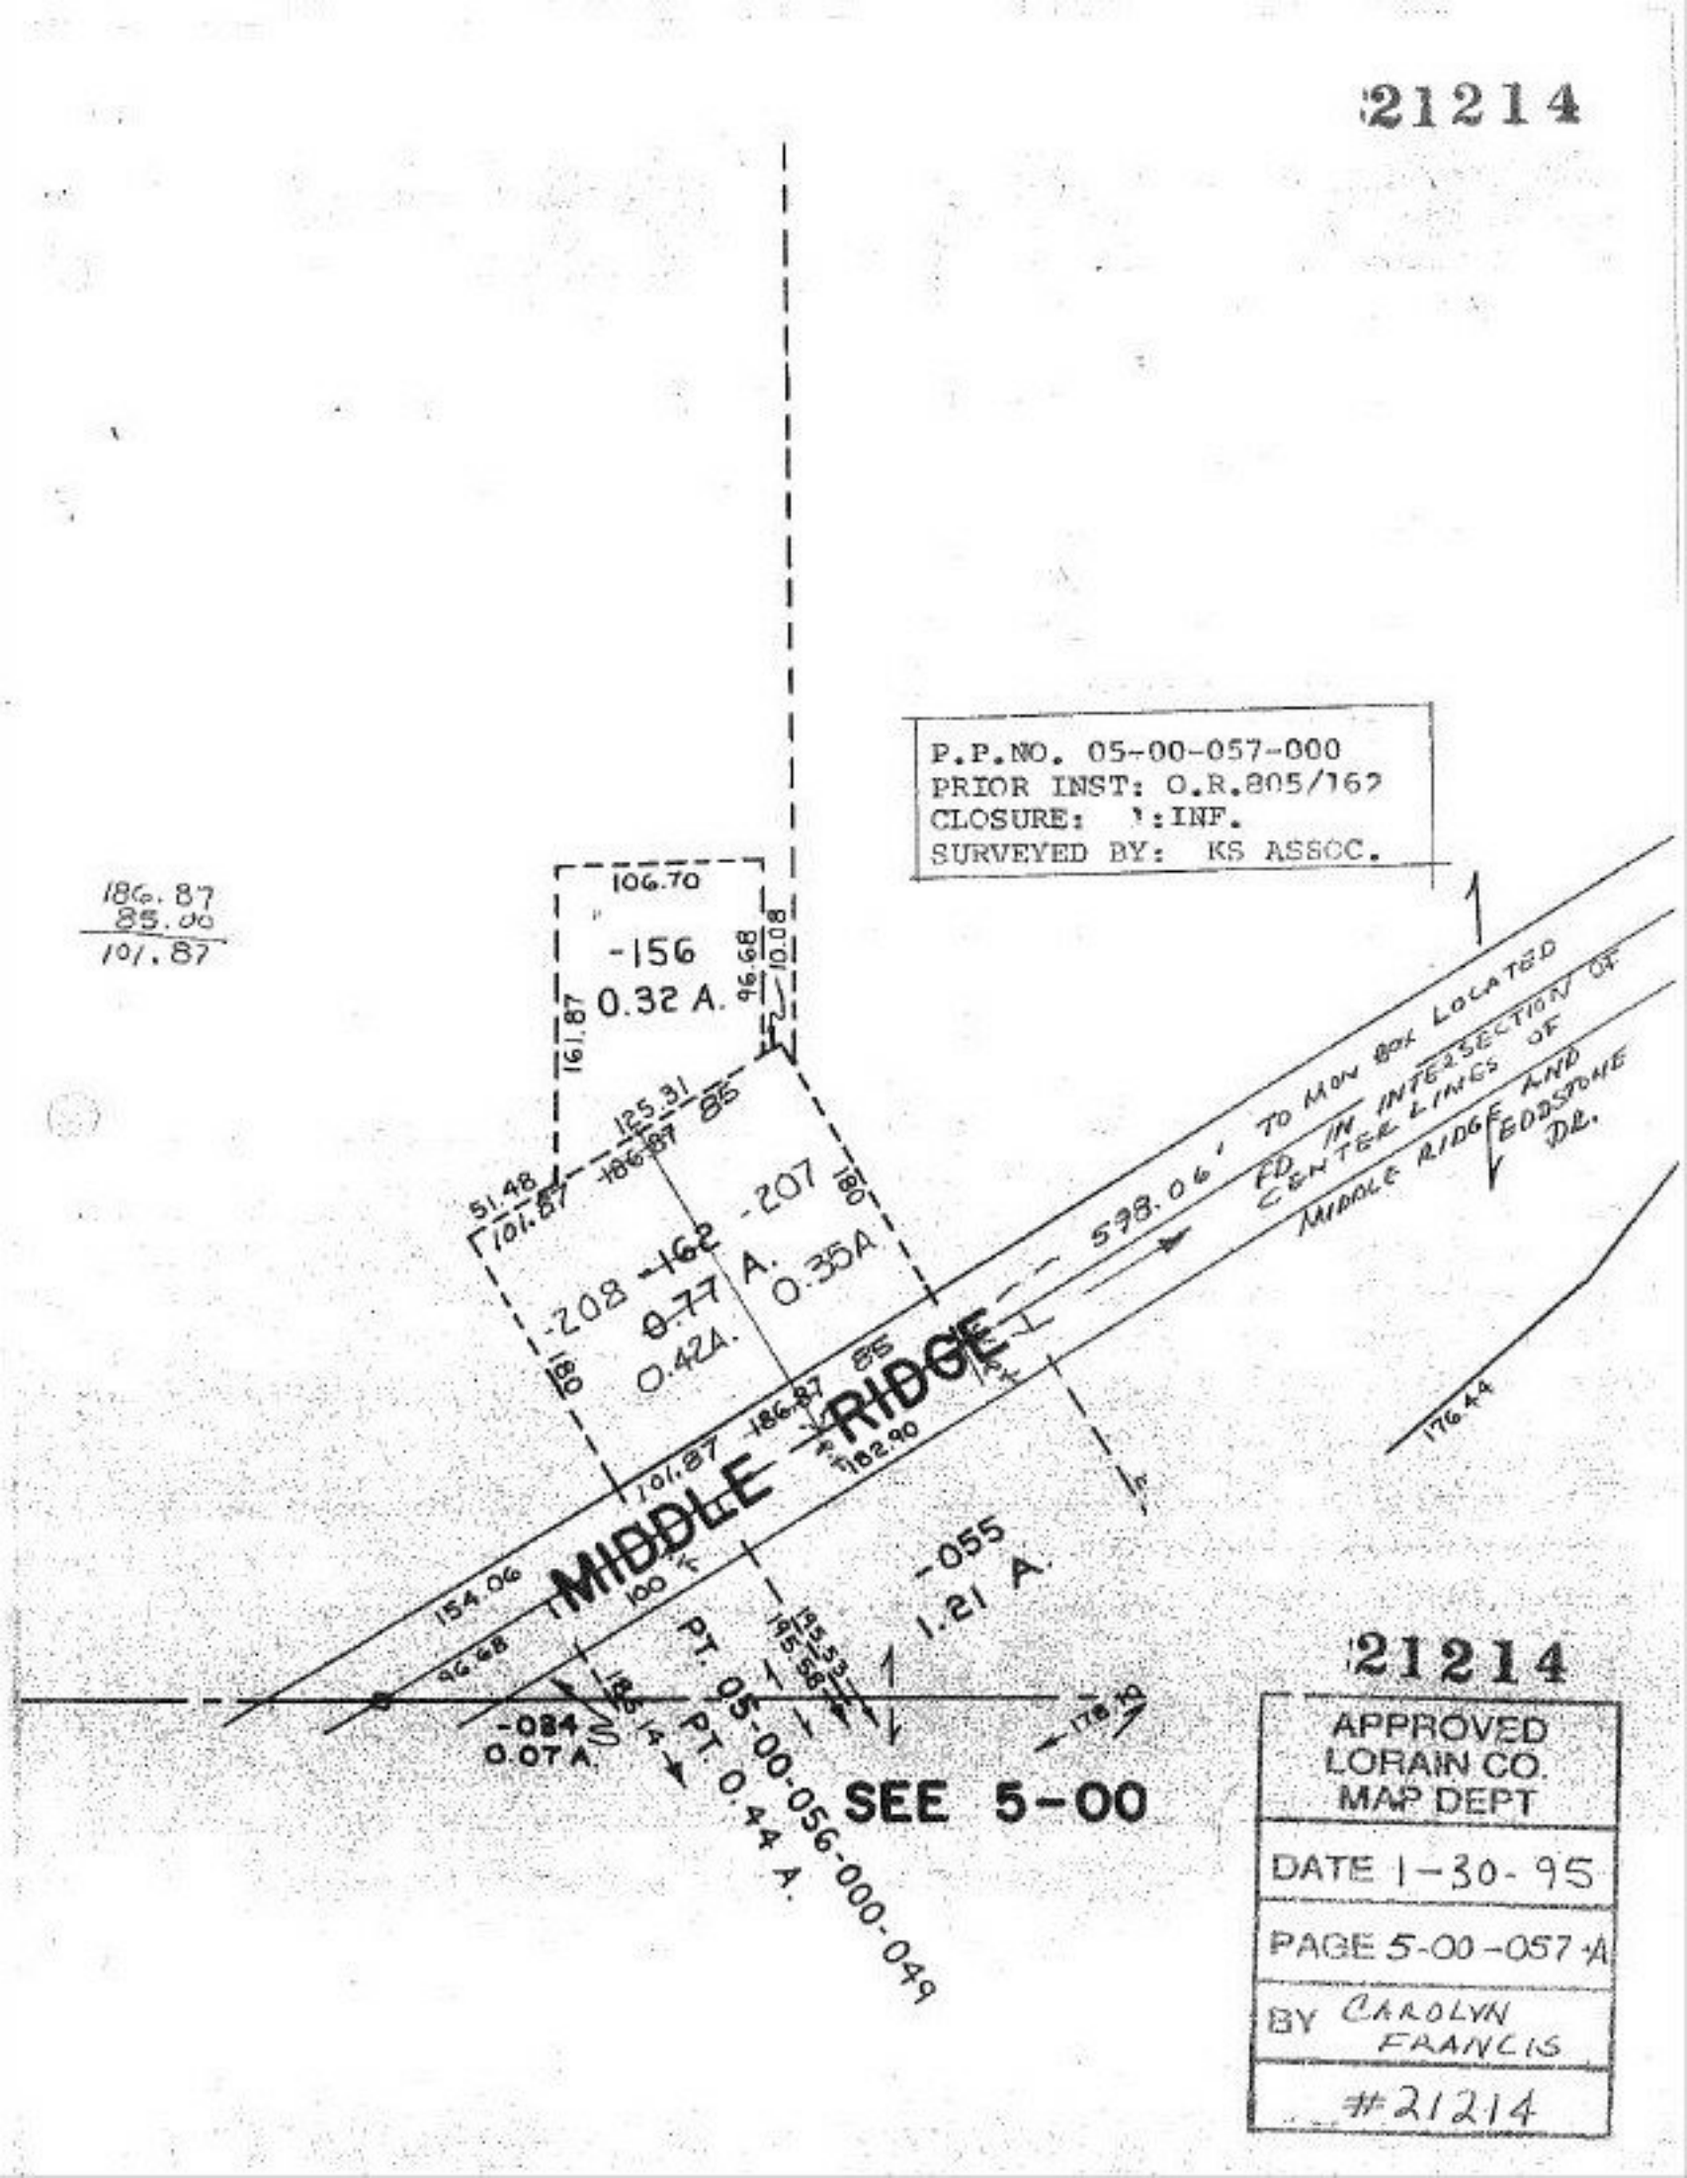

21214

APPROVED LORAIN CO. MAP DEPT
DATE 1-30-95
PAGE 5-00-057 A
BY CAROLYN FRANCIS
#21214