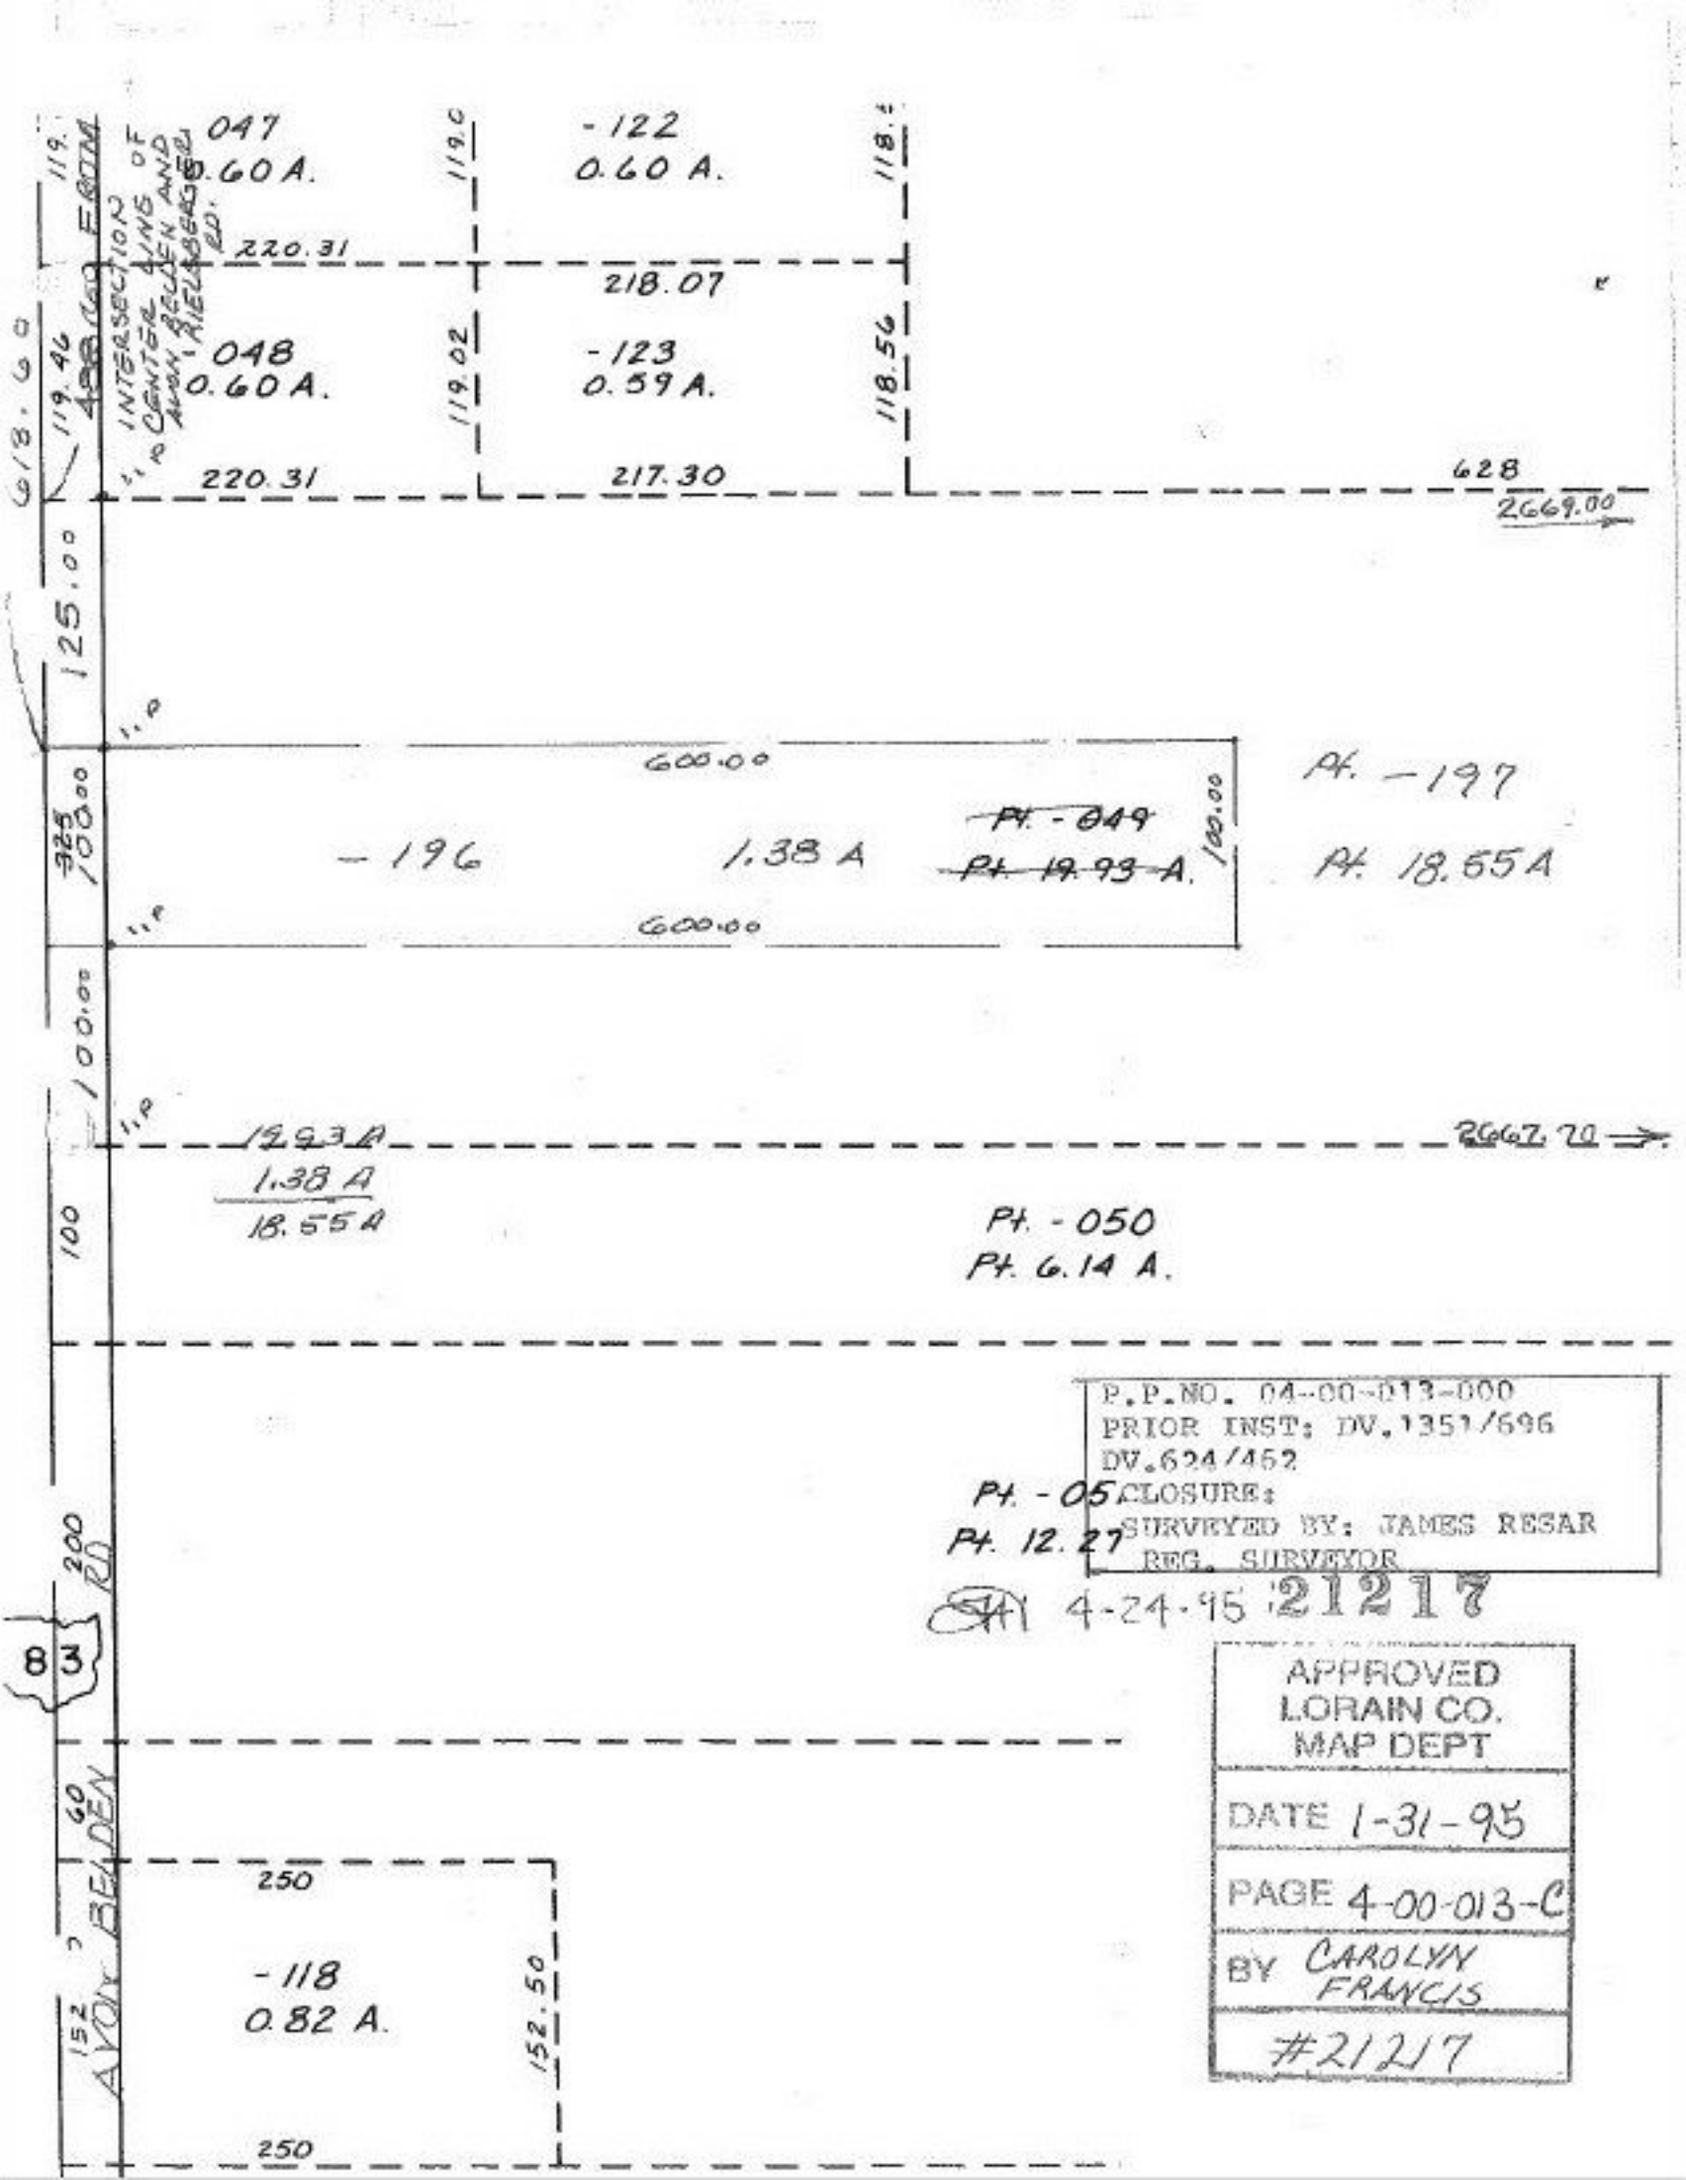
047
0.60 A.
-122
0.60 A.
220.31
218.07
048
0.60 A.
-123
0.59 A.
220.31
217.30
628
2669.00
INTERSECTION OF CENTER LINES OF AVON, BELDEN AND NIELSBERGER RDS.
618.60
119.46
125.00
600.00
-196
1.38 A
Pt. -049
Pt. 19.93 A.
Pt. -197
Pt. 18.55 A
600.00
100.00
1.38 A
18.55 A
Pt. -050
Pt. 6.14 A.
2667.70
Pt. -05
Pt. 12.27
200 RD
8
3
AVON BELDEN
40
250
-118
0.82 A.
152.50
250
P.P.NO. 04-00-013-000
PRIOR INST: DV.1351/696
DV.624/452
CLOSURE:
SURVEYED BY: JAMES RESAR
REG. SURVEYOR
4-24-95
21217
APPROVED
LORAIN CO.
MAP DEPT
DATE 1-31-95
PAGE 4-00-013-C
BY CAROLYN FRANCIS
#21217