52.19 A
3.61 A
48.58 A

ANNEX TO
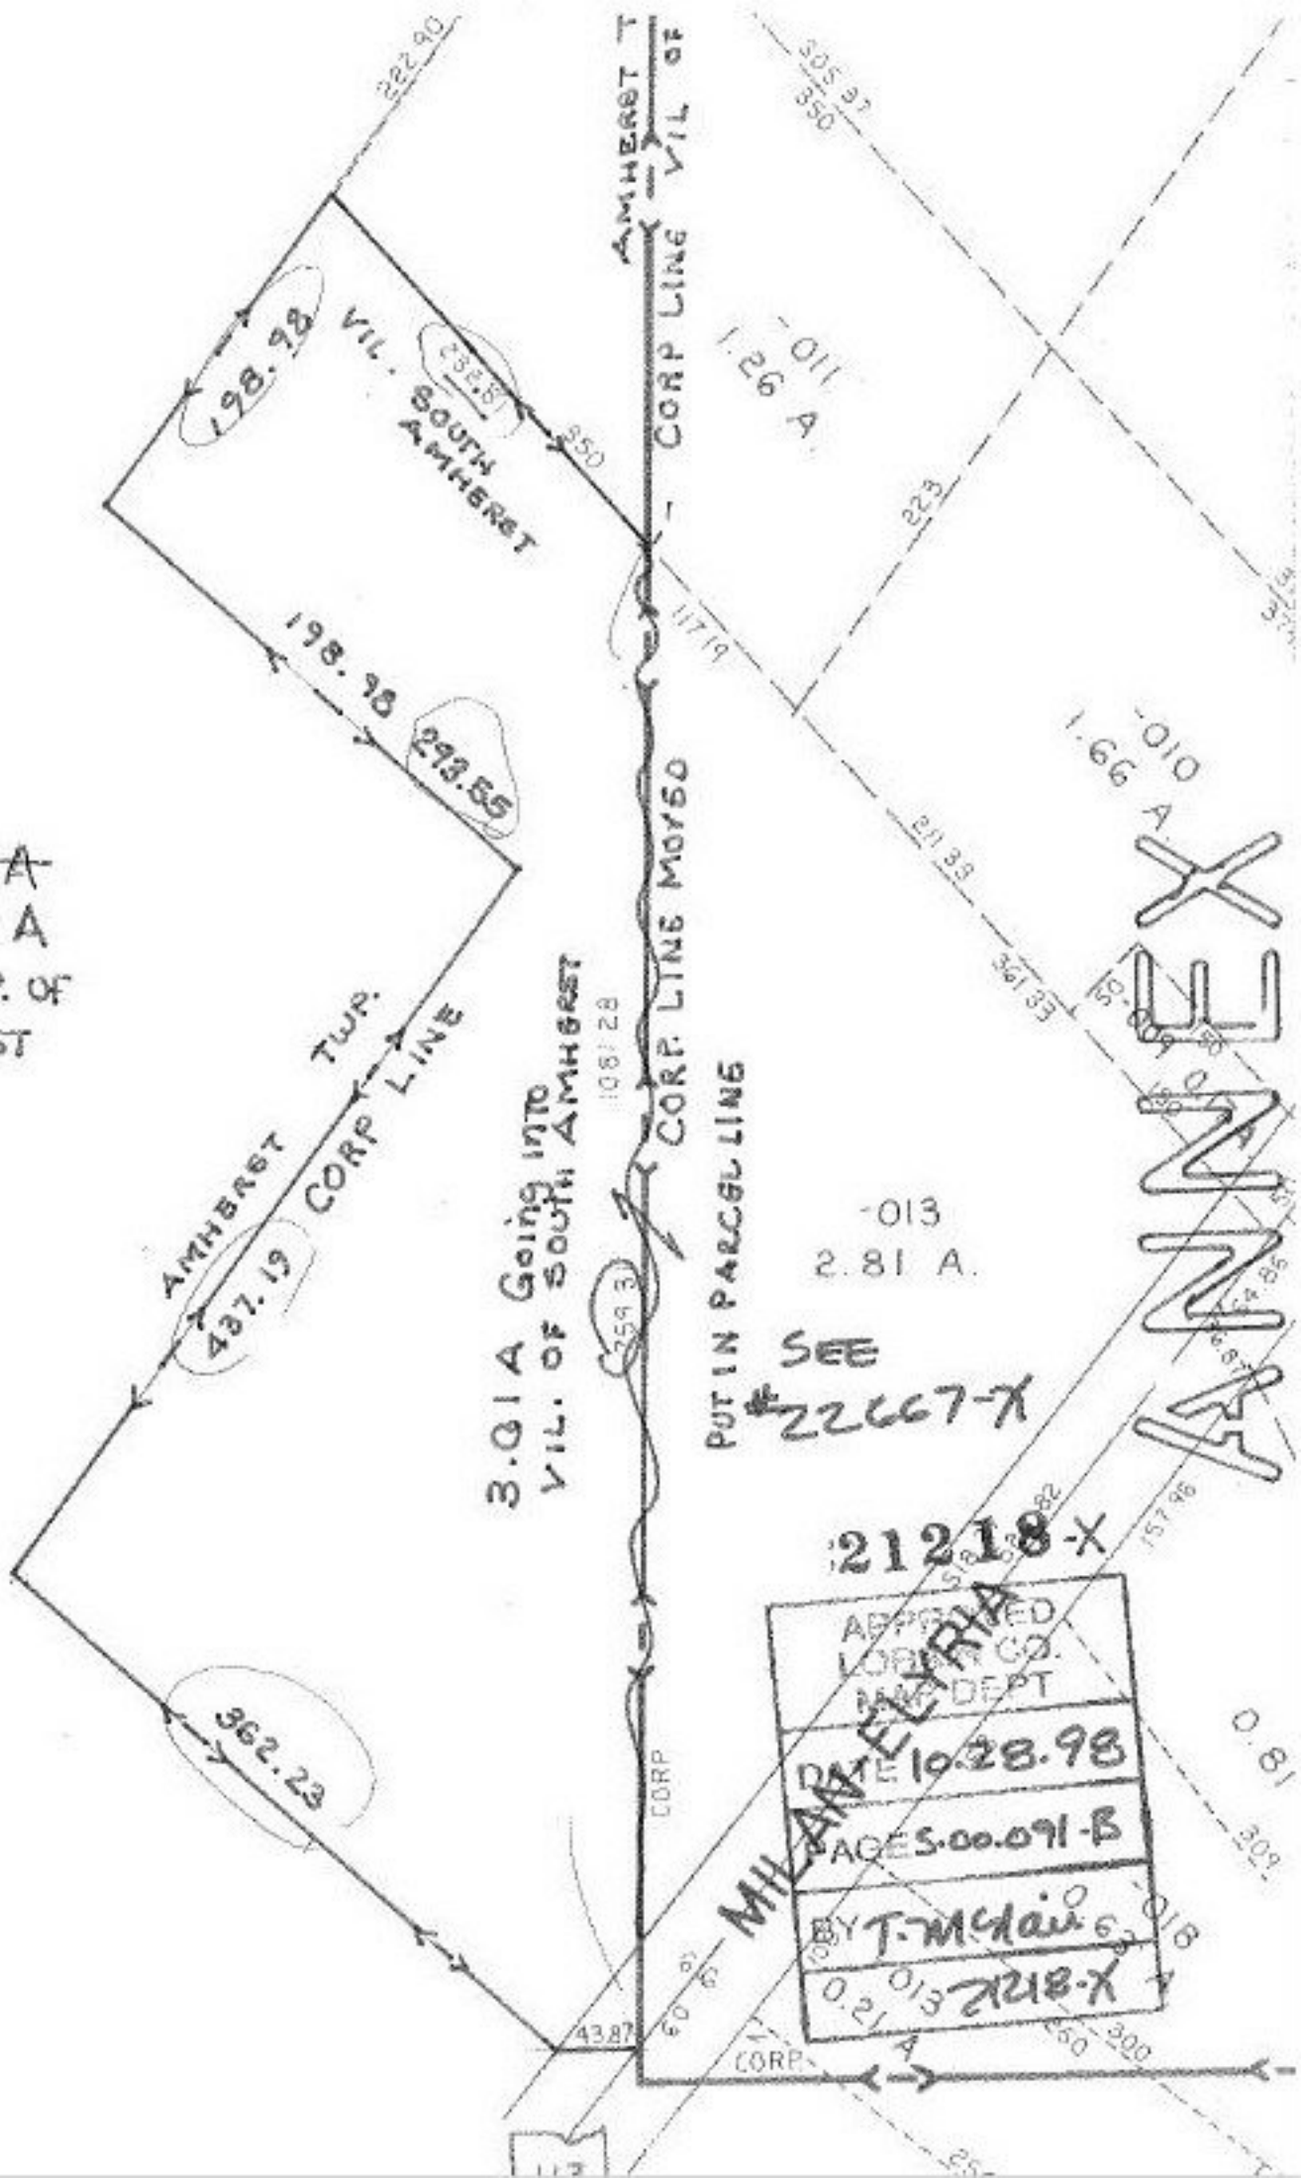
-015
~~-013~~
~~52.19 A~~
48.58 A
IN TWP. OF
AMHERST