21221

SEE 3-

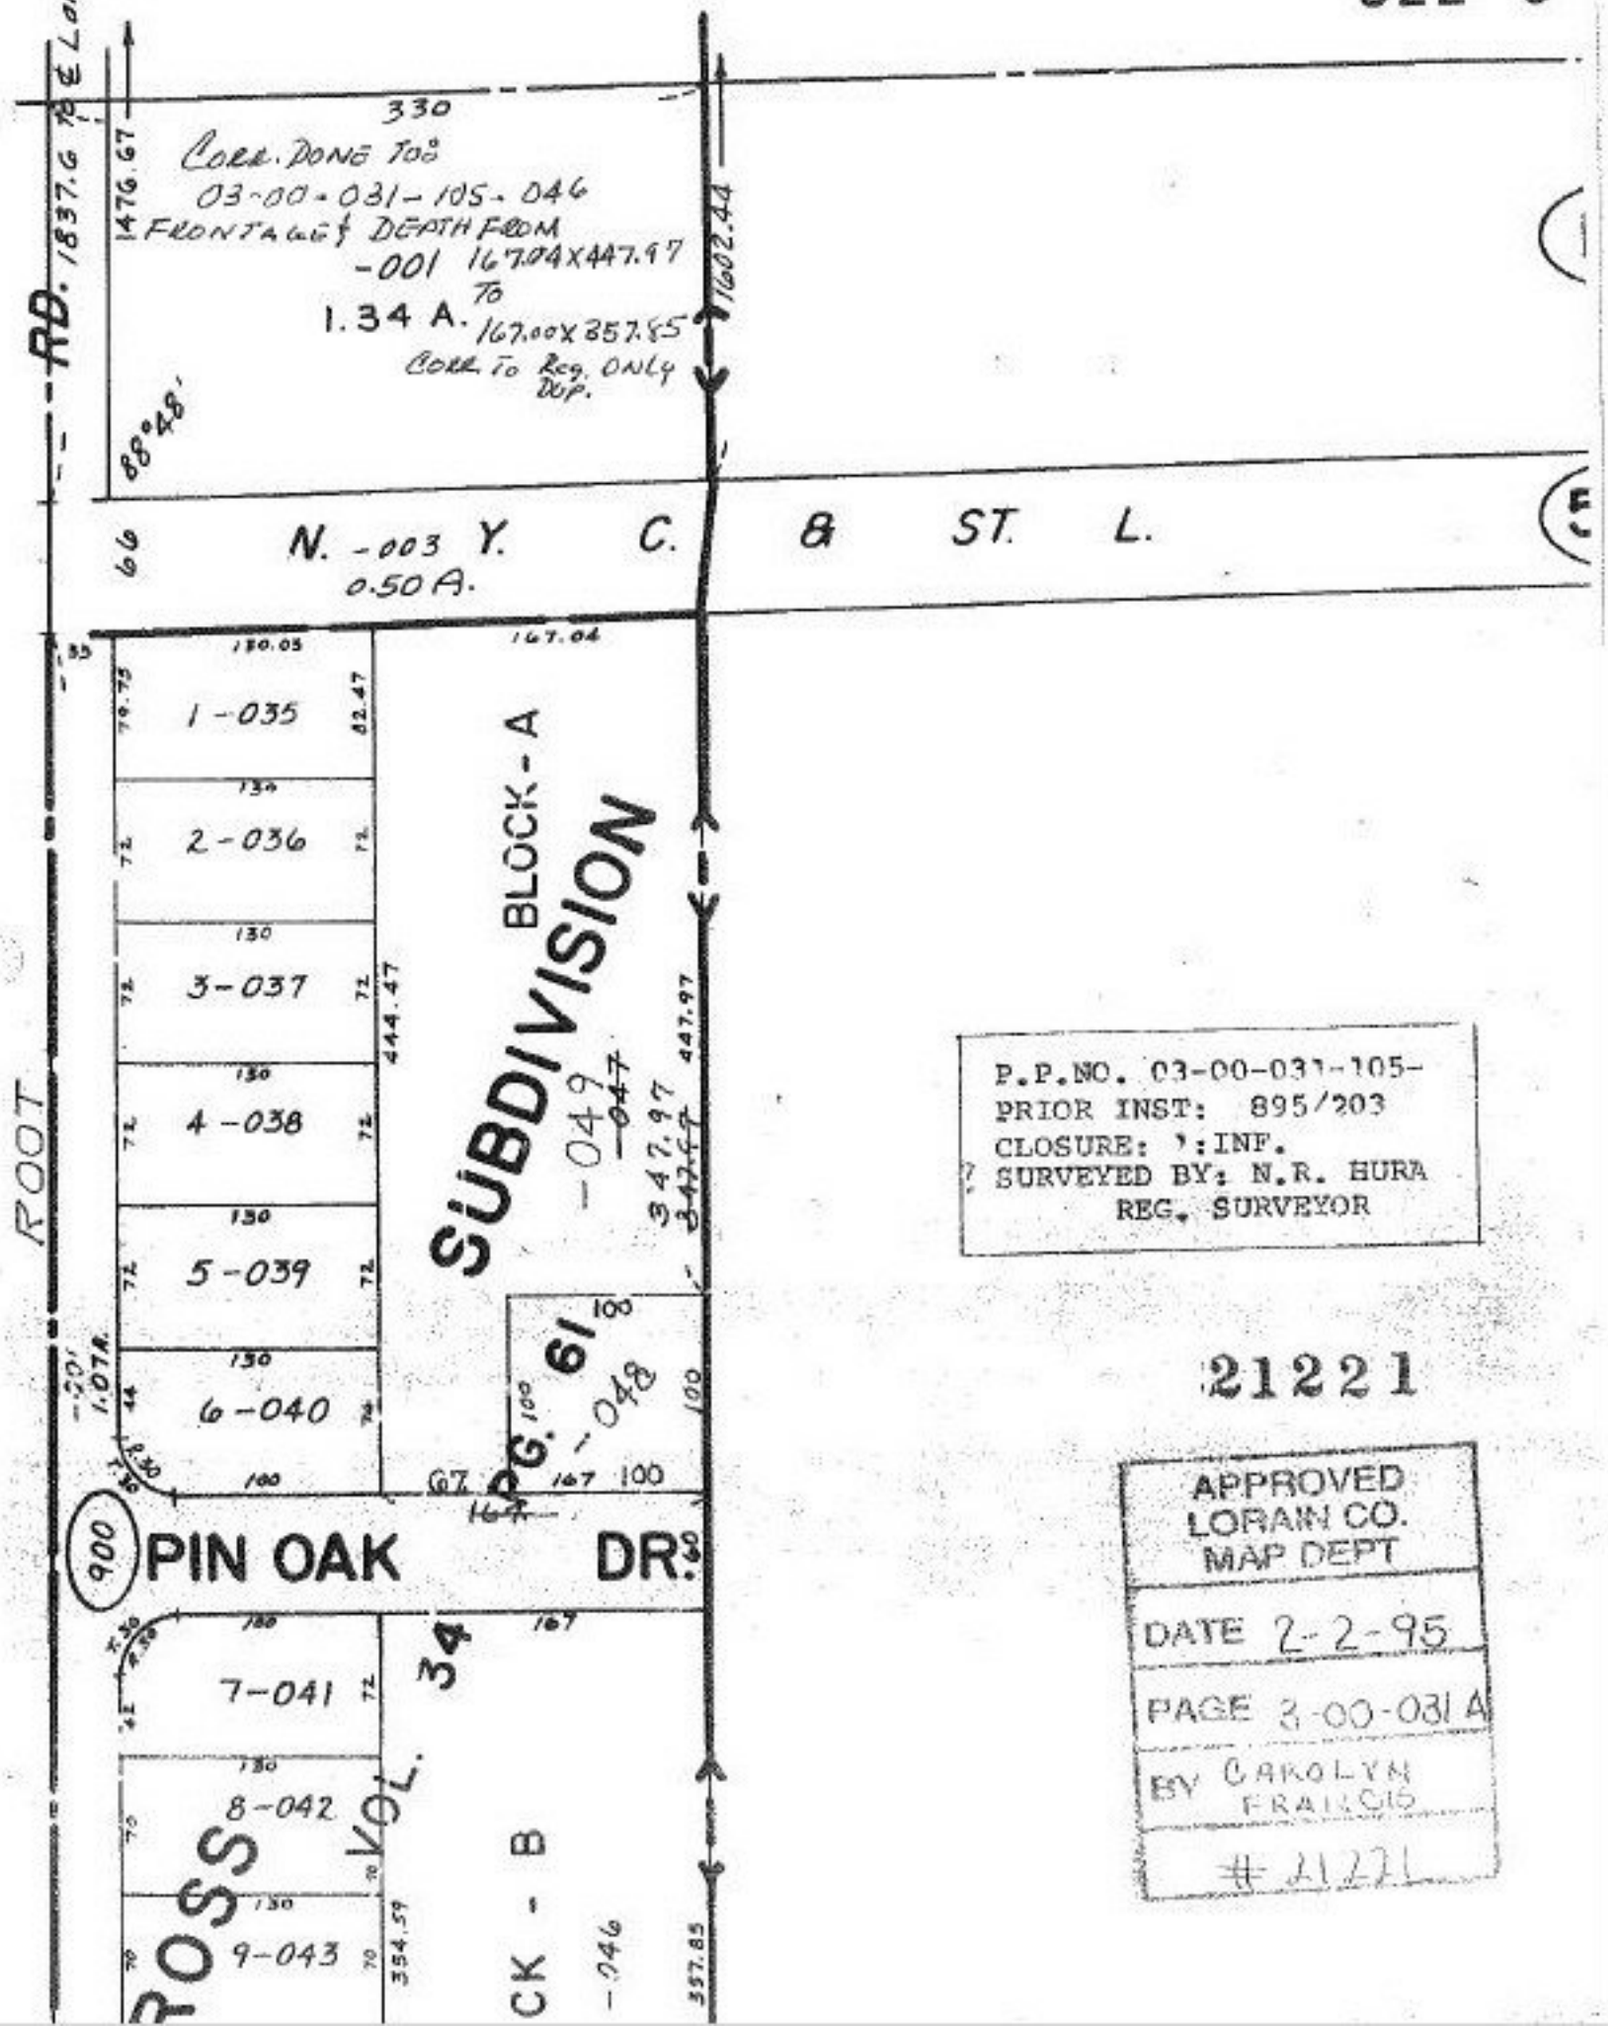

P.P.NO. 03-00-031-105-
PRIOR INST: 895/203
CLOSURE: ':INF.
SURVEYED BY: N.R. HURA
REG. SURVEYOR

21221

APPROVED
LORAIN CO.
MAP DEPT

DATE 2-2-95

PAGE 3-00-031A

BY CAROLYN FRANCIS

#21221