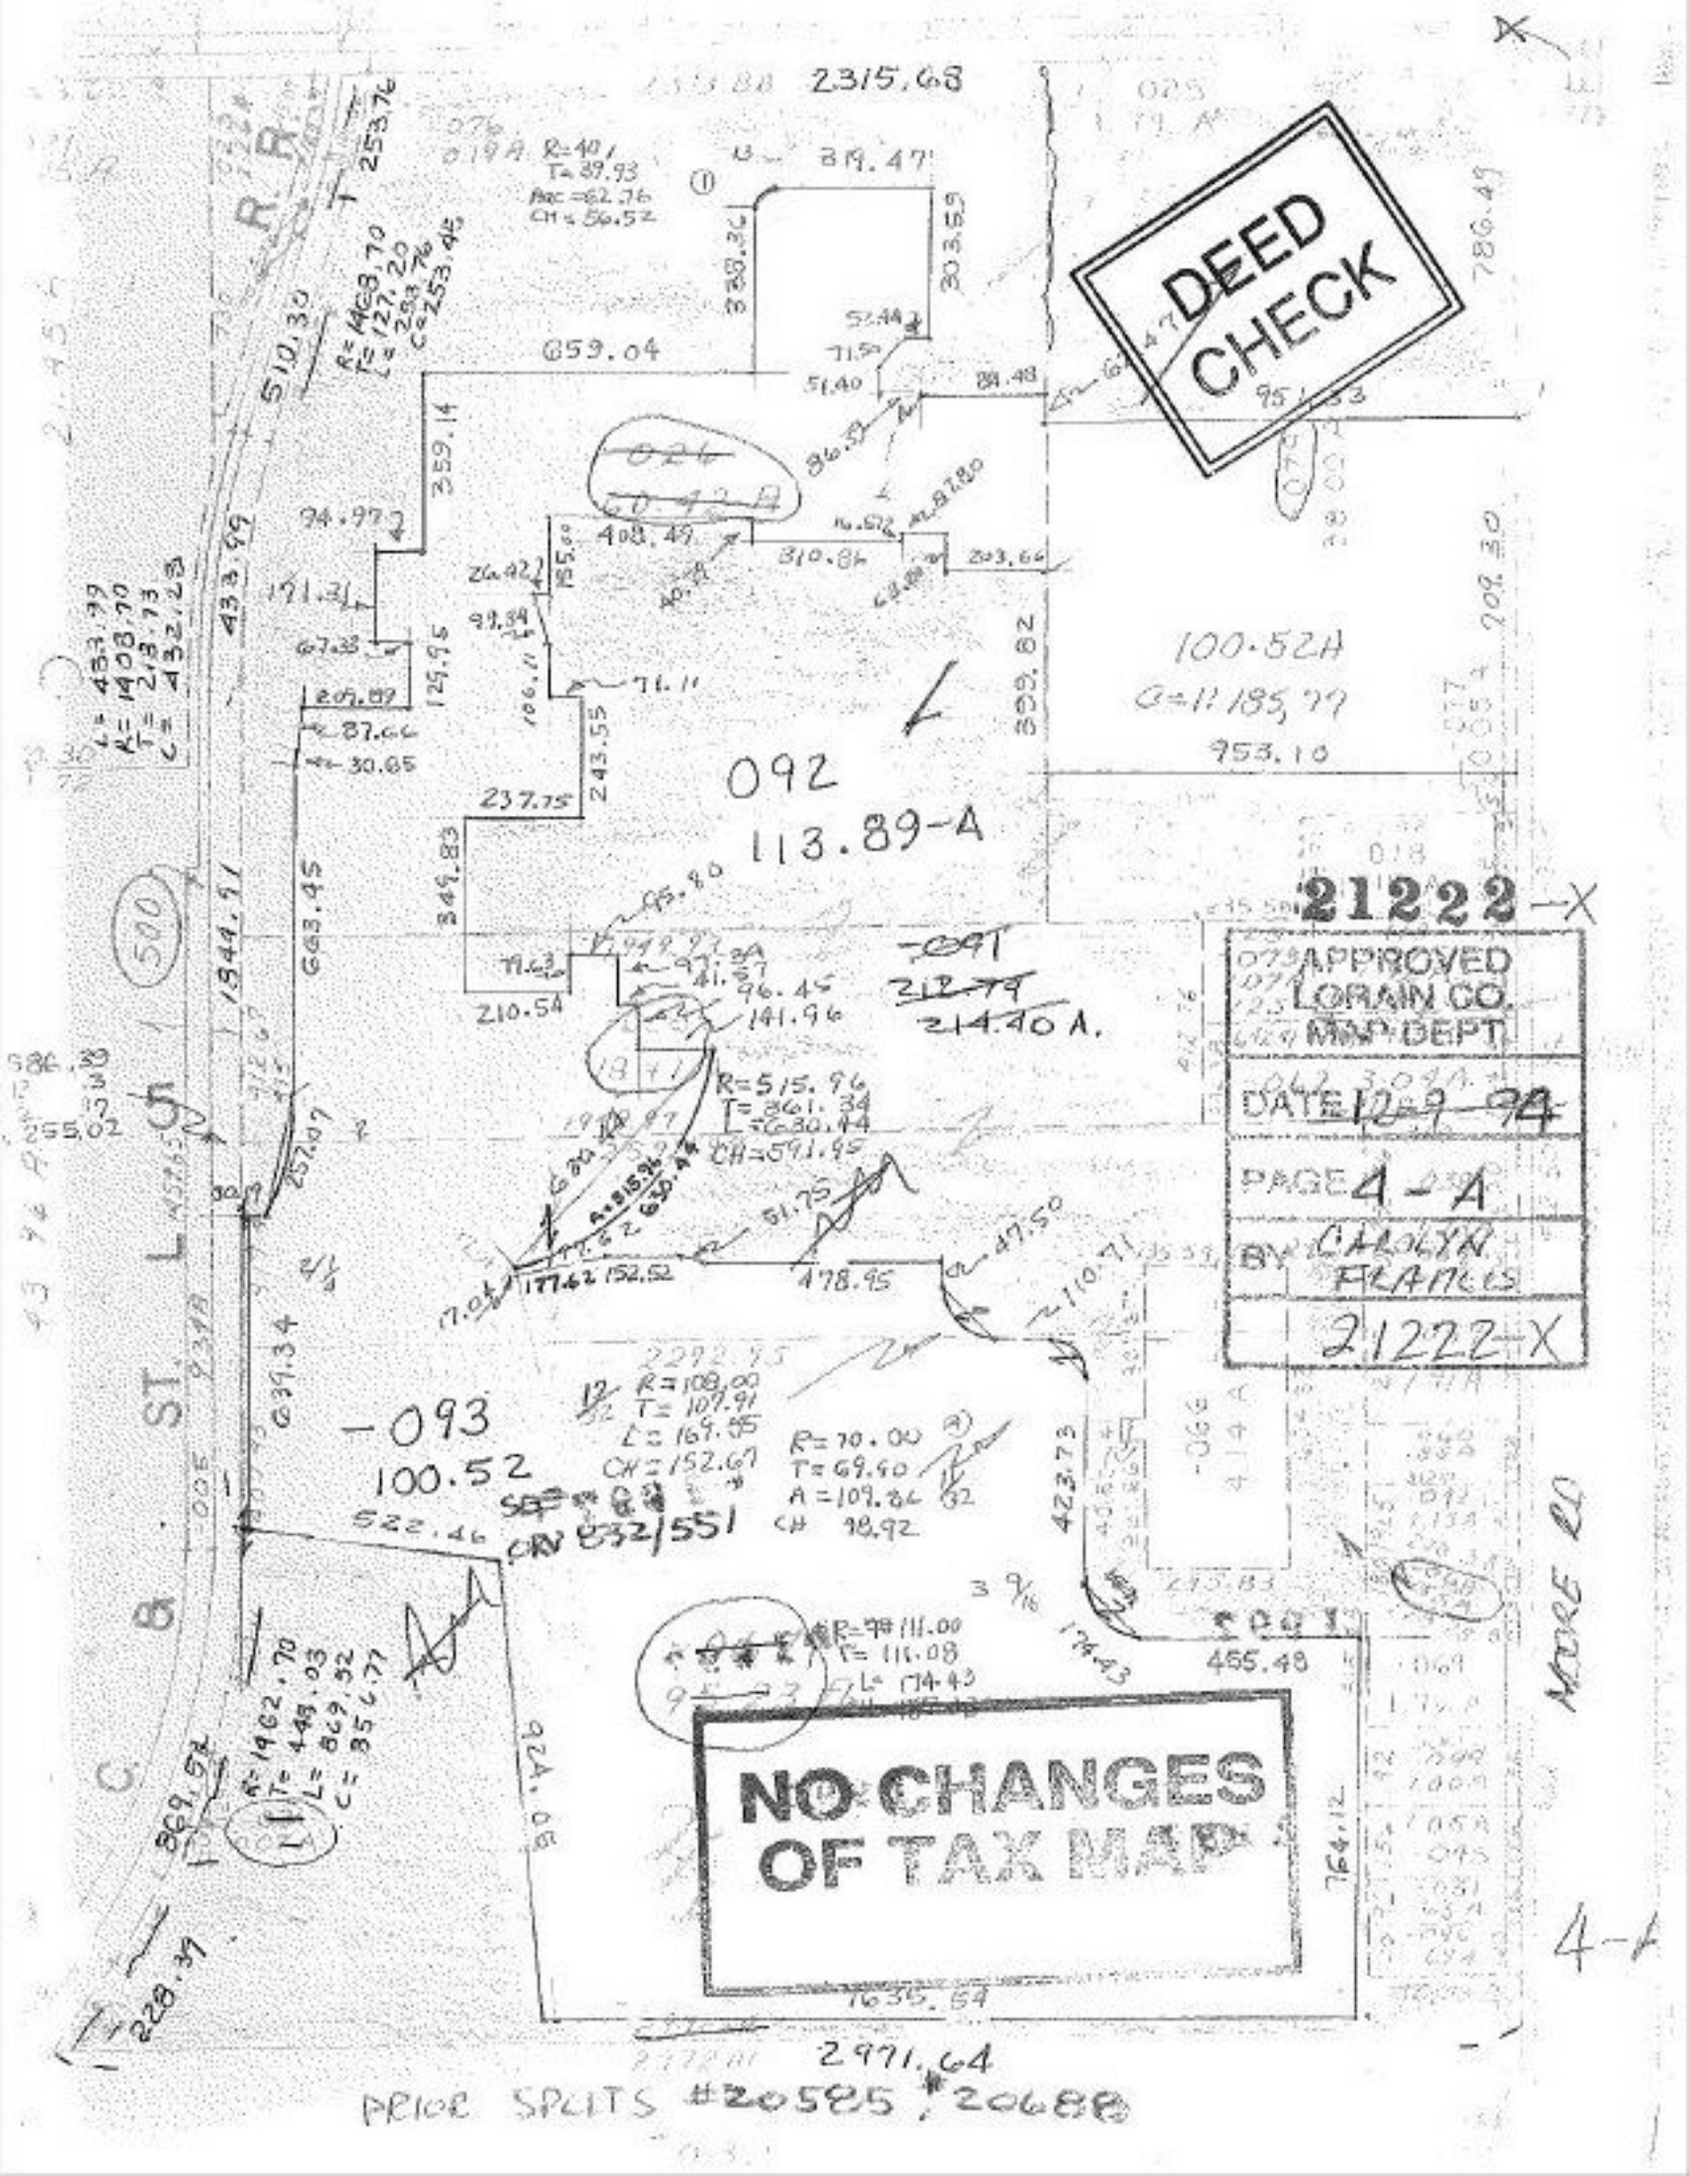

DEED CHECK
21222-X
APPROVED
LORAIN CO.
MAP DEPT.
DATE 12-9-94
PAGE 4-A
BY CAROLYN FRANCIS
21222-X
NO CHANGES OF TAX MAP
092
113.89-A
-093
100.52
100.52A
C=11,185.77
953.10
2315.68
2971.64
MOORE RD
4-A
PRIOR SPLITS #20585, #20688