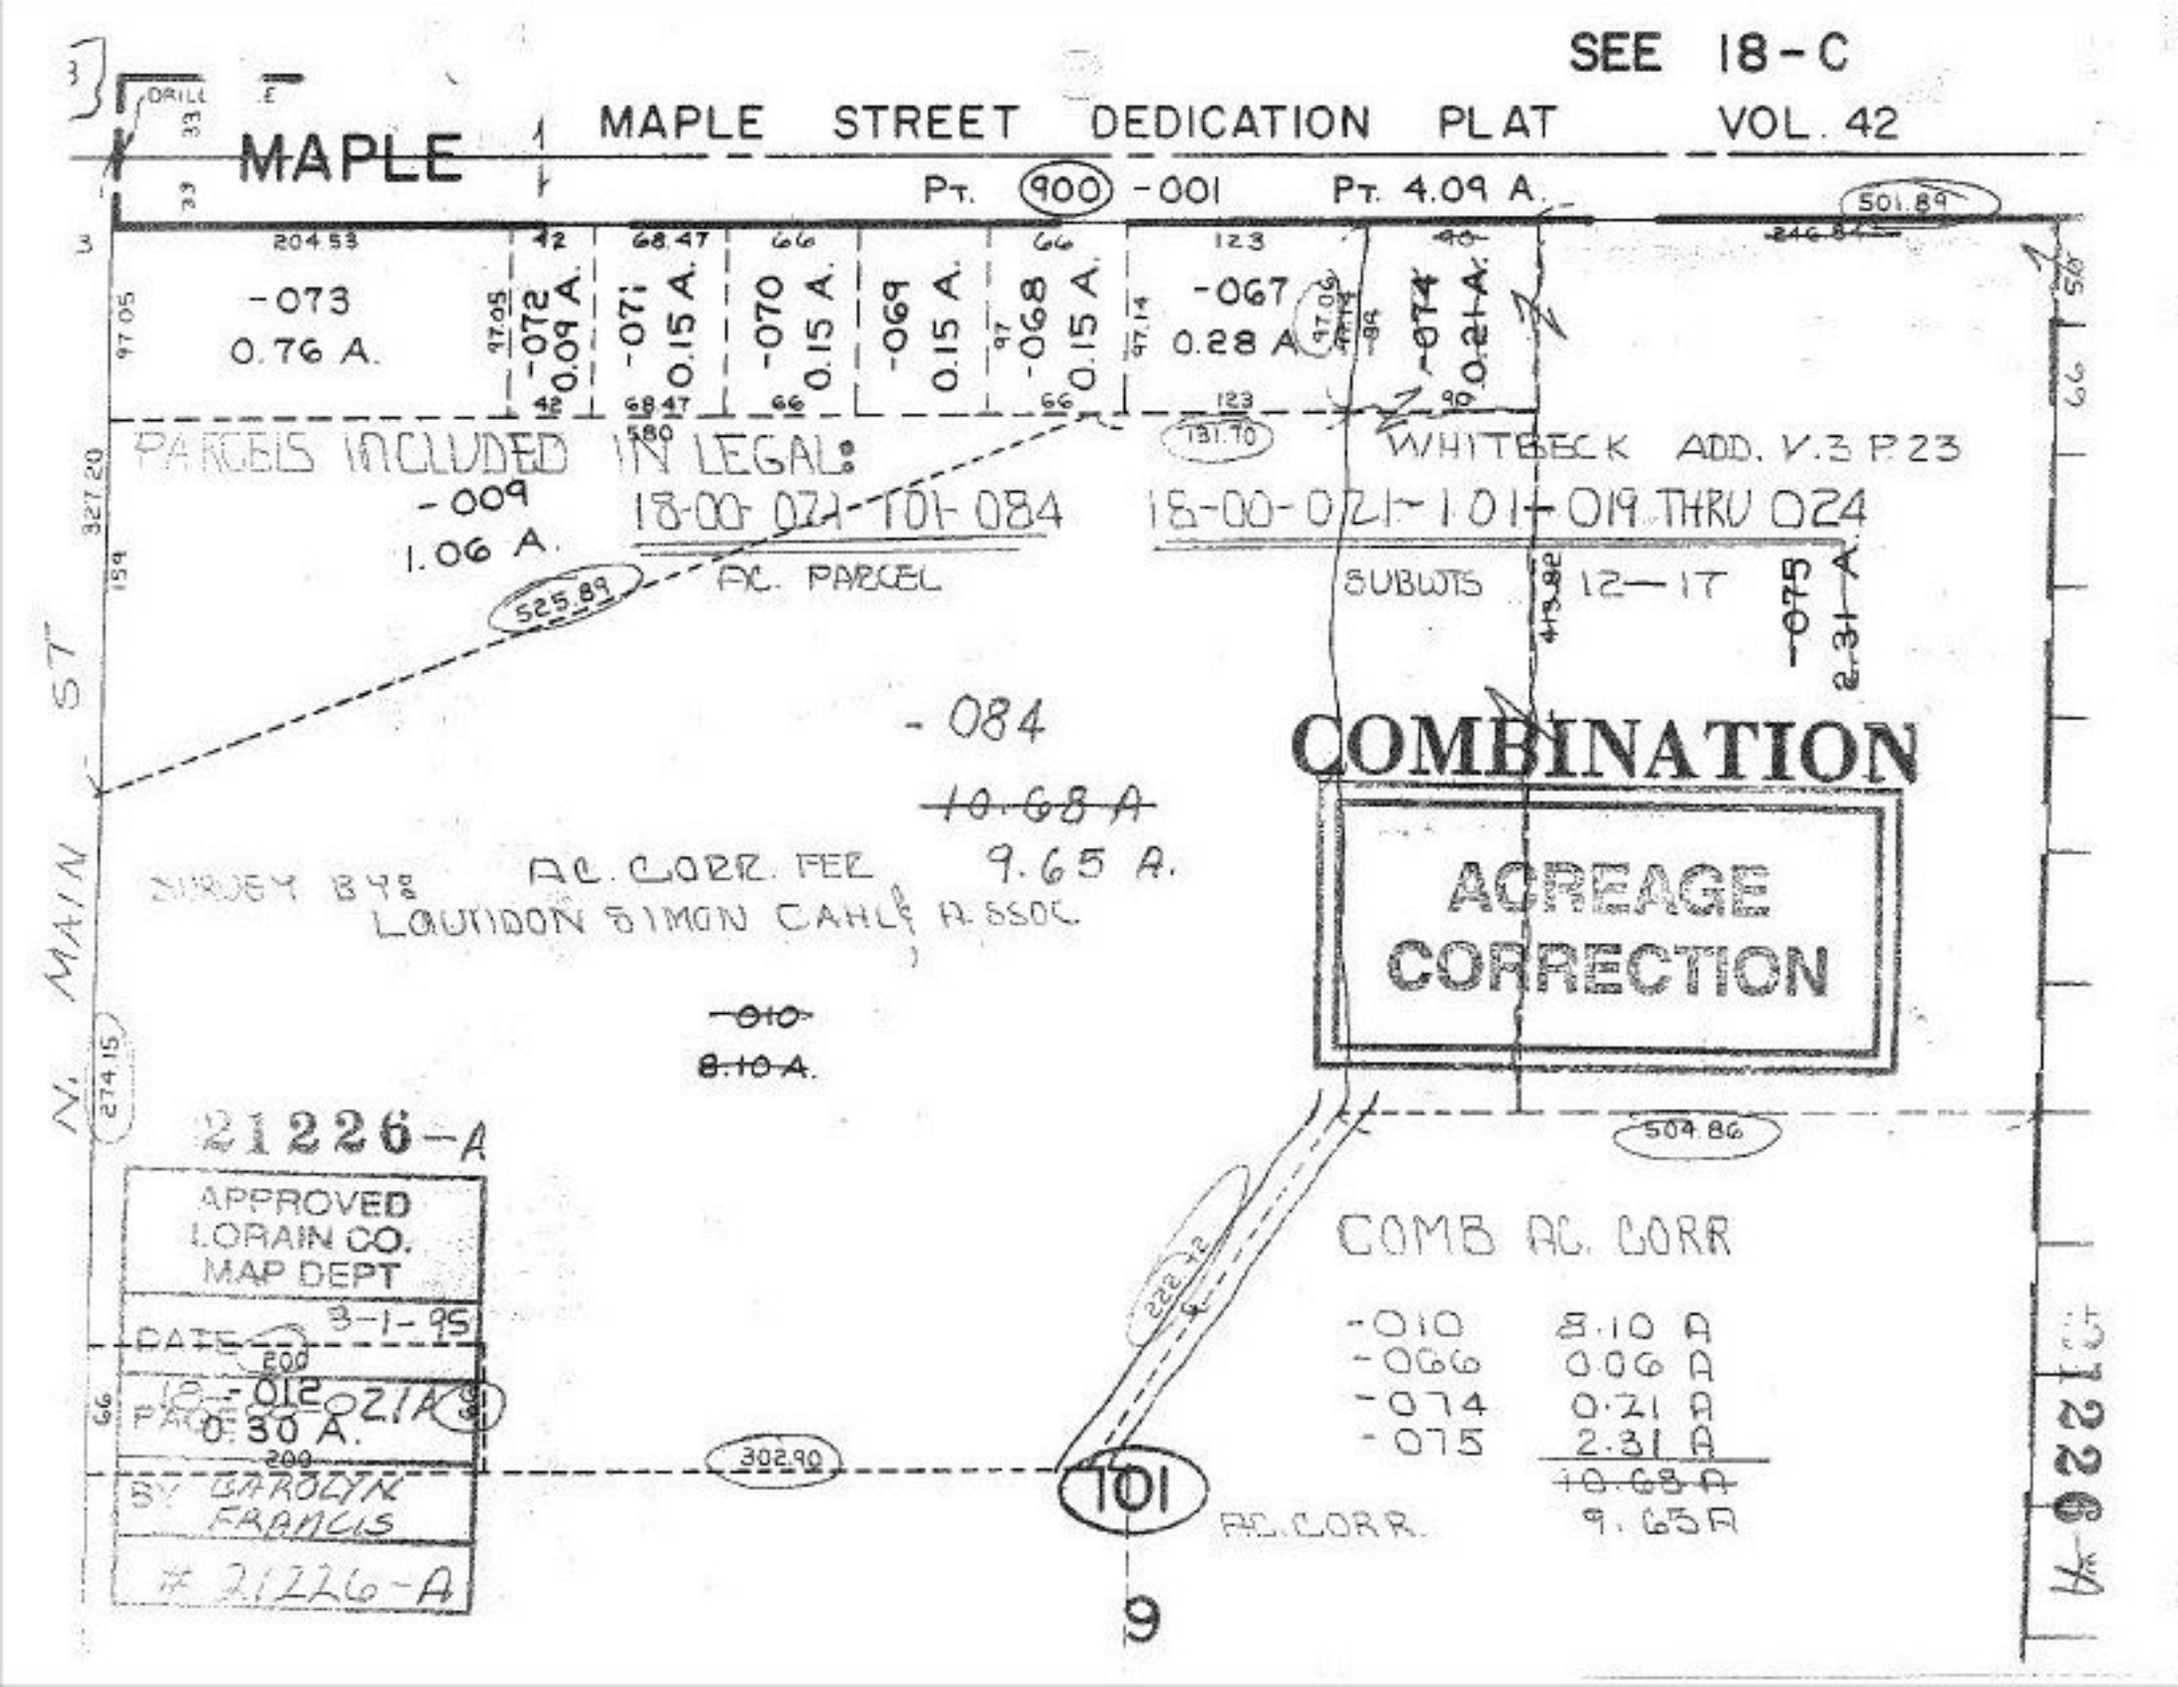
SEE 18-C
MAPLE
MAPLE STREET DEDICATION PLAT VOL. 42
PT. 900 -001 PT. 4.09 A.
501.89
204.53
-073
0.76 A.
-072
0.09 A.
-071
0.15 A.
-070
0.15 A.
-069
0.15 A.
-068
0.15 A.
-067
0.28 A.
-074
0.21 A.
PARCELS INCLUDED IN LEGAL:
-009
1.06 A.
18-00-021-101-084
AC. PARCEL
WHITBECK ADD. V.3 P.23
18-00-021-101-019 THRU 024
SUBWTS 12-17
-075
2.31 A.
525.89
131.70
-084
~~10.68 A~~
9.65 A.
SURVEY BY: AC. CORR. FER
LAUNDON SIMON CAHL & ASSOC.
~~-010~~
~~8.10 A.~~
COMBINATION
ACREAGE CORRECTION
N. MAIN ST
274.15
504.86
21226-A
APPROVED
LORAIN CO.
MAP DEPT
DATE 3-1-95
18-012-021A
0.30 A.
BY CAROLYN FRANCIS
21226-A
302.90
101
COMB AC. CORR
-010 8.10 A
-066 0.06 A
-074 0.21 A
-075 2.31 A
~~10.68 A~~
AC. CORR. 9.65 A
9
21226-A