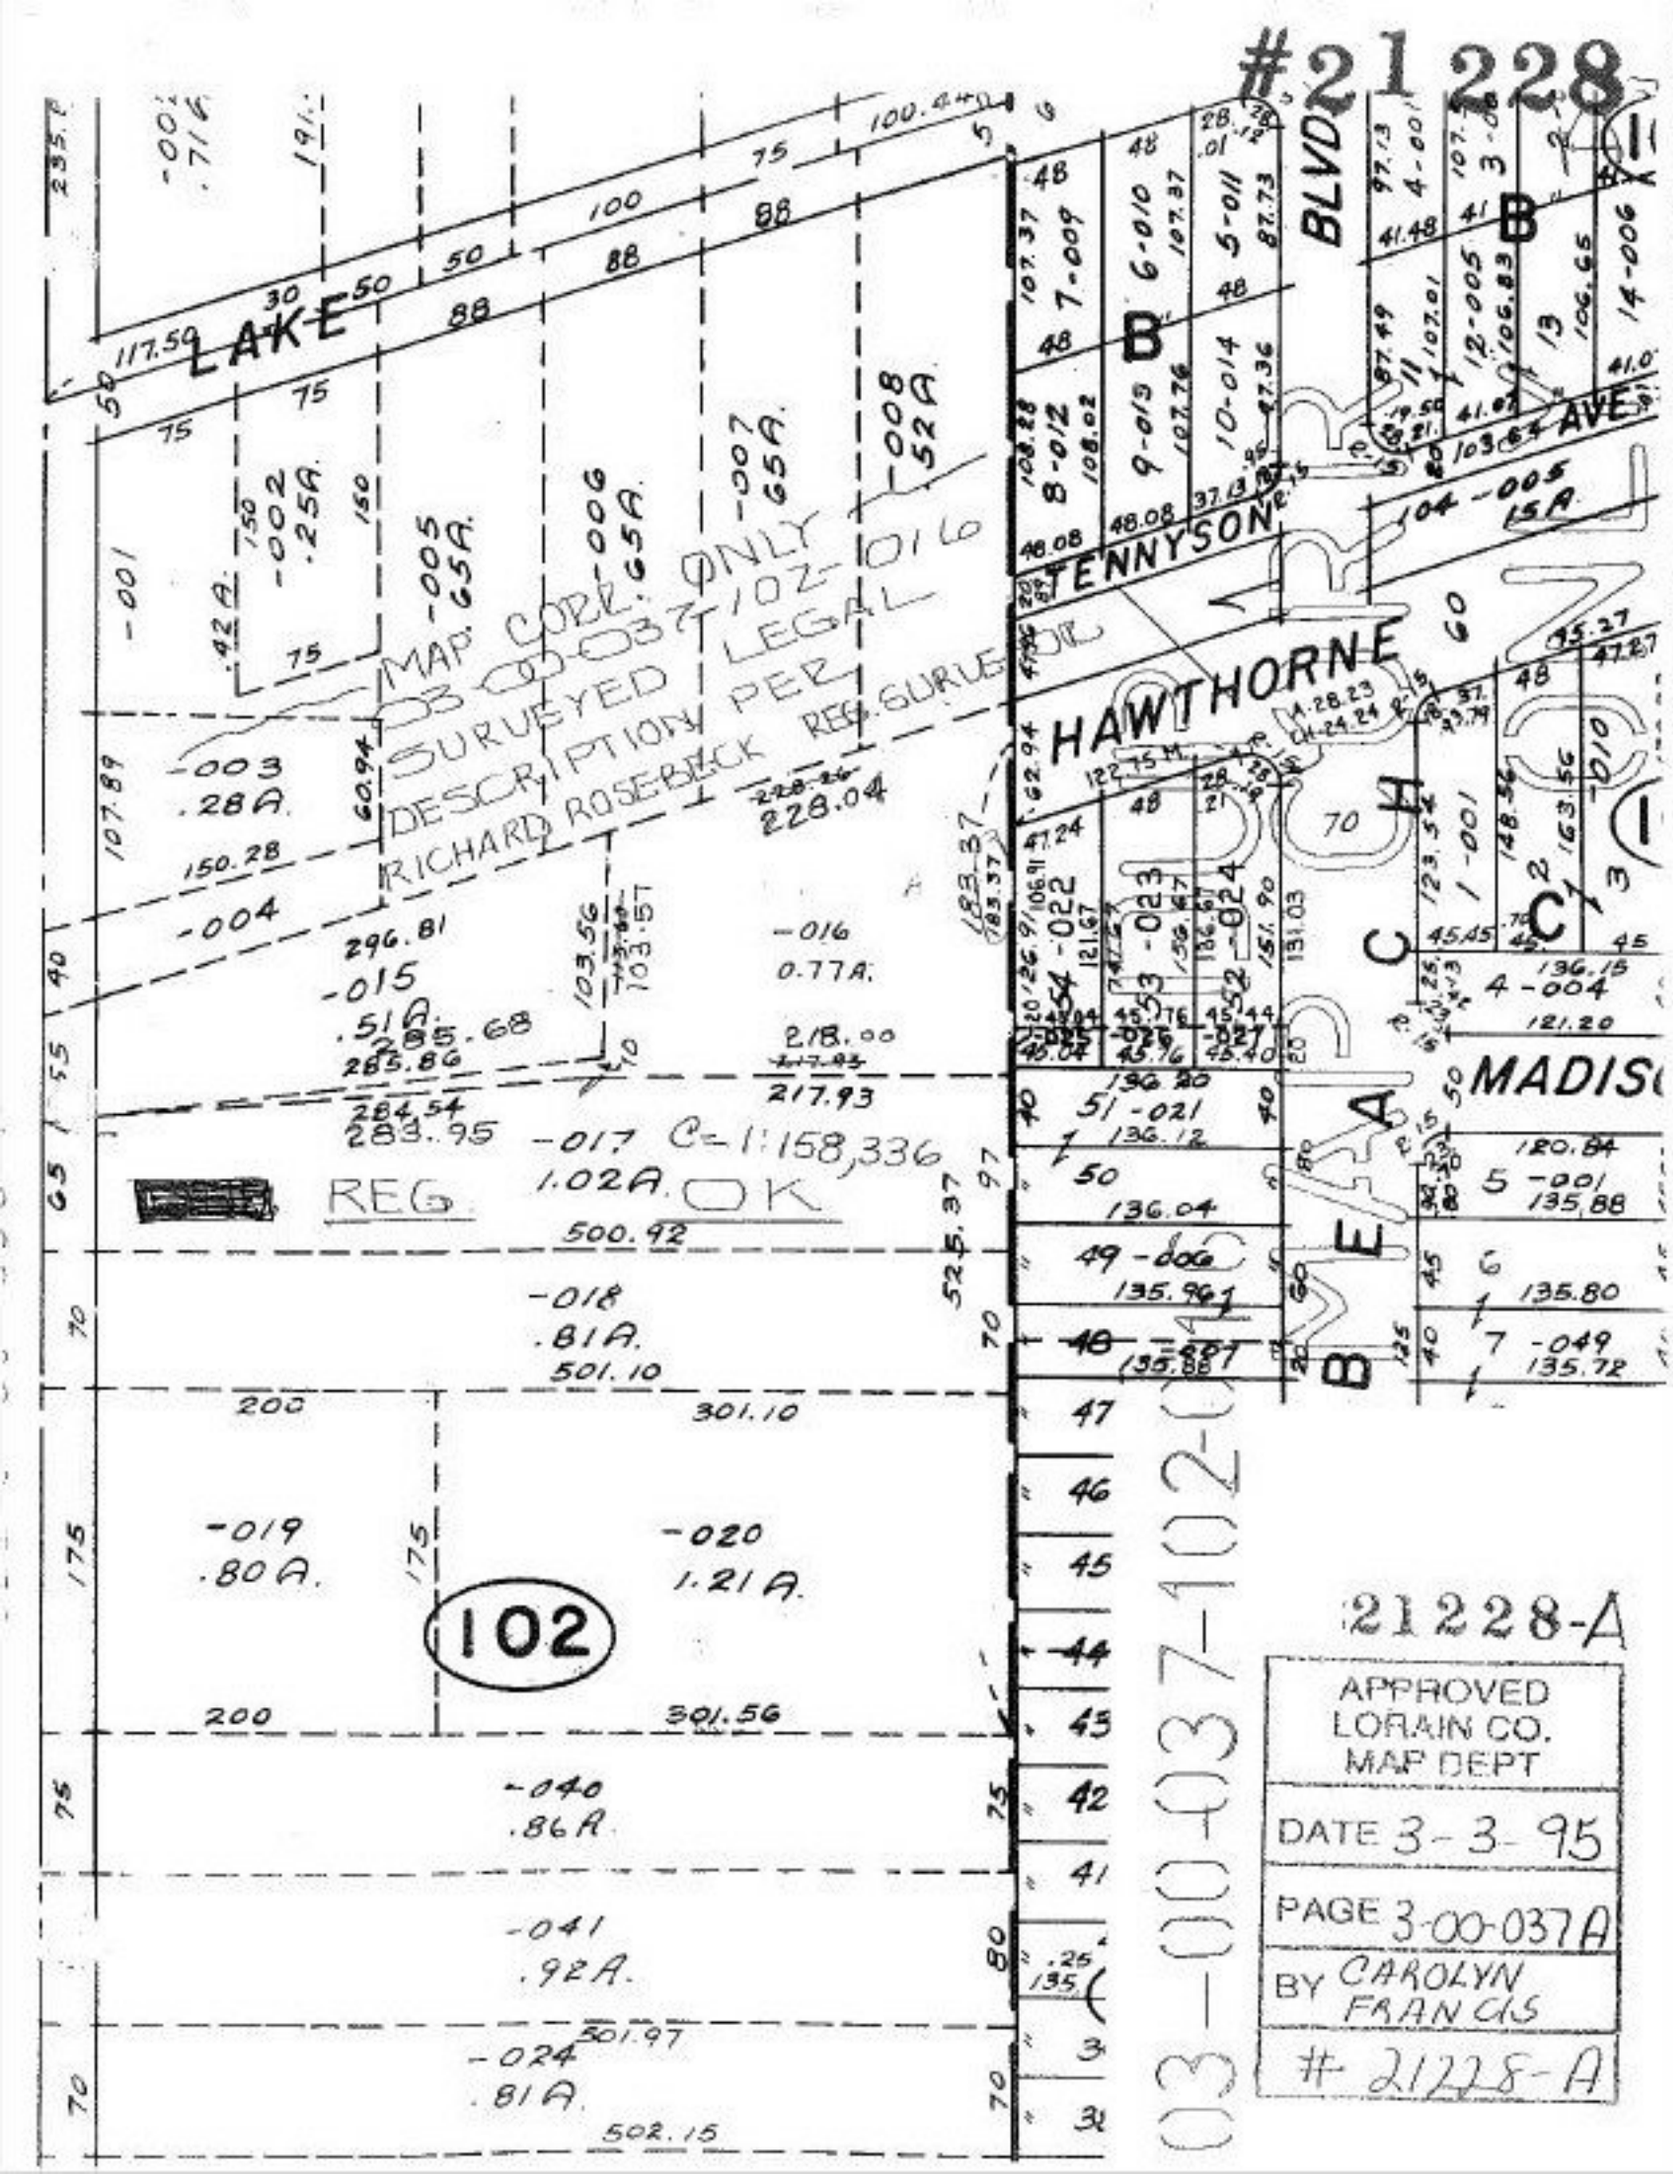
#21228
LAKE
BLVD
TENNYSON
AVE
HAWTHORNE
MADISON
MAP COPY ONLY
03-00-037-102-016
SURVEYED LEGAL
DESCRIPTION PER
RICHARD ROSEBECK REG. SURVEYOR
REG. OK
102
-001 .71A.
-002 .25A.
-003 .28A.
-004
-005 .65A.
-006 .65A.
-007 .65A.
-008 .52A.
-010
-011
-012
-013
-014
-015 .51A.
-016 0.77A.
-017 1.02A.
-018 .81A.
-019 .80A.
-020 1.21A.
-021
-022
-023
-024
-040 .86A.
-041 .92A.
-024 .81A.
C=1:158,336
21228-A
APPROVED
LORAIN CO.
MAP DEPT
DATE 3-3-95
PAGE 3-00-037A
BY CAROLYN
FRANCIS
#21228-A
03-00-037-102-016