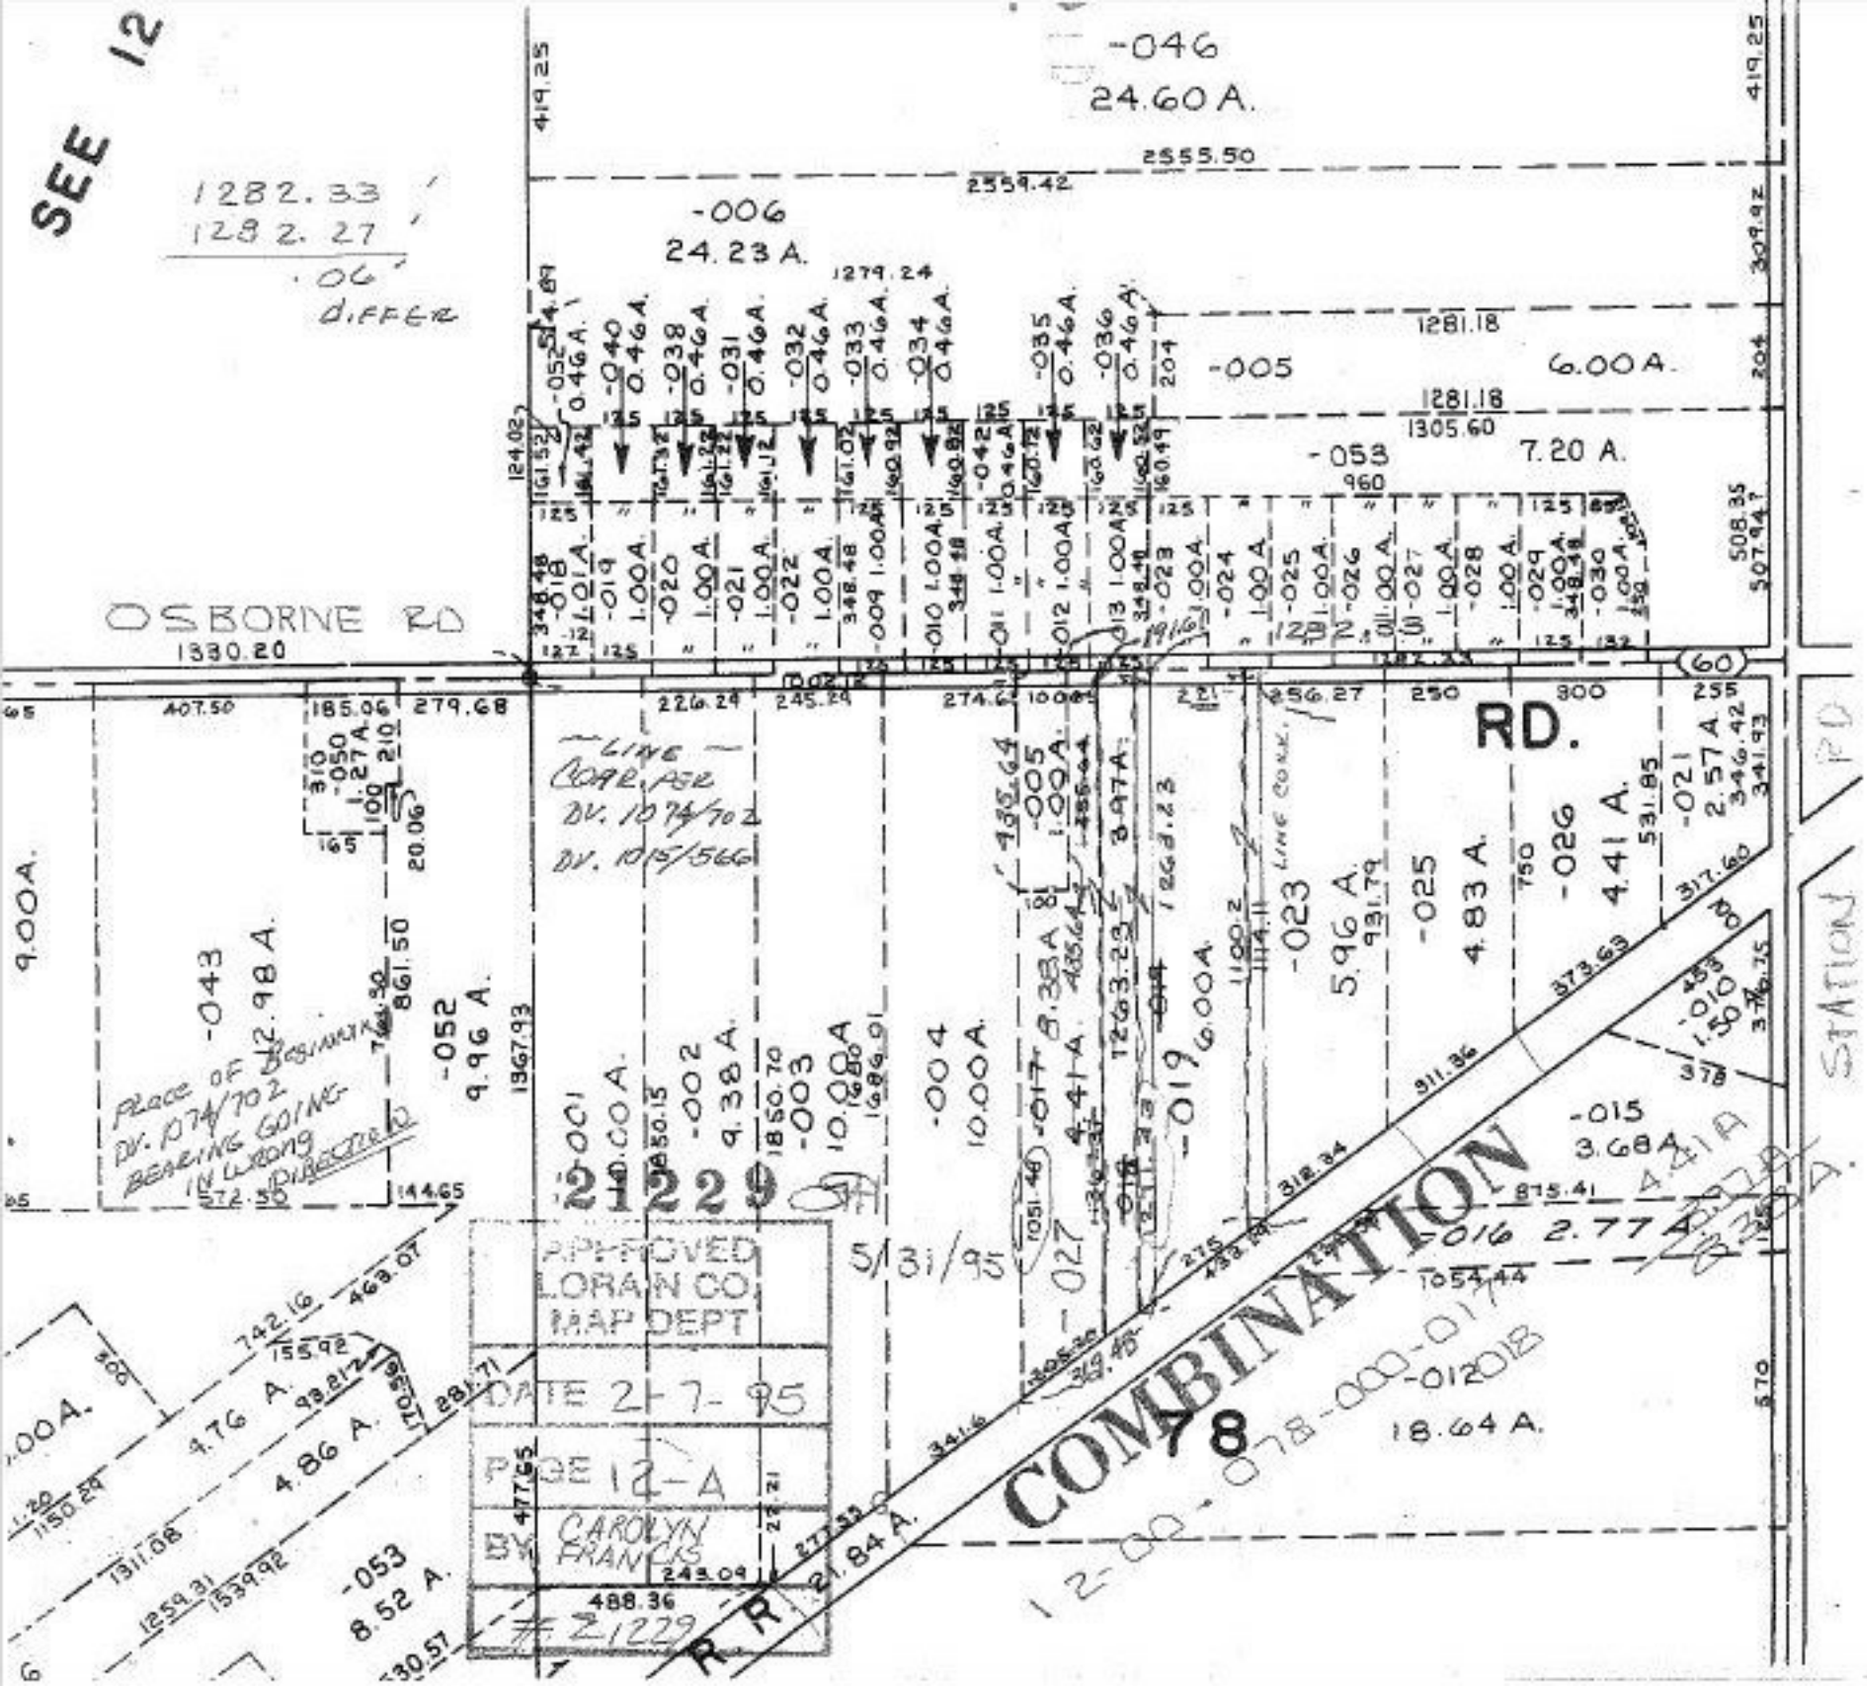
SEE 12
1282.33
1282.27
.06' DIFFER
-046
24.60 A.
419.25
2555.50
2559.42
-006
24.23 A.
1279.24
1281.18
-005
6.00 A.
1281.18
1305.60
-053
7.20 A.
960
OSBORNE RD
1330.20
60
RD.
-043
12.98 A.
-052
9.96 A.
-001
10.00 A.
-002
9.38 A.
-003
10.080 A.
-004
10.00 A.
-005
1.00 A.
-017
8.38 A.
-027
4.41 A.
-019
6.000 A.
-023
5.96 A.
931.79
-025
4.83 A.
-026
4.41 A.
-021
2.57 A.
-010
1.50 A.
-015
3.68 A.
-016
2.77 A.
-012
18.64 A.
-053
8.52 A.
4.76 A.
4.86 A.
COMBINATION
12-00-078-000-017
-012013
R.R.
21.84 A.
STATION RD
APPROVED
LORAIN CO.
MAP DEPT
DATE 2-7-95
PAGE 12-A
BY CAROLYN FRANCIS
21229
5/31/91
PLACE OF BEGINNING
DV. D74/702
BEARING GOING
IN WRONG
DIRECTION
LINE CORR. PER
DV. D74/702
DV. D15/566
LINE CONT.