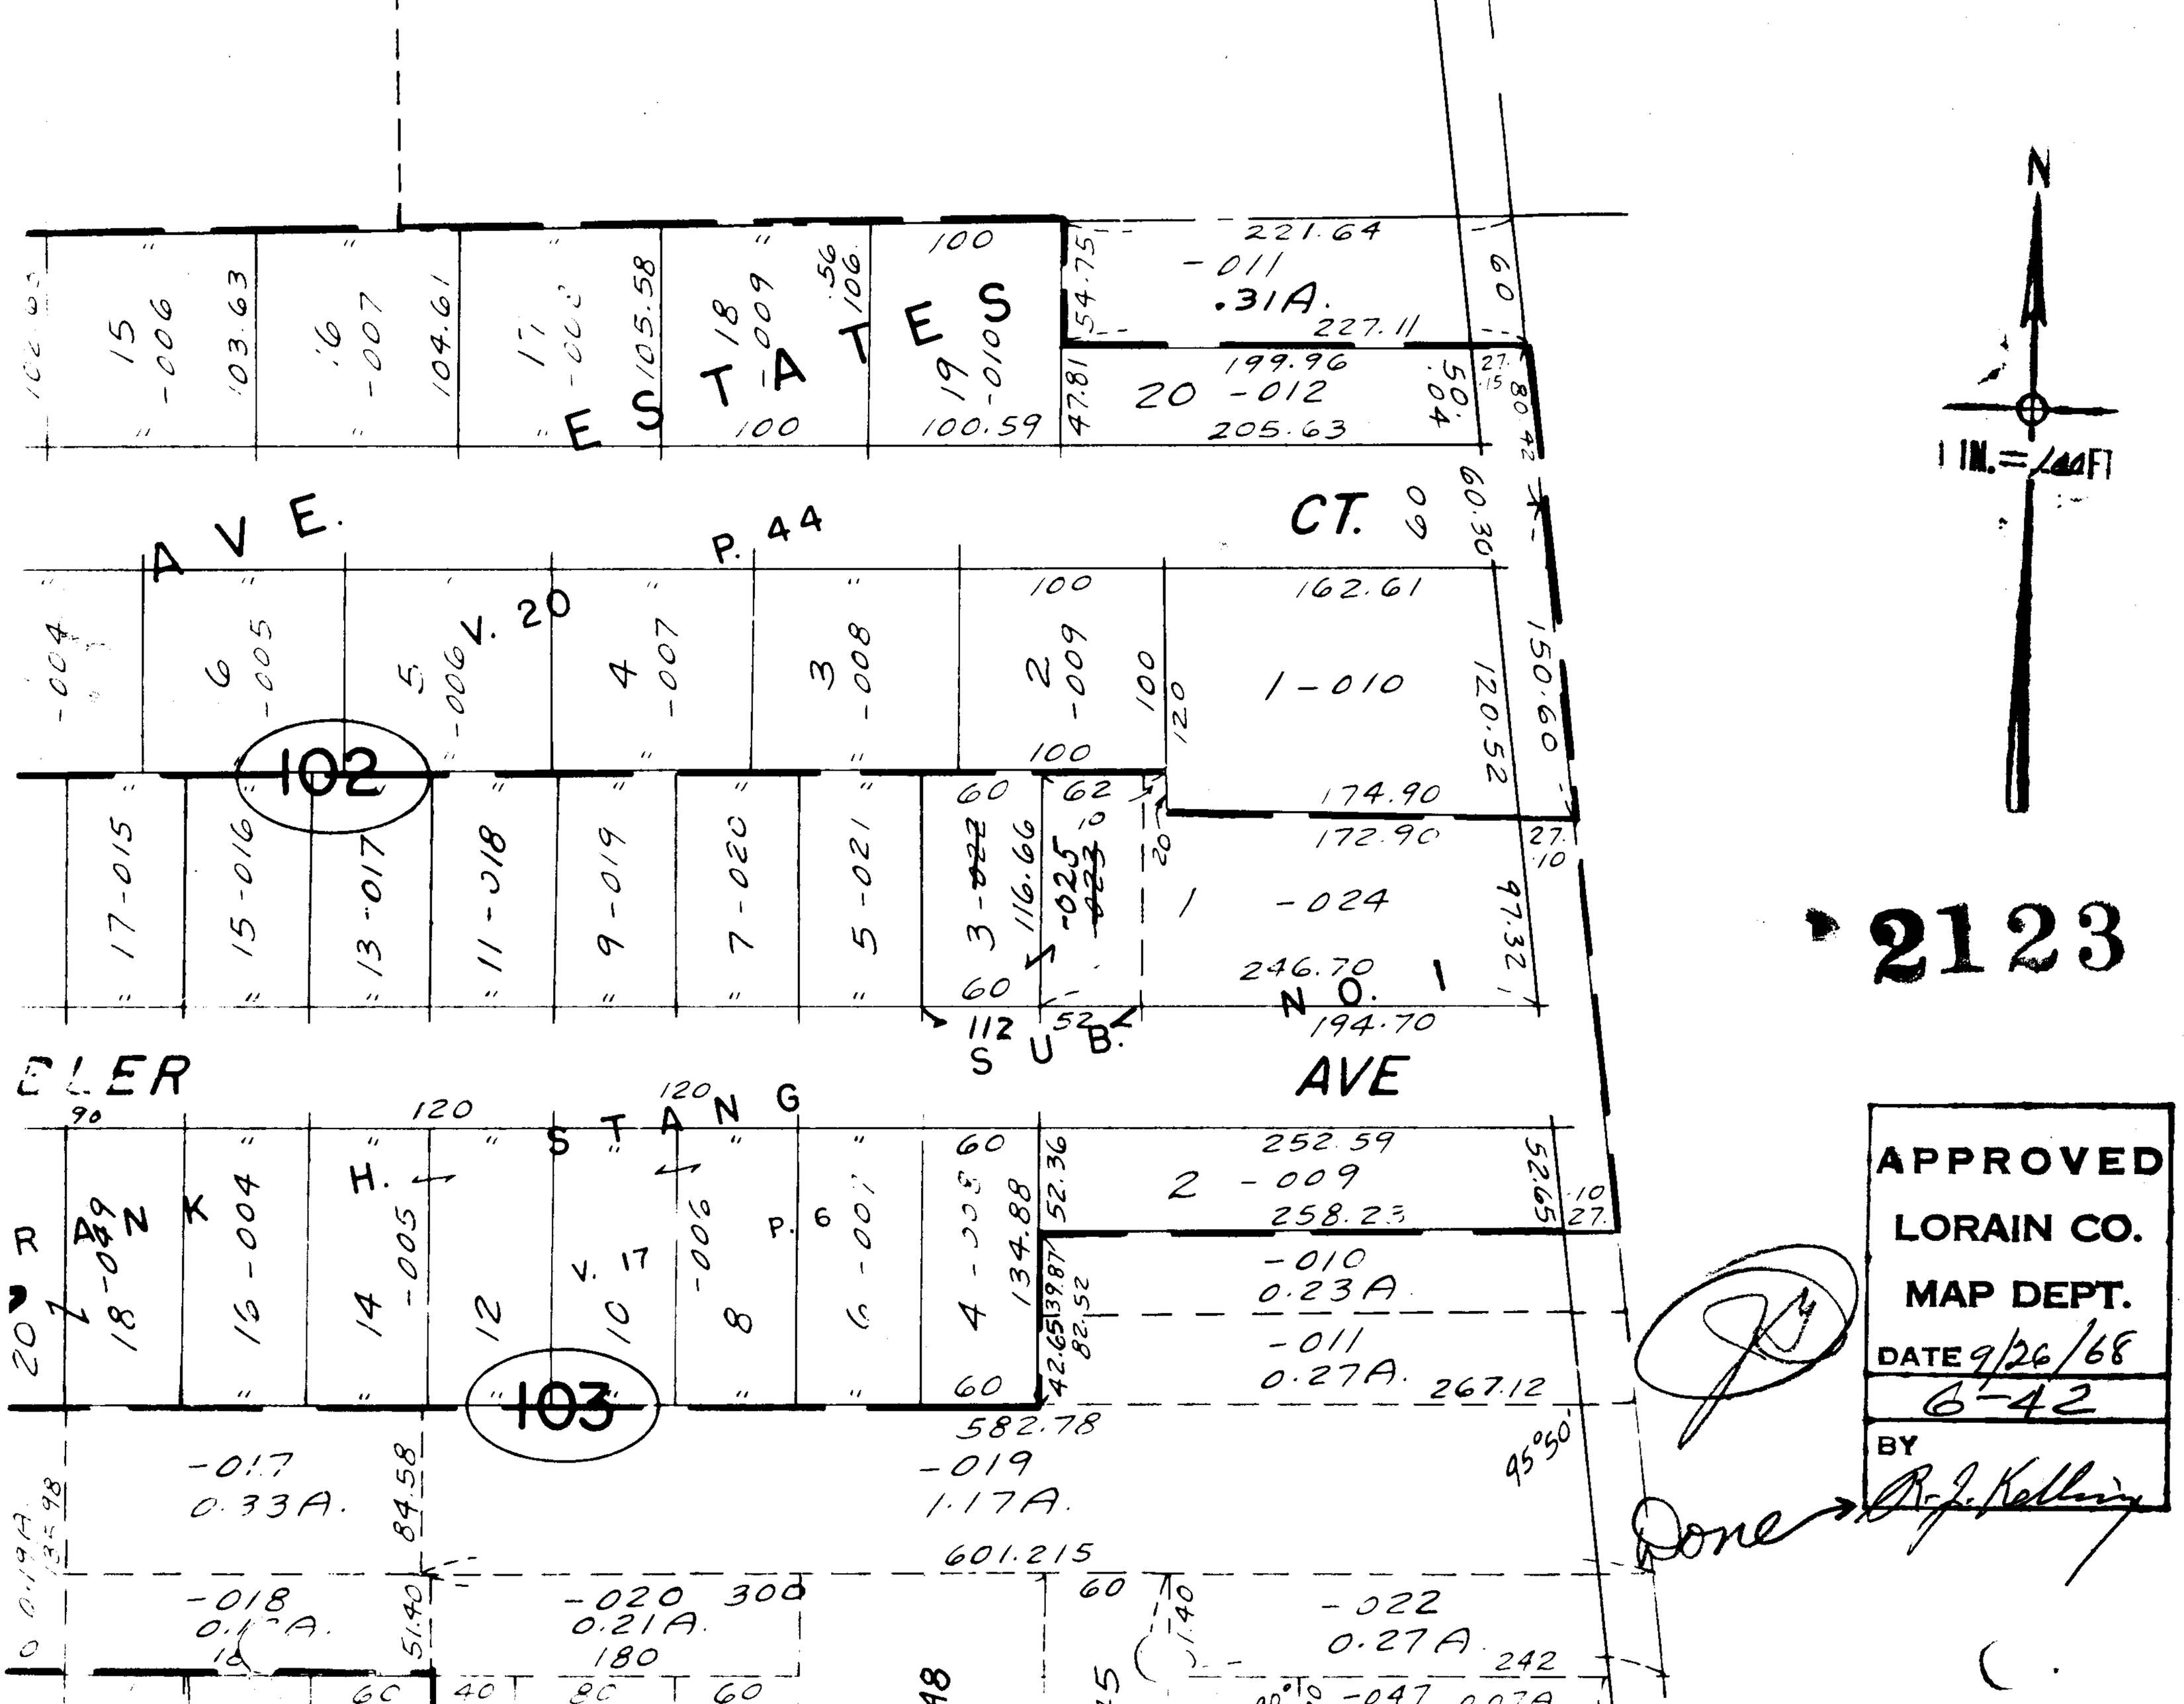

ESTATES
AVE.
CT.
P. 44
V. 20
102
103
NO. 1
SUB.
AVE
STANG
RANK
H.
V. 17
P. 6
221.64
-011
.31A.
227.11
199.96
20 -012
205.63
162.61
1-010
174.90
172.90
1 -024
246.70
194.70
252.59
2 -009
258.23
-010
0.23A
-011
0.27A.
267.12
582.78
-019
1.17A.
601.215
-017
0.33A.
-018
-020
0.21A.
-022
0.27A
242
-047
N
1 IN. = 400 FT
2123
APPROVED
LORAIN CO.
MAP DEPT.
DATE 9/26/68
6-42
BY
Done