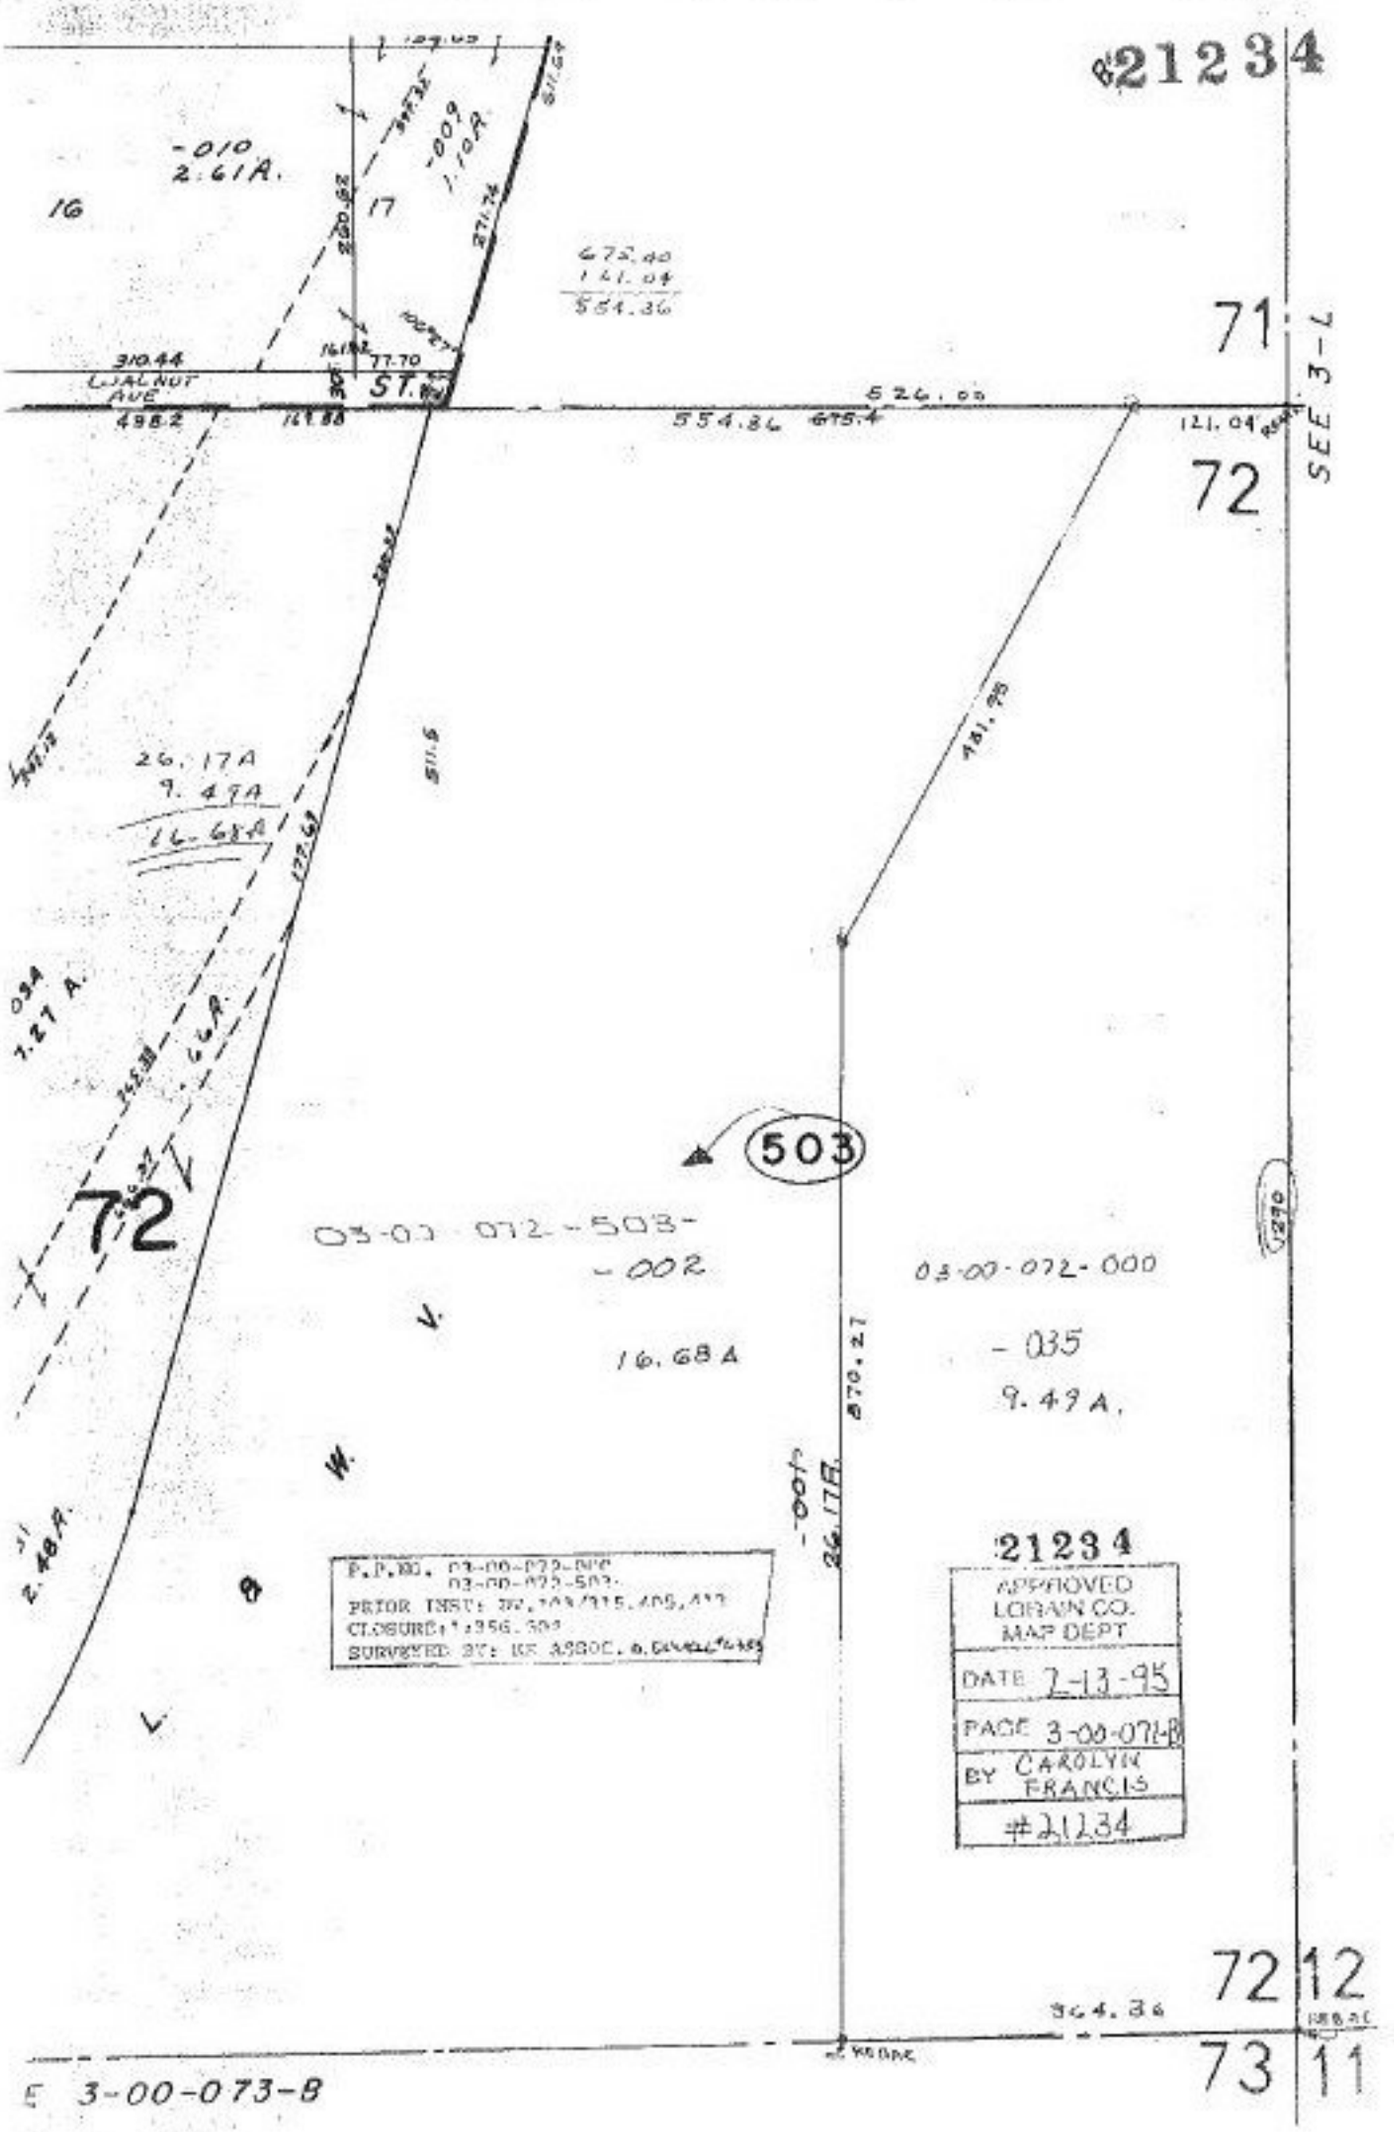
#21234
-010
2.61A.
16
17
-009
1.10A.
672.40
141.04
554.36
71
310.44
WALNUT AVE
498.2
ST.
526.00
554.36
675.4
141.04
SEE 3-L
72
481.98
26.17A
9.49A
16.68A
511.6
034
7.27 A.
.66A.
72
03-00-072-503-002
16.68 A
03-00-072-000-035
9.49 A.
870.27
-001-
26.17B
2.48A.
P.P.NO. 03-00-072-000
03-00-072-503
PRIOR INST: 92,
CLOSURE:
SURVEYED BY:
#21234
APPROVED
LORAIN CO.
MAP DEPT
DATE 7-13-95
PAGE 3-00-072-B
BY CAROLYN FRANCIS
#21234
72
12
364.36
73
11
E 3-00-073-B