21236
PT. - 029
PT. 36.18 A.

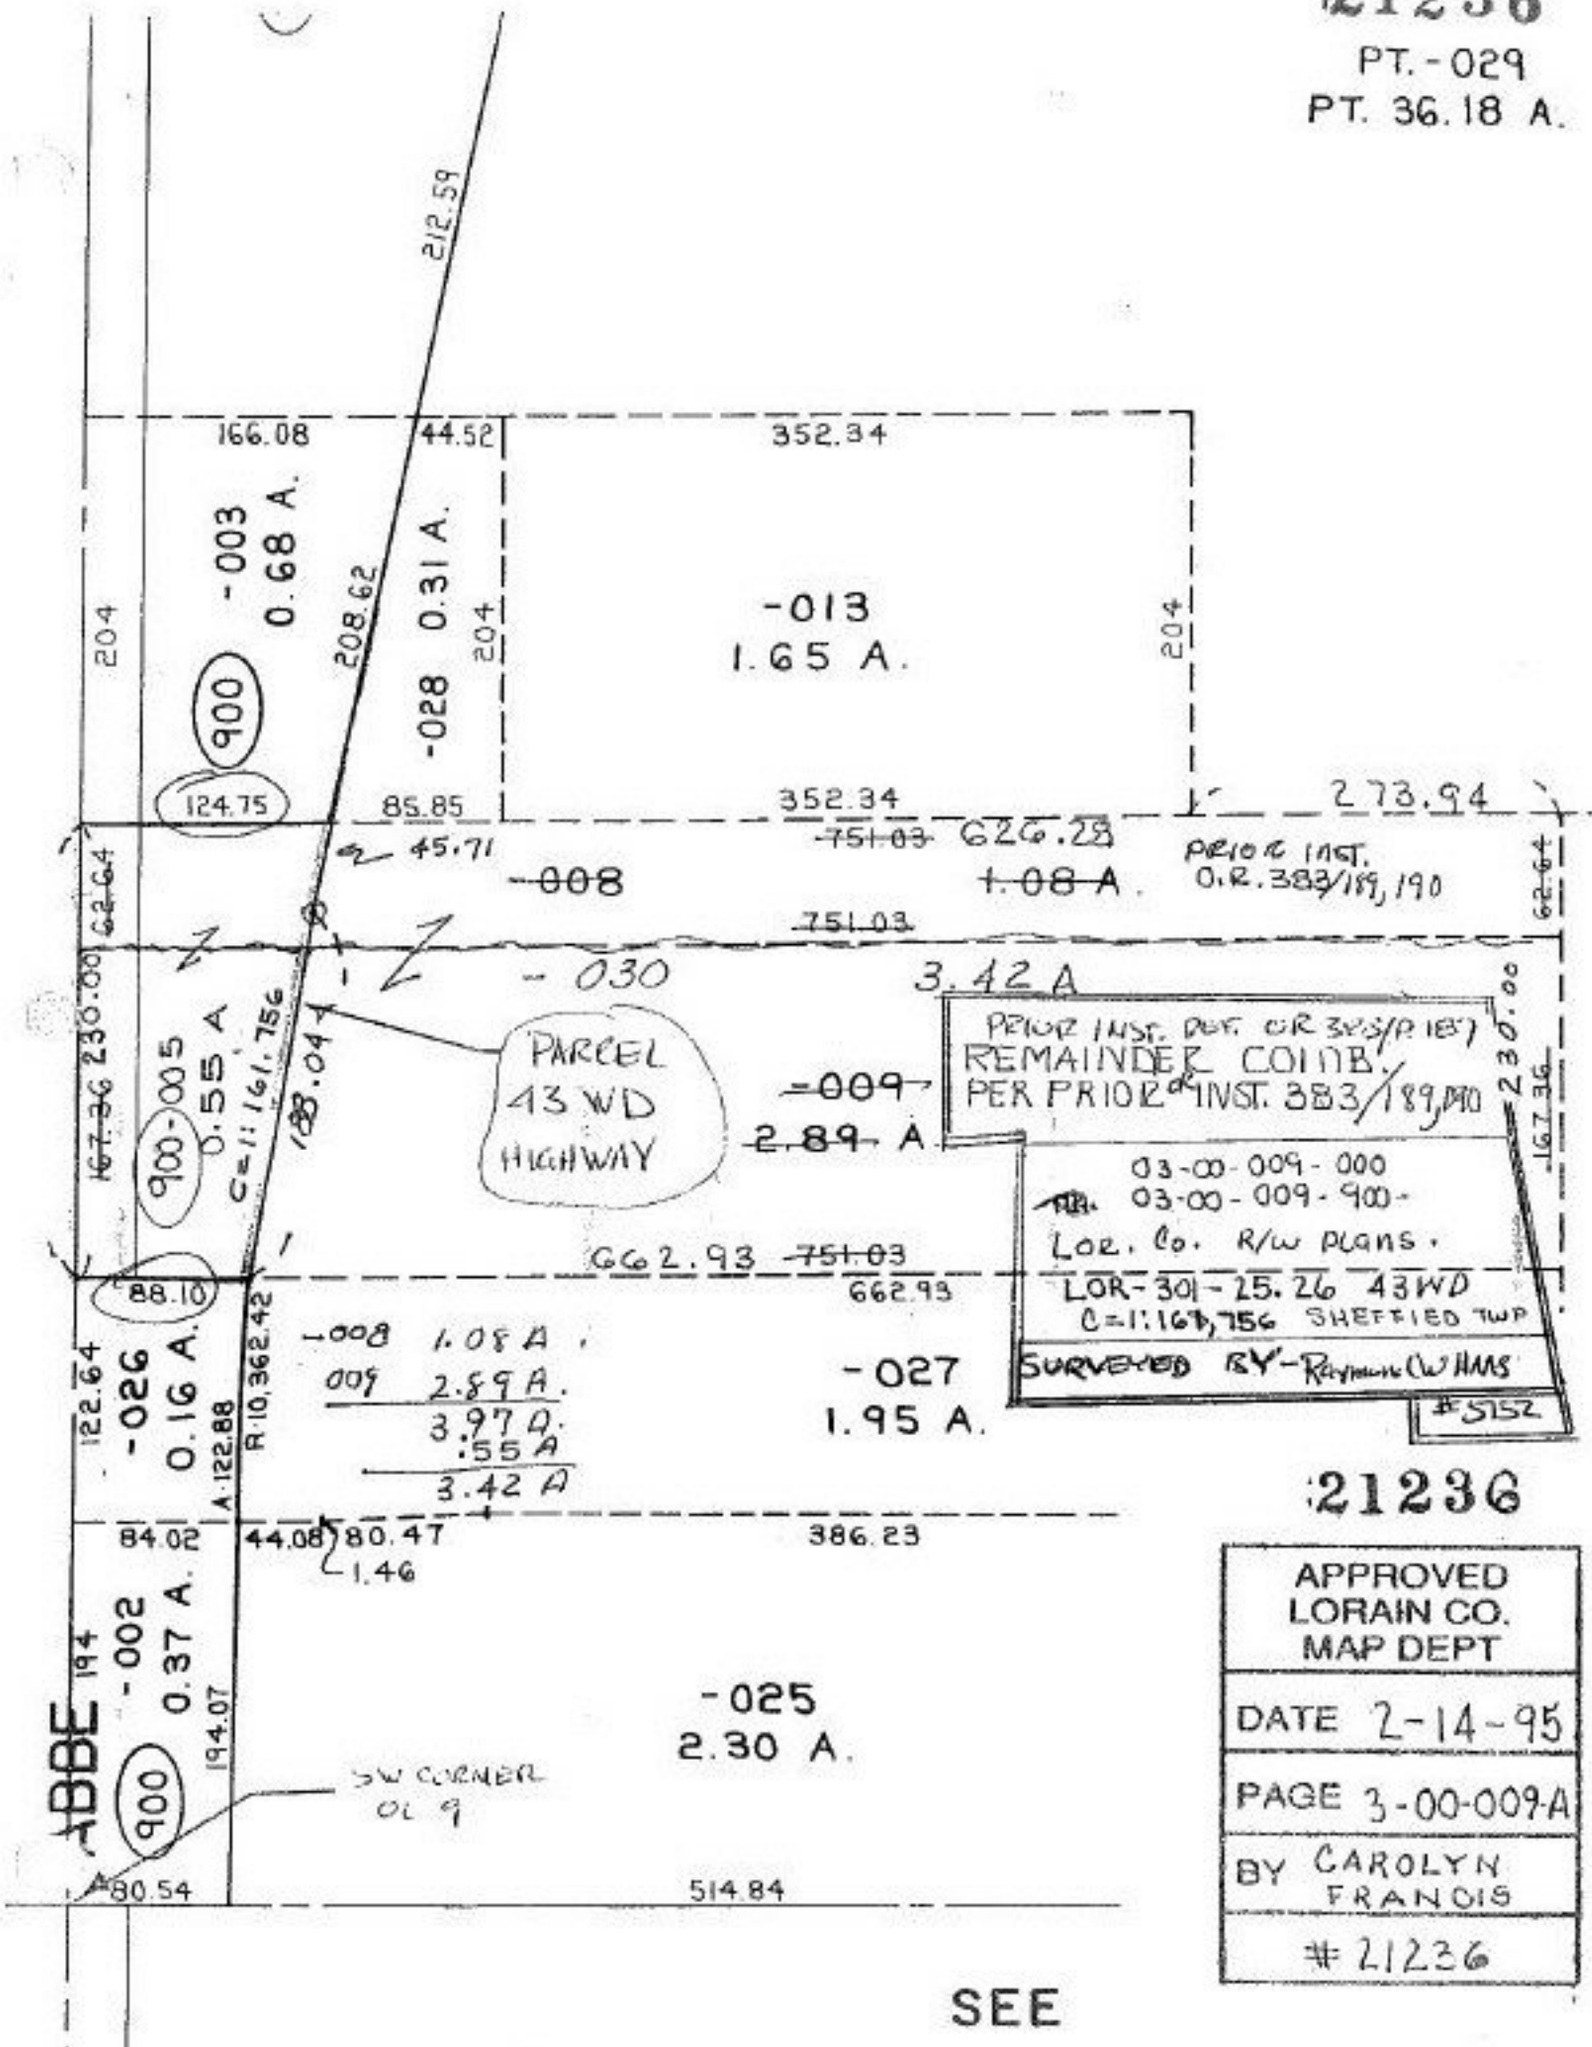

21236

APPROVED LORAIN CO. MAP DEPT
DATE 2-14-95
PAGE 3-00-009-A
BY CAROLYN FRANCIS
21236