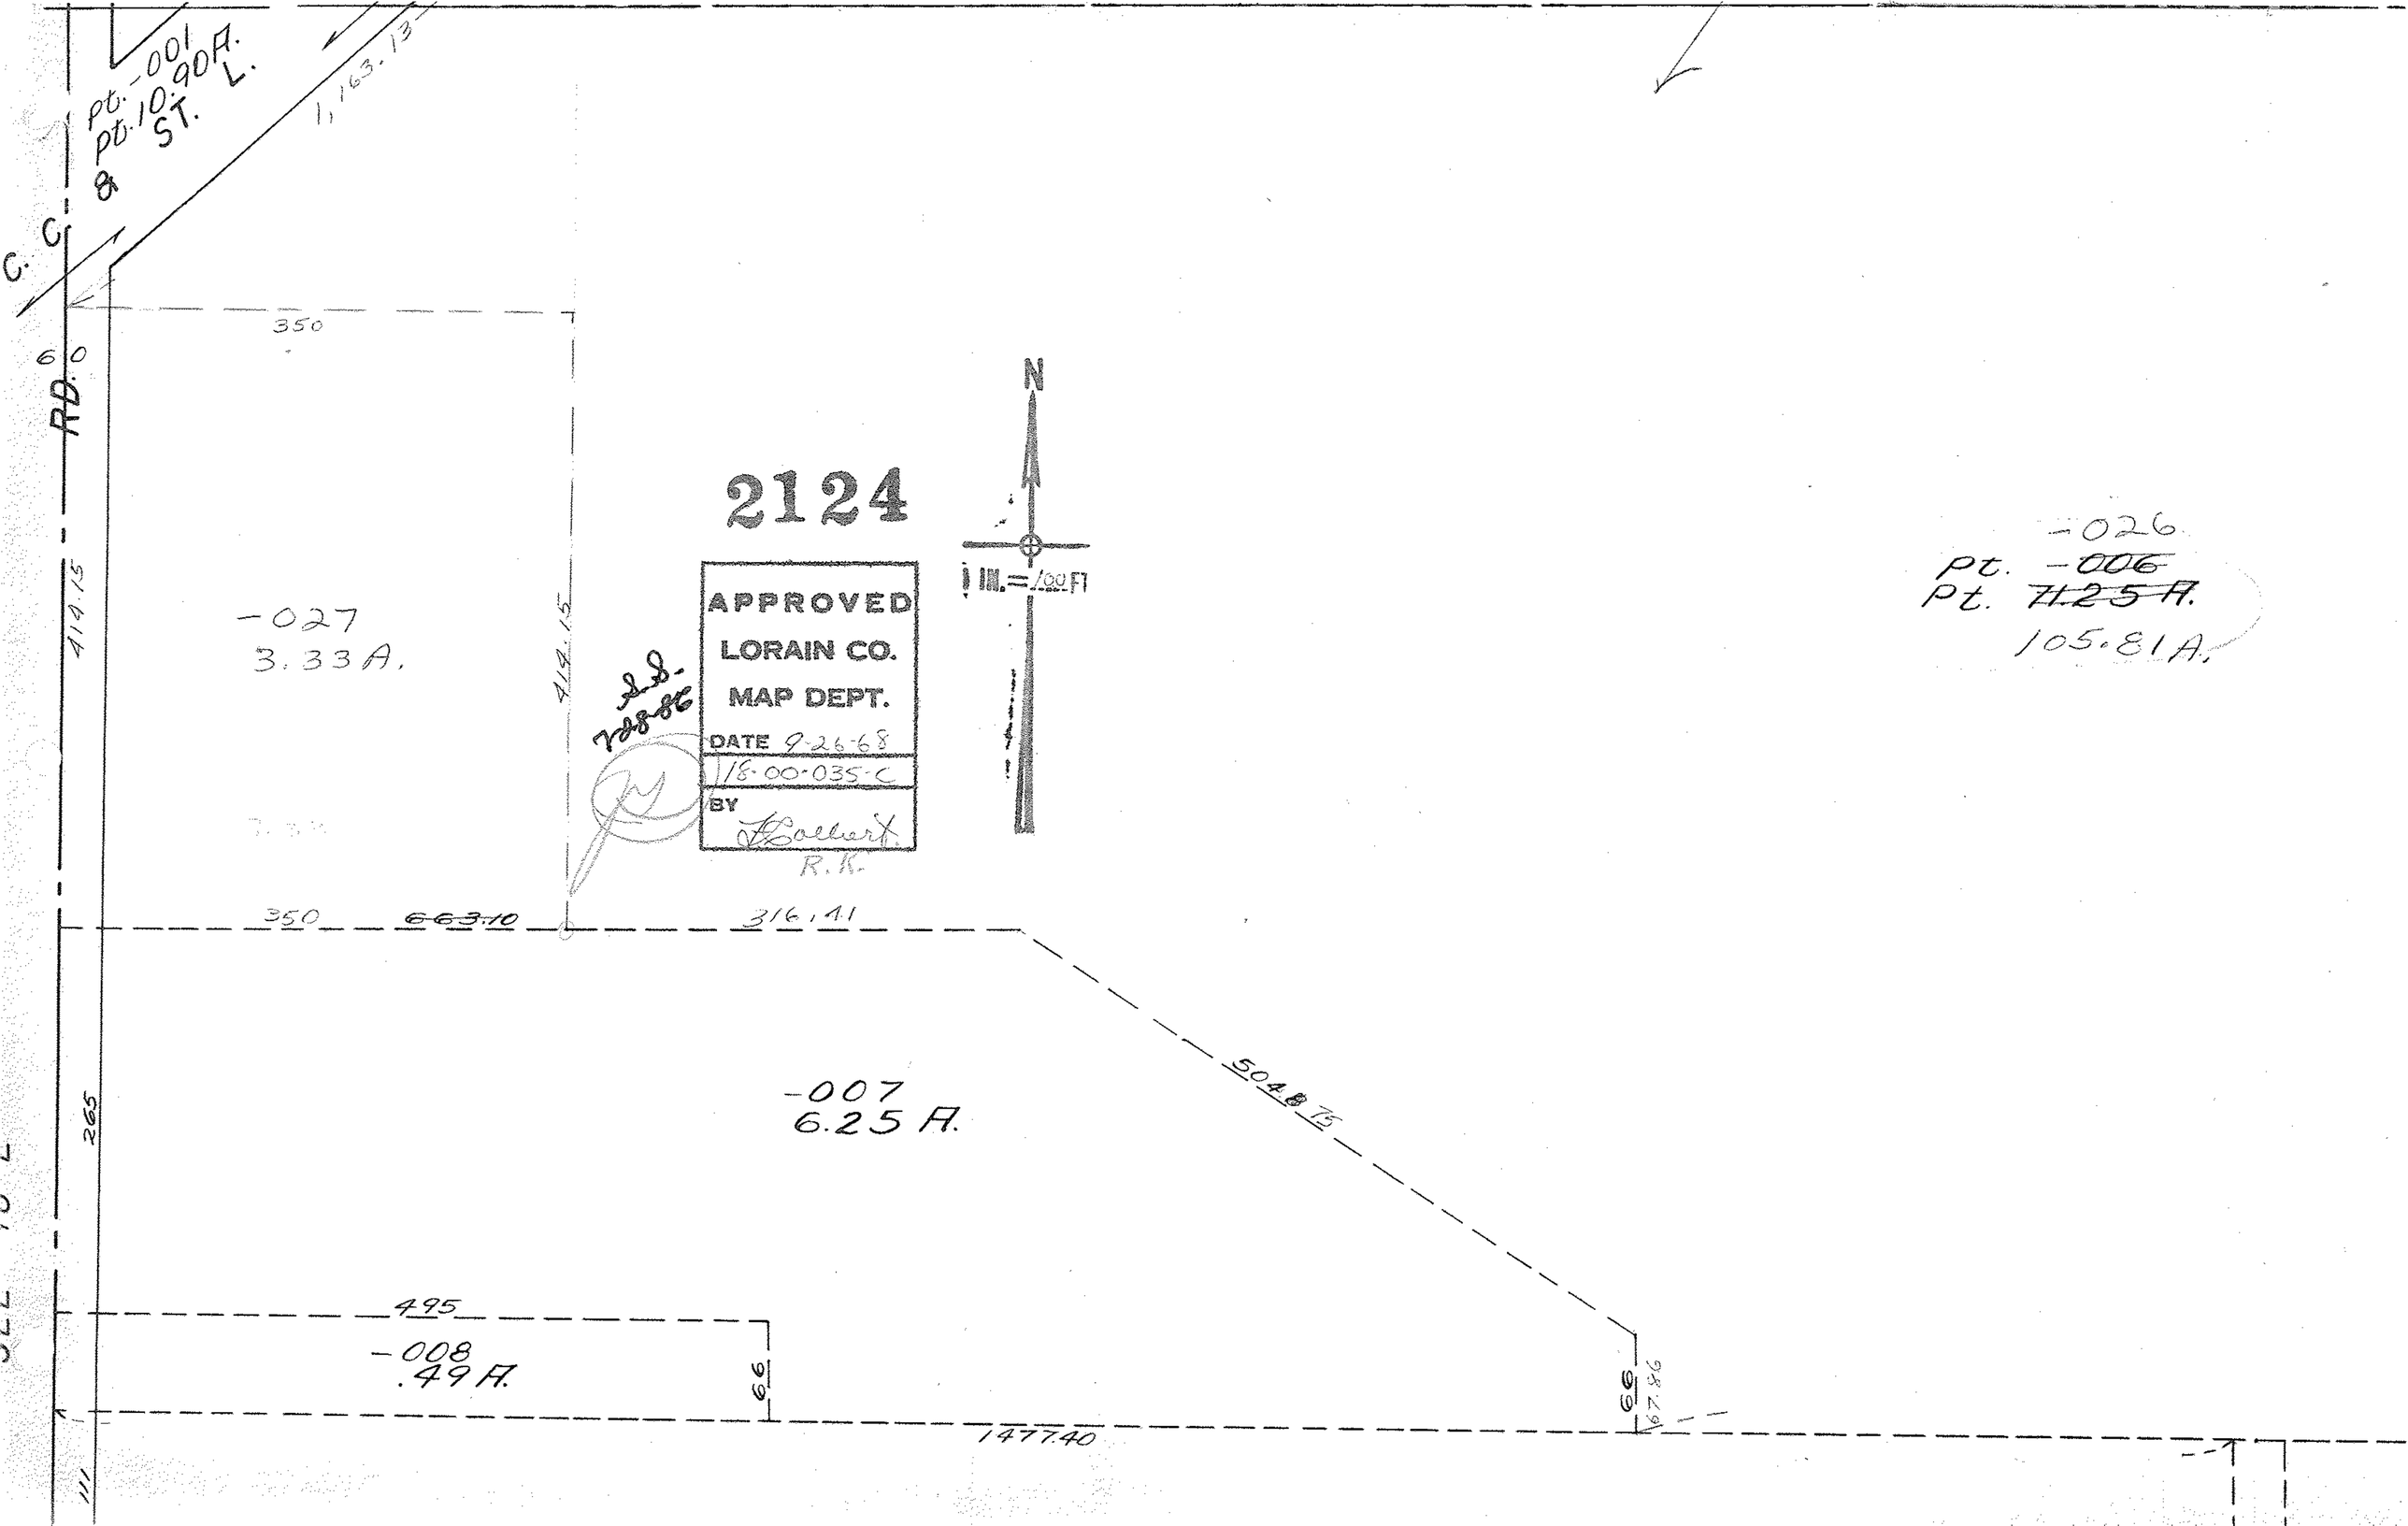

Pt. -001
Pt. 10.90 A.
& ST. L.
1,163.13
C. C.
RD.
60
350
414.15
-027
3.33 A.
414.15
2124
APPROVED
LORAIN CO.
MAP DEPT.
DATE 9-26-68
18-00-035-C
BY
R.K.
N
1 IN. = 100 FT
-026
Pt. ~~-006~~
Pt. ~~71.25 A.~~
105.81 A.
350
~~663.10~~
316.41
-007
6.25 A.
504.75
265
495
-008
.49 A.
66
66
67.86
1477.40
111