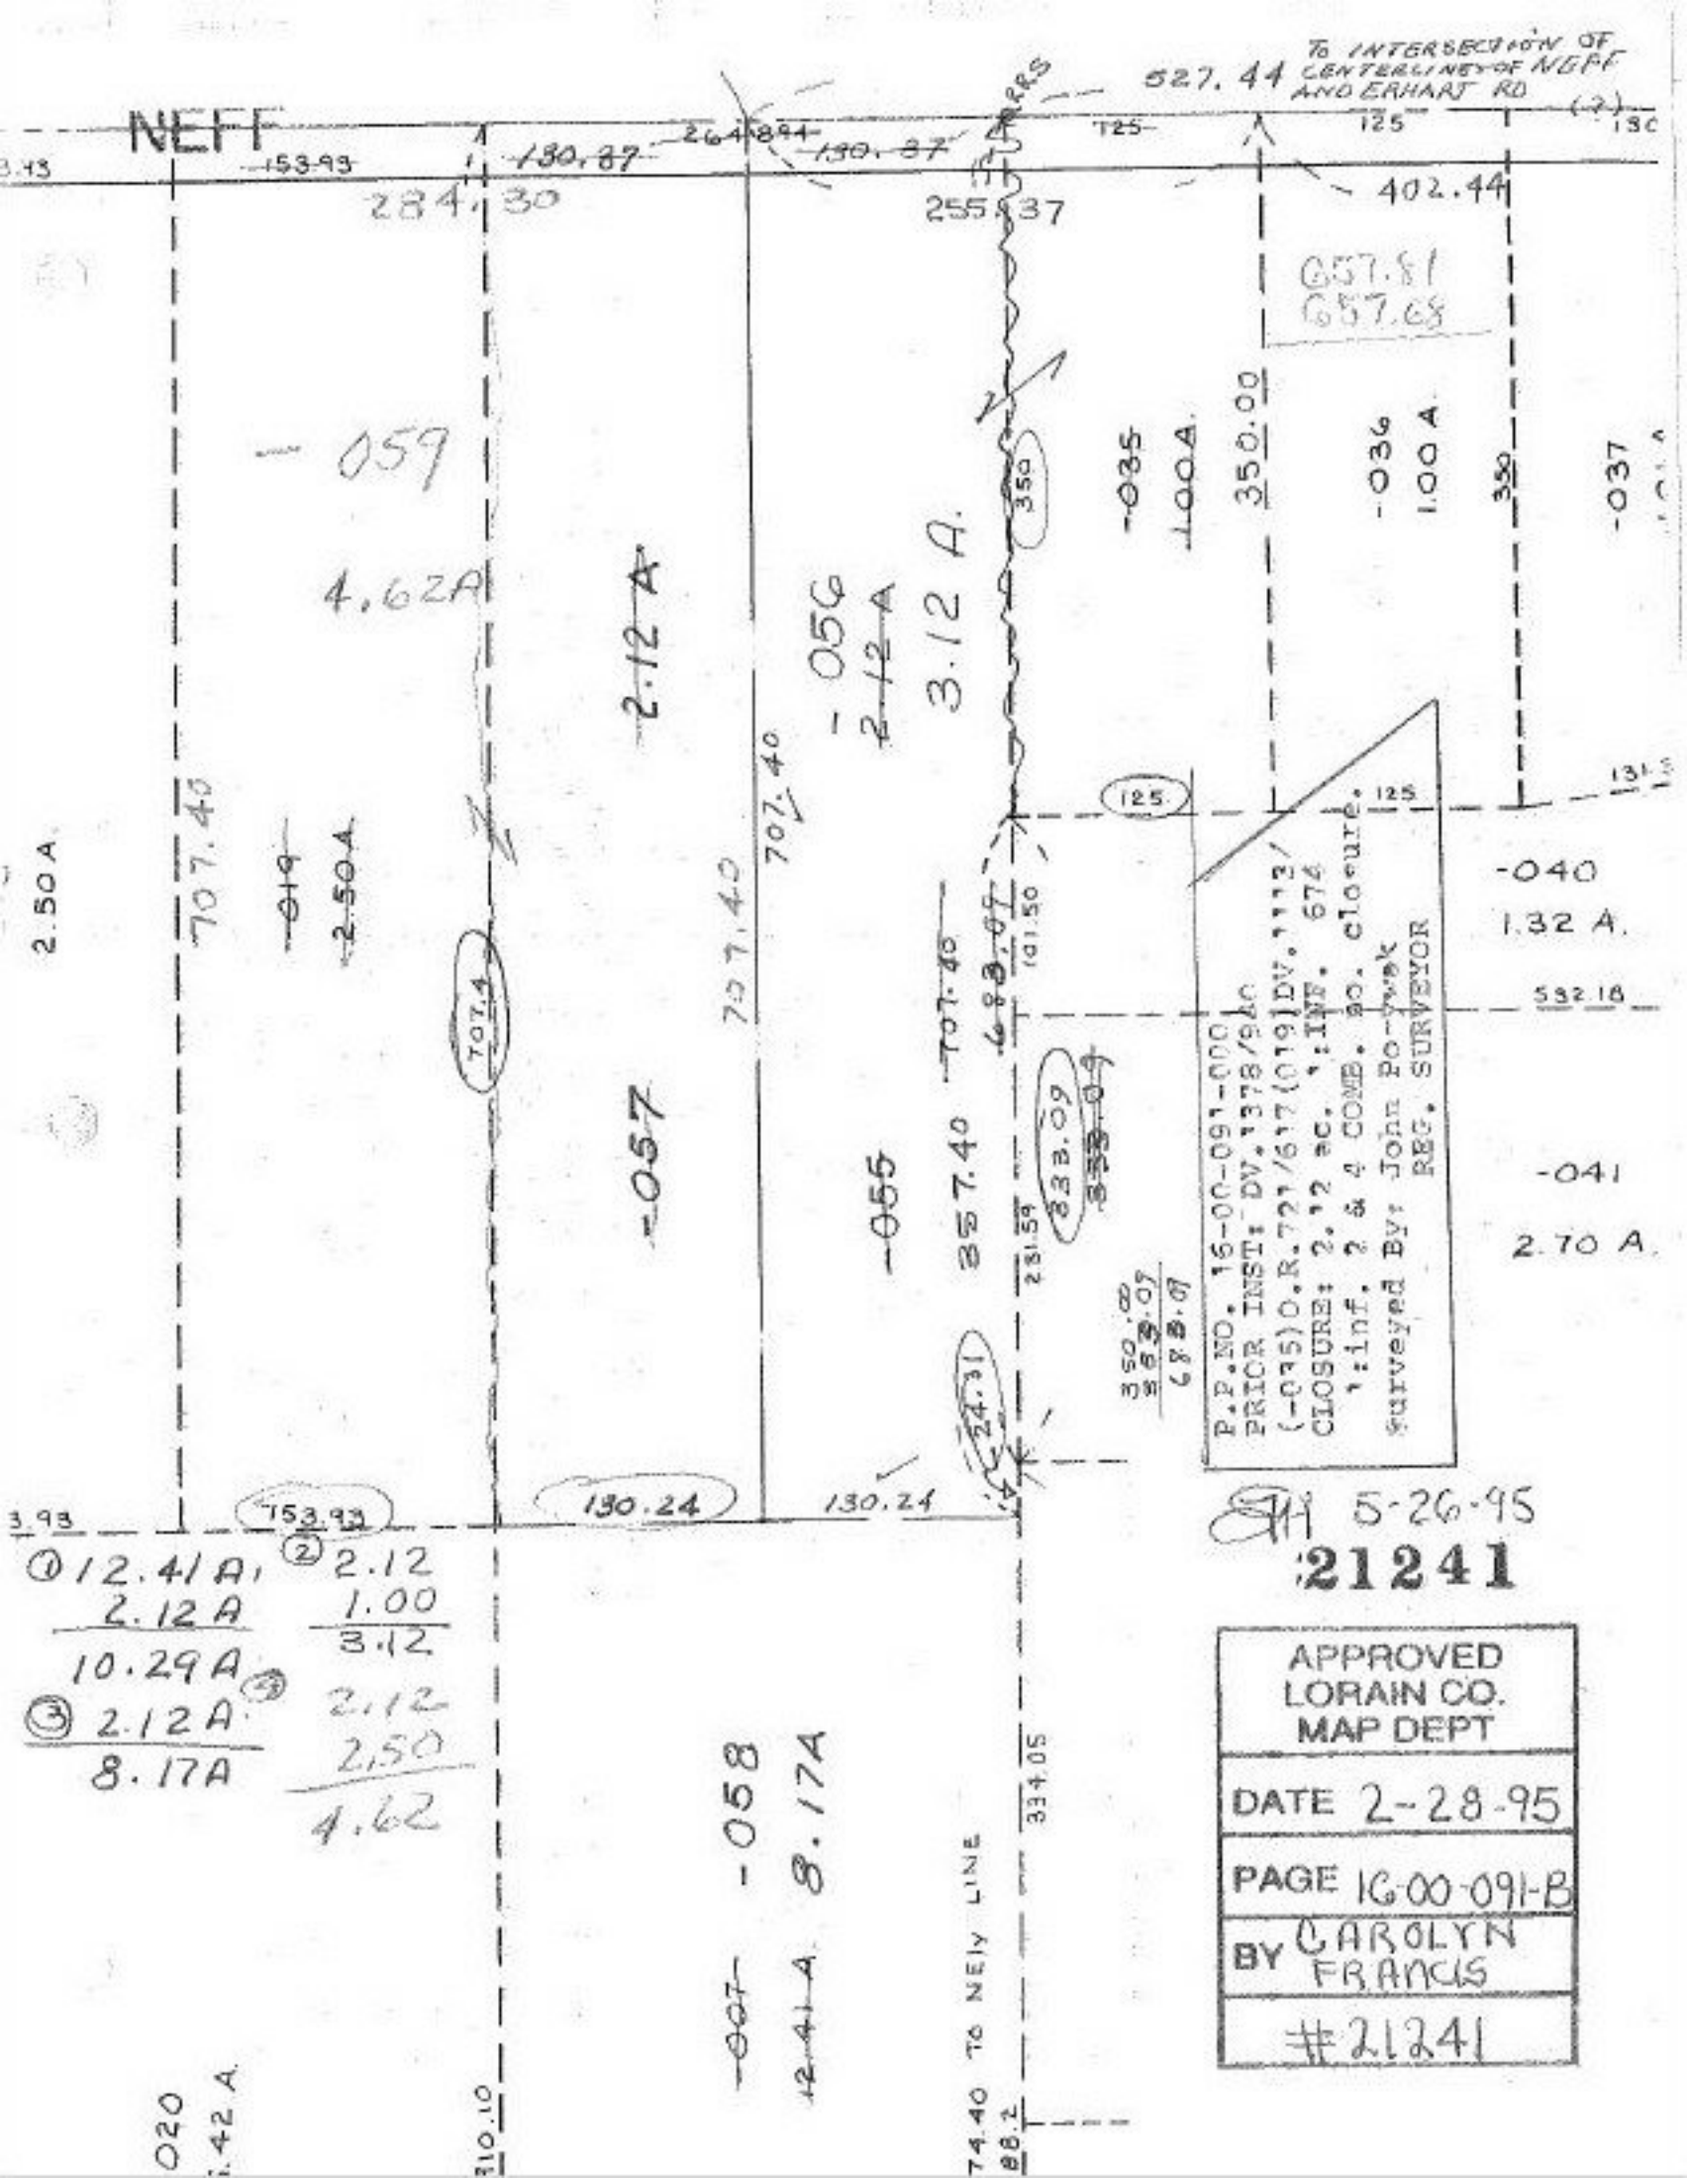

① 12.41 A
2.12 A
10.29 A

③ 2.12 A
8.17 A

② 2.12
1.00
3.12

2.12
2.50
4.62