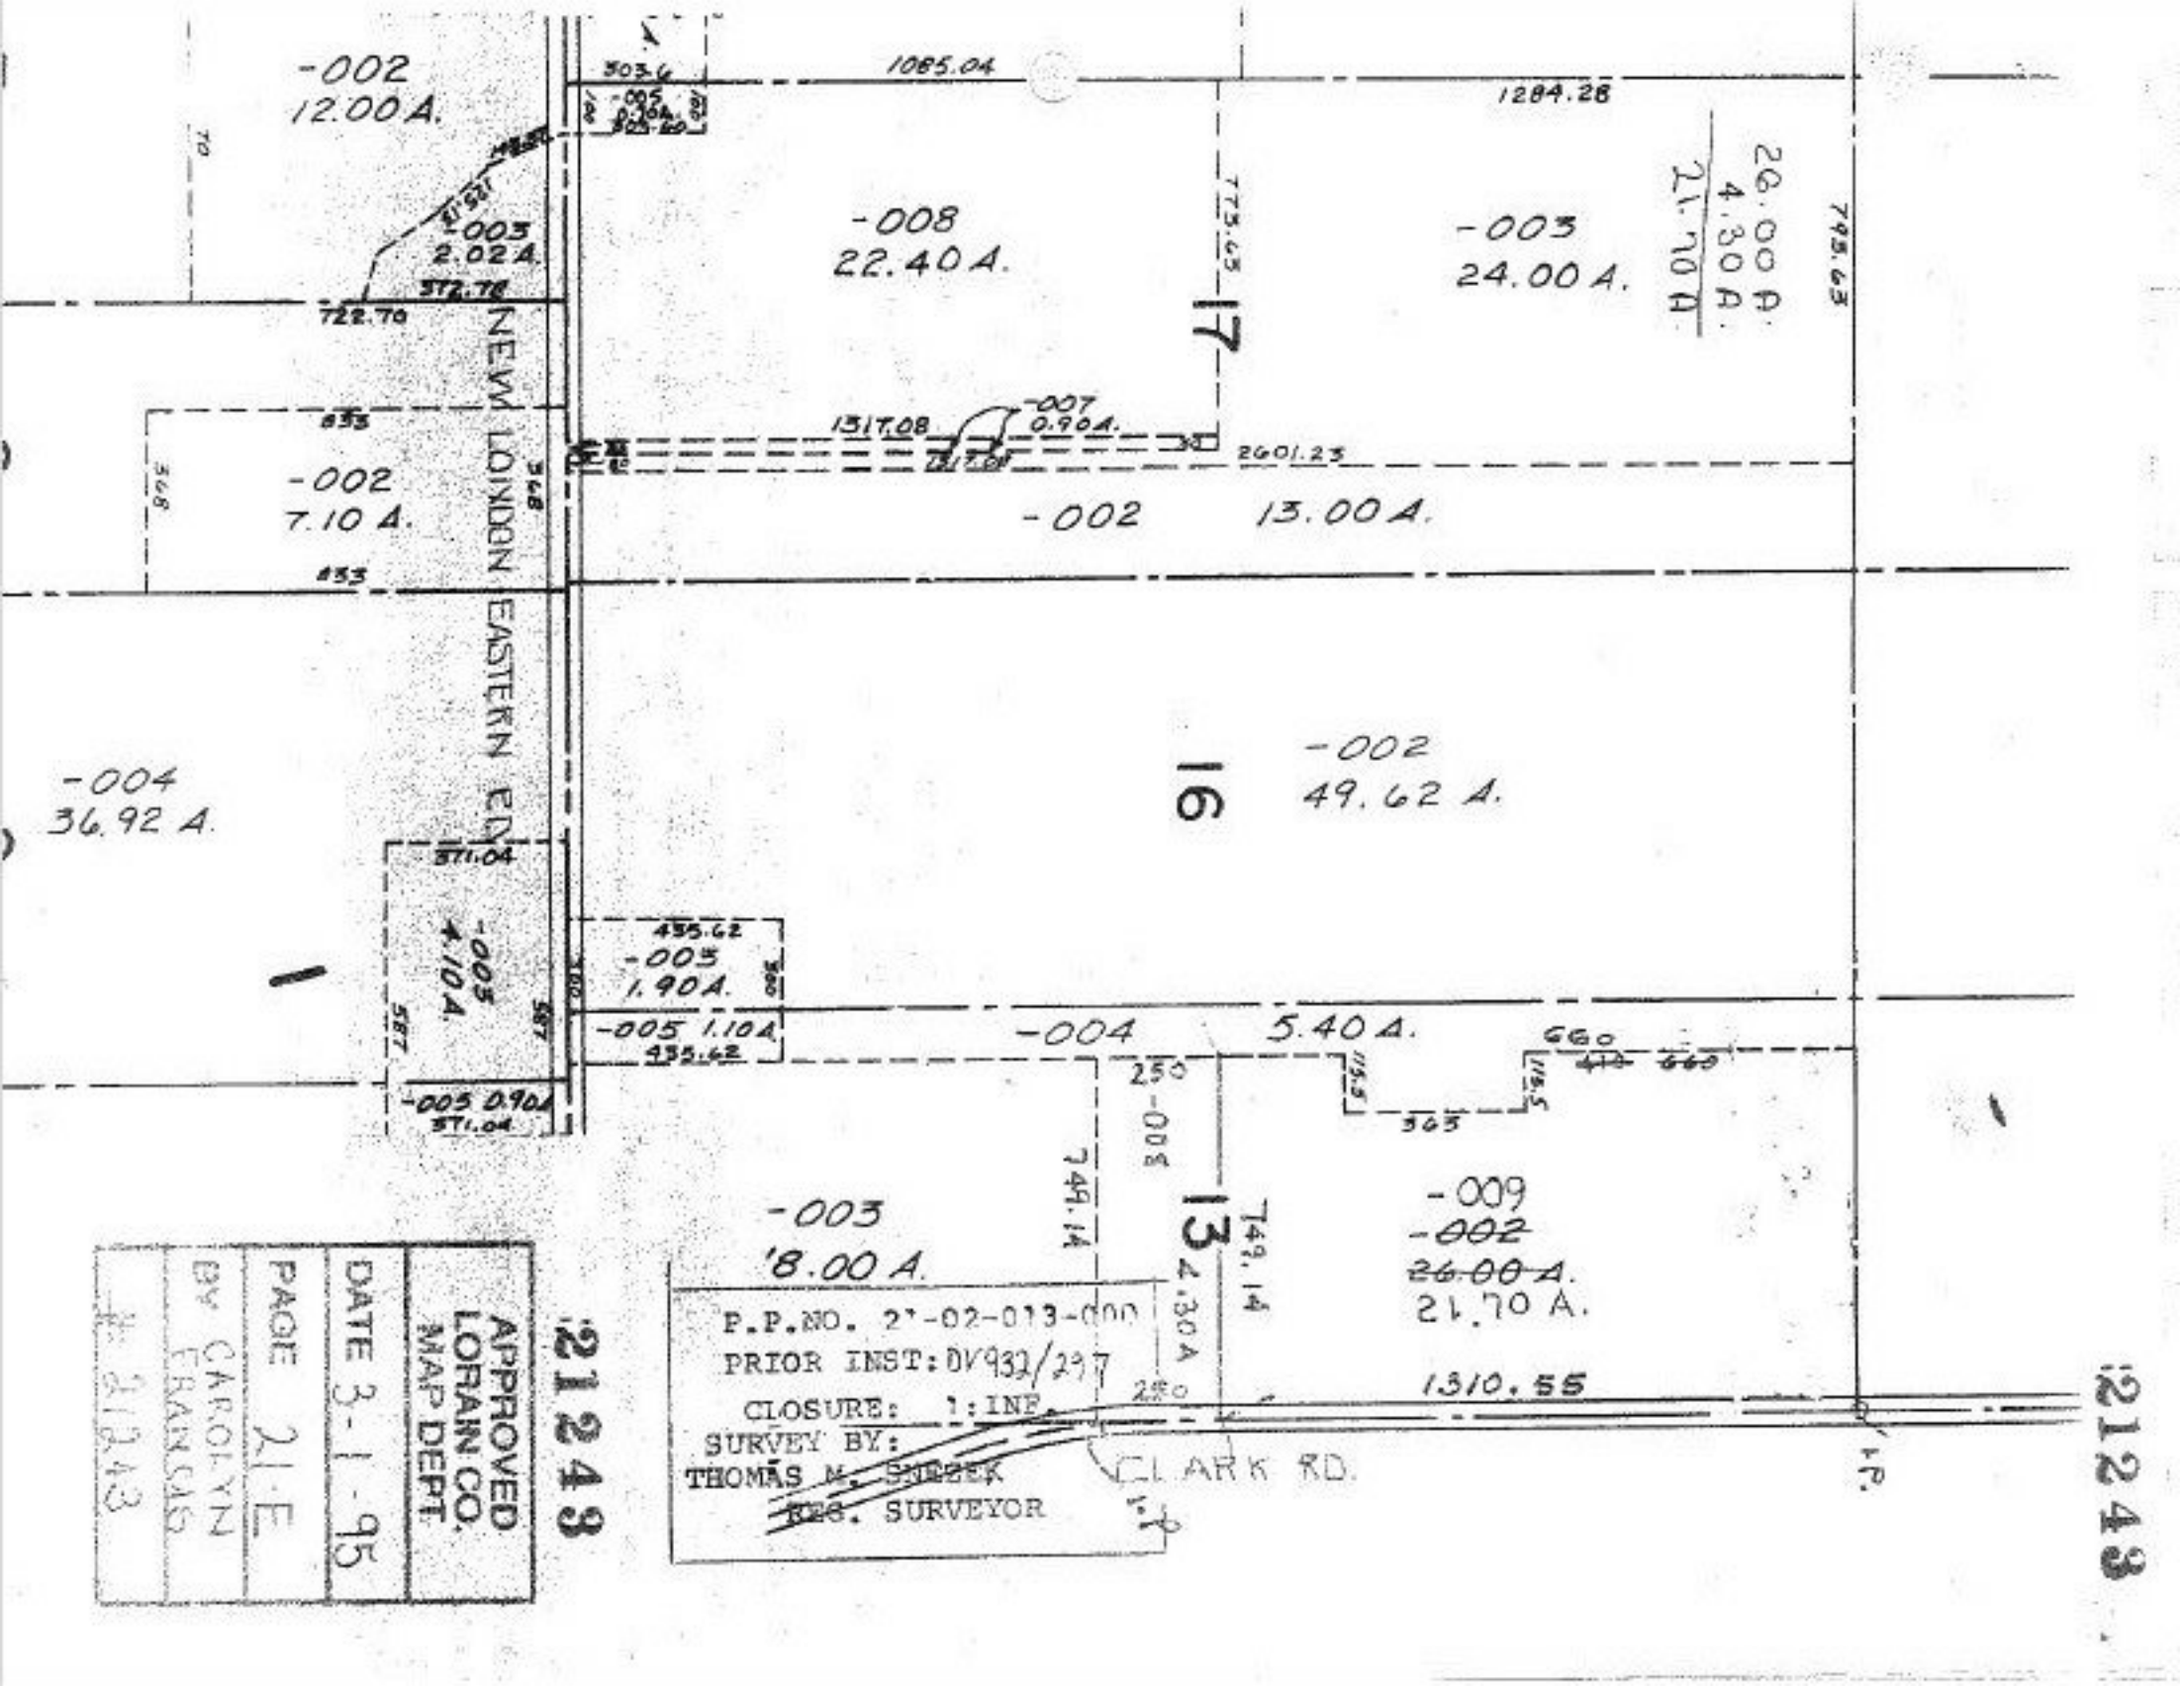
-002
12.00 A.
-003
2.02 A.
-008
22.40 A.
-003
24.00 A.
26.00 A.
4.30 A.
21.70 A.
-007
0.90 A.
-002
7.10 A.
-002
13.00 A.
NEW LONDON EASTERN RY.
-004
36.92 A.
-002
49.62 A.
-005
1.90 A.
-005
1.10 A.
-005 0.90 A.
-004
5.40 A.
-003
18.00 A.
-009
-002
26.00 A.
21.70 A.
P.P.NO. 21-02-013-000
PRIOR INST: DV932/297
CLOSURE: 1:INF.
SURVEY BY:
THOMAS M. SWEEK
REG. SURVEYOR
CLARK RD.
APPROVED
LORAIN CO.
MAP DEPT.
DATE 3-1-95
PAGE 21E
BY CAROLYN
FRANCIS
#21243
