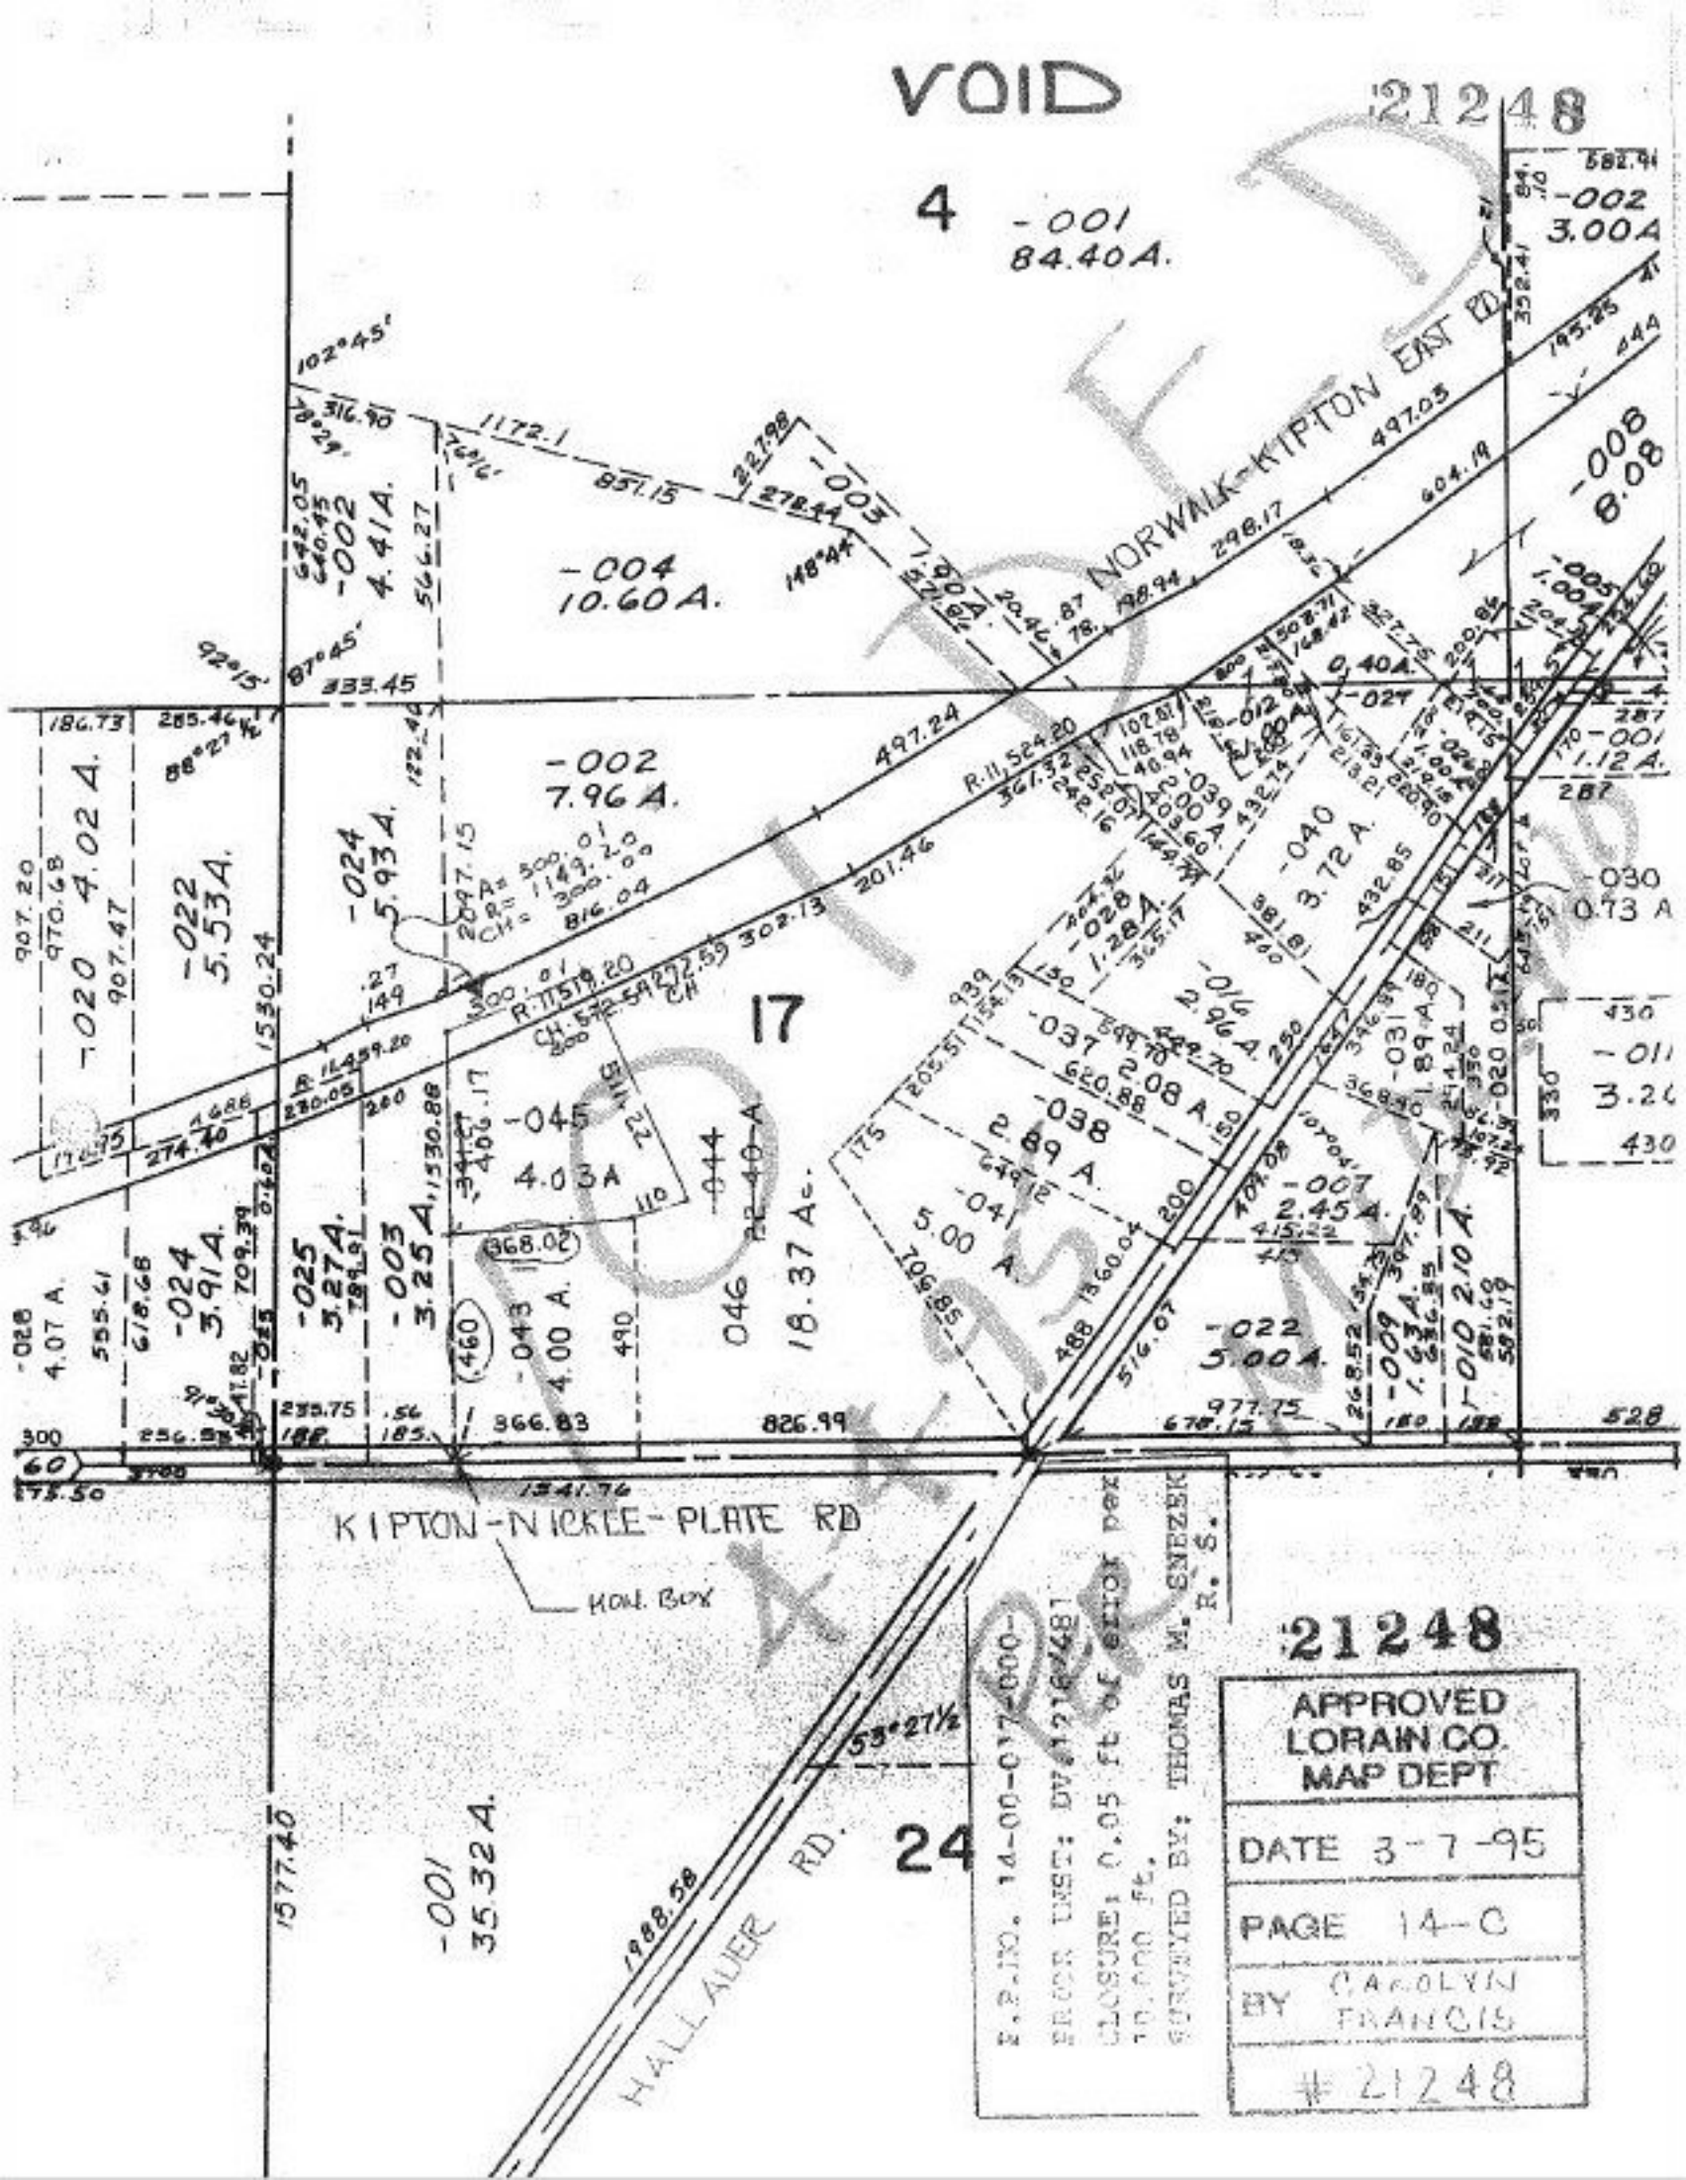
VOID
21248
4
-001
84.40A.
-002
3.00A
-003
-004
10.60A.
-008
8.08
NORWALK-KIPTON EAST RD.
-002
7.96A.
-020
4.02A.
-022
5.53A.
-024
5.93A.
-040
3.72A.
-030
0.73 A
17
-045
4.03A
-044
18.37 Ac.
-037
2.08 A.
-038
2.89 A.
-041
5.00 A.
-031
1.89 A.
-007
2.45A.
-010
2.10 A.
-009
1.63A.
-022
3.00A.
-025
3.27A.
-003
3.25A.
-024
3.91A.
-043
4.00 A.
046
-001
35.32A.
24
KIPTON-NICKEE-PLATE RD
HALLAUER RD.
MON. BOX
APPROVED
LORAIN CO.
MAP DEPT
DATE 3-7-95
PAGE 14-C
BY CAROLYN FRANCIS
21248
SURVEYED BY: THOMAS M. SNEZEK R.S.
ERROR DIST: 07.21 ft of error per
CLOSURE: 0.05 ft.
P.P.NO. 14-00-017-000-