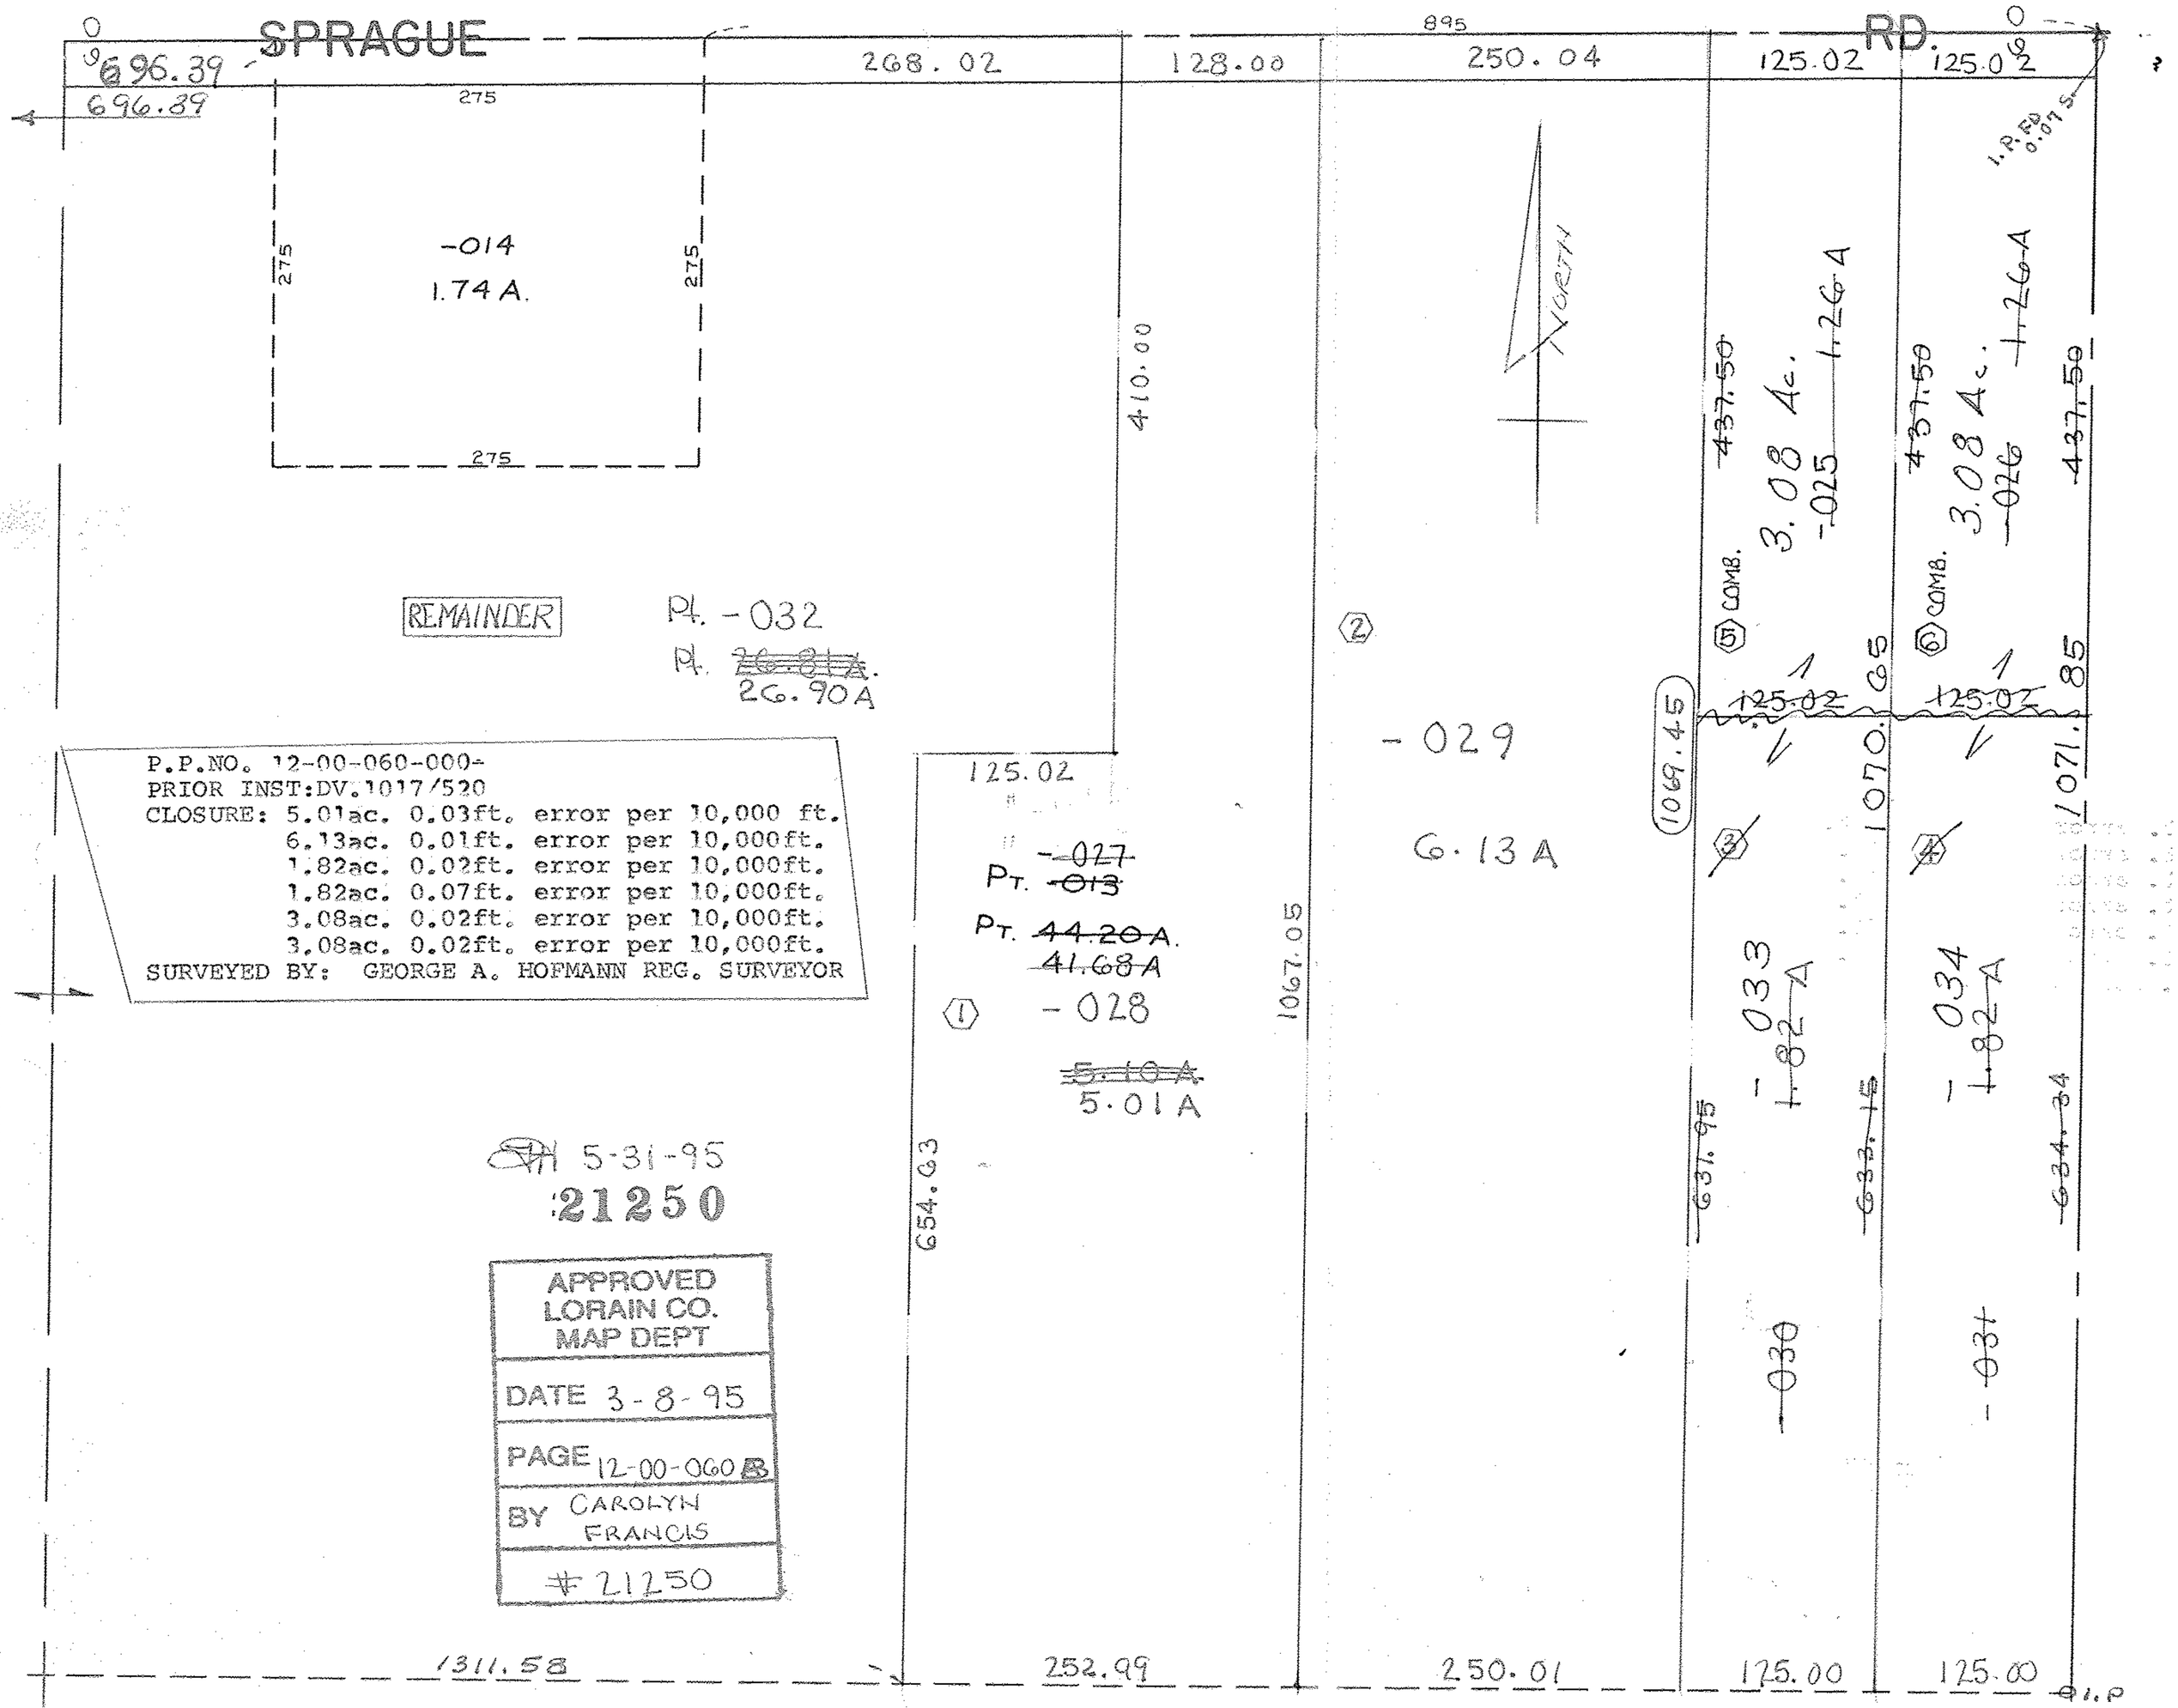

P.P.NO. 12-00-060-000-
PRIOR INST:DV.1017/520
CLOSURE: 5.01ac. 0.03ft. error per 10,000 ft.
6.13ac. 0.01ft. error per 10,000ft.
1.82ac. 0.02ft. error per 10,000ft.
1.82ac. 0.07ft. error per 10,000ft.
3.08ac. 0.02ft. error per 10,000ft.
3.08ac. 0.02ft. error per 10,000ft.
SURVEYED BY: GEORGE A. HOFMANN REG. SURVEYOR

5-31-95
21250

APPROVED
LORAIN CO.
MAP DEPT
DATE 3-8-95
PAGE 12-00-060 B
BY CAROLYN FRANCIS
21250