


SEE 5-00-036-B

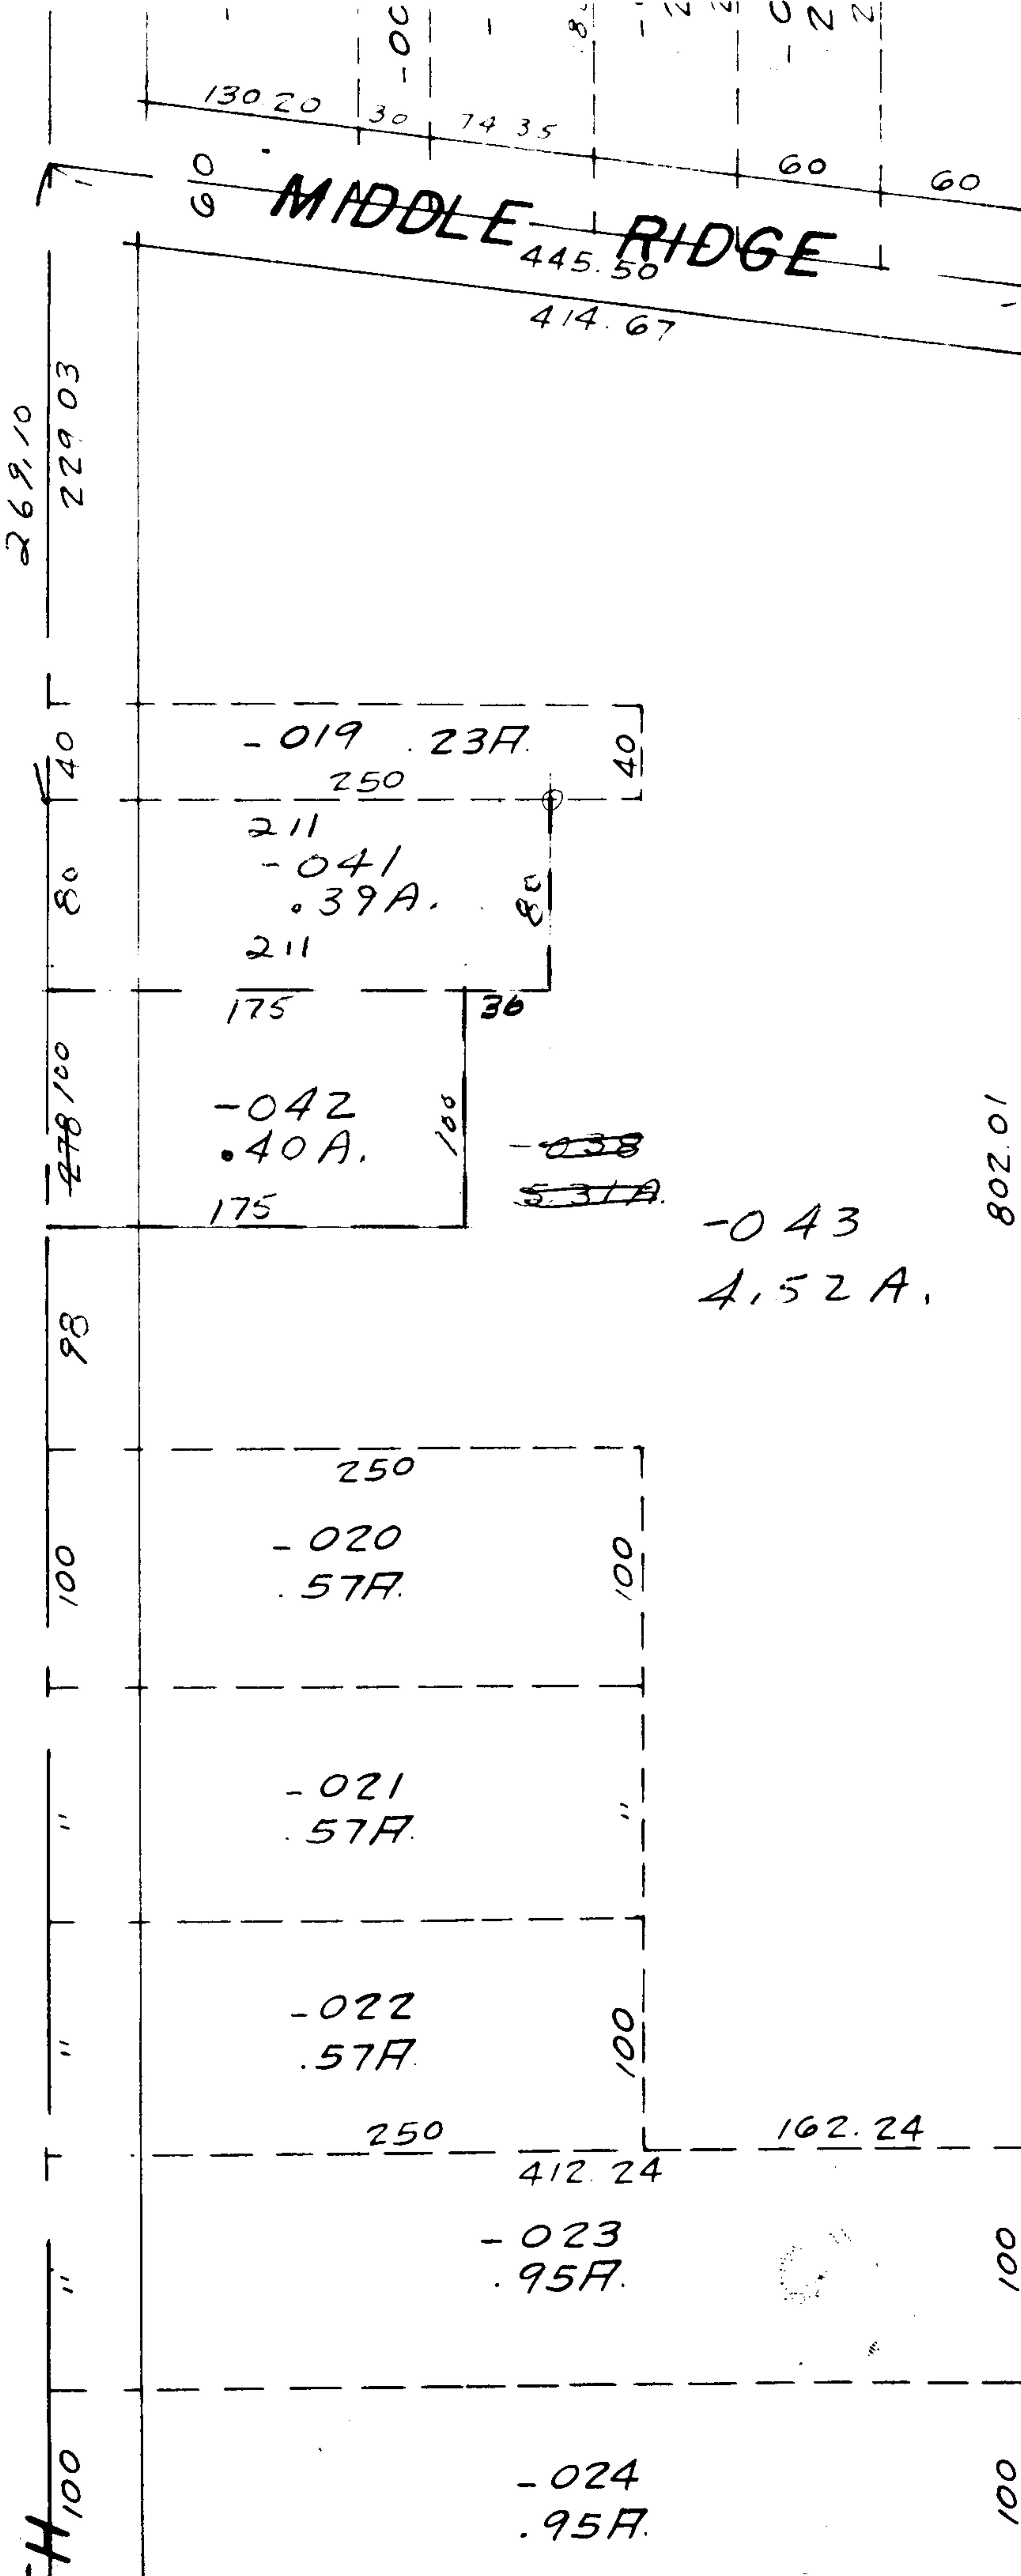

211
175
36

100

2126

APPROVED
LORAIN CO.
MAP DEPT.
 DATE 9-26-68
 5-00-045-A
 BY *Galbert*

Jy

Done 11/2/68

Grace

026
1009.00F.

531
79
4.52

