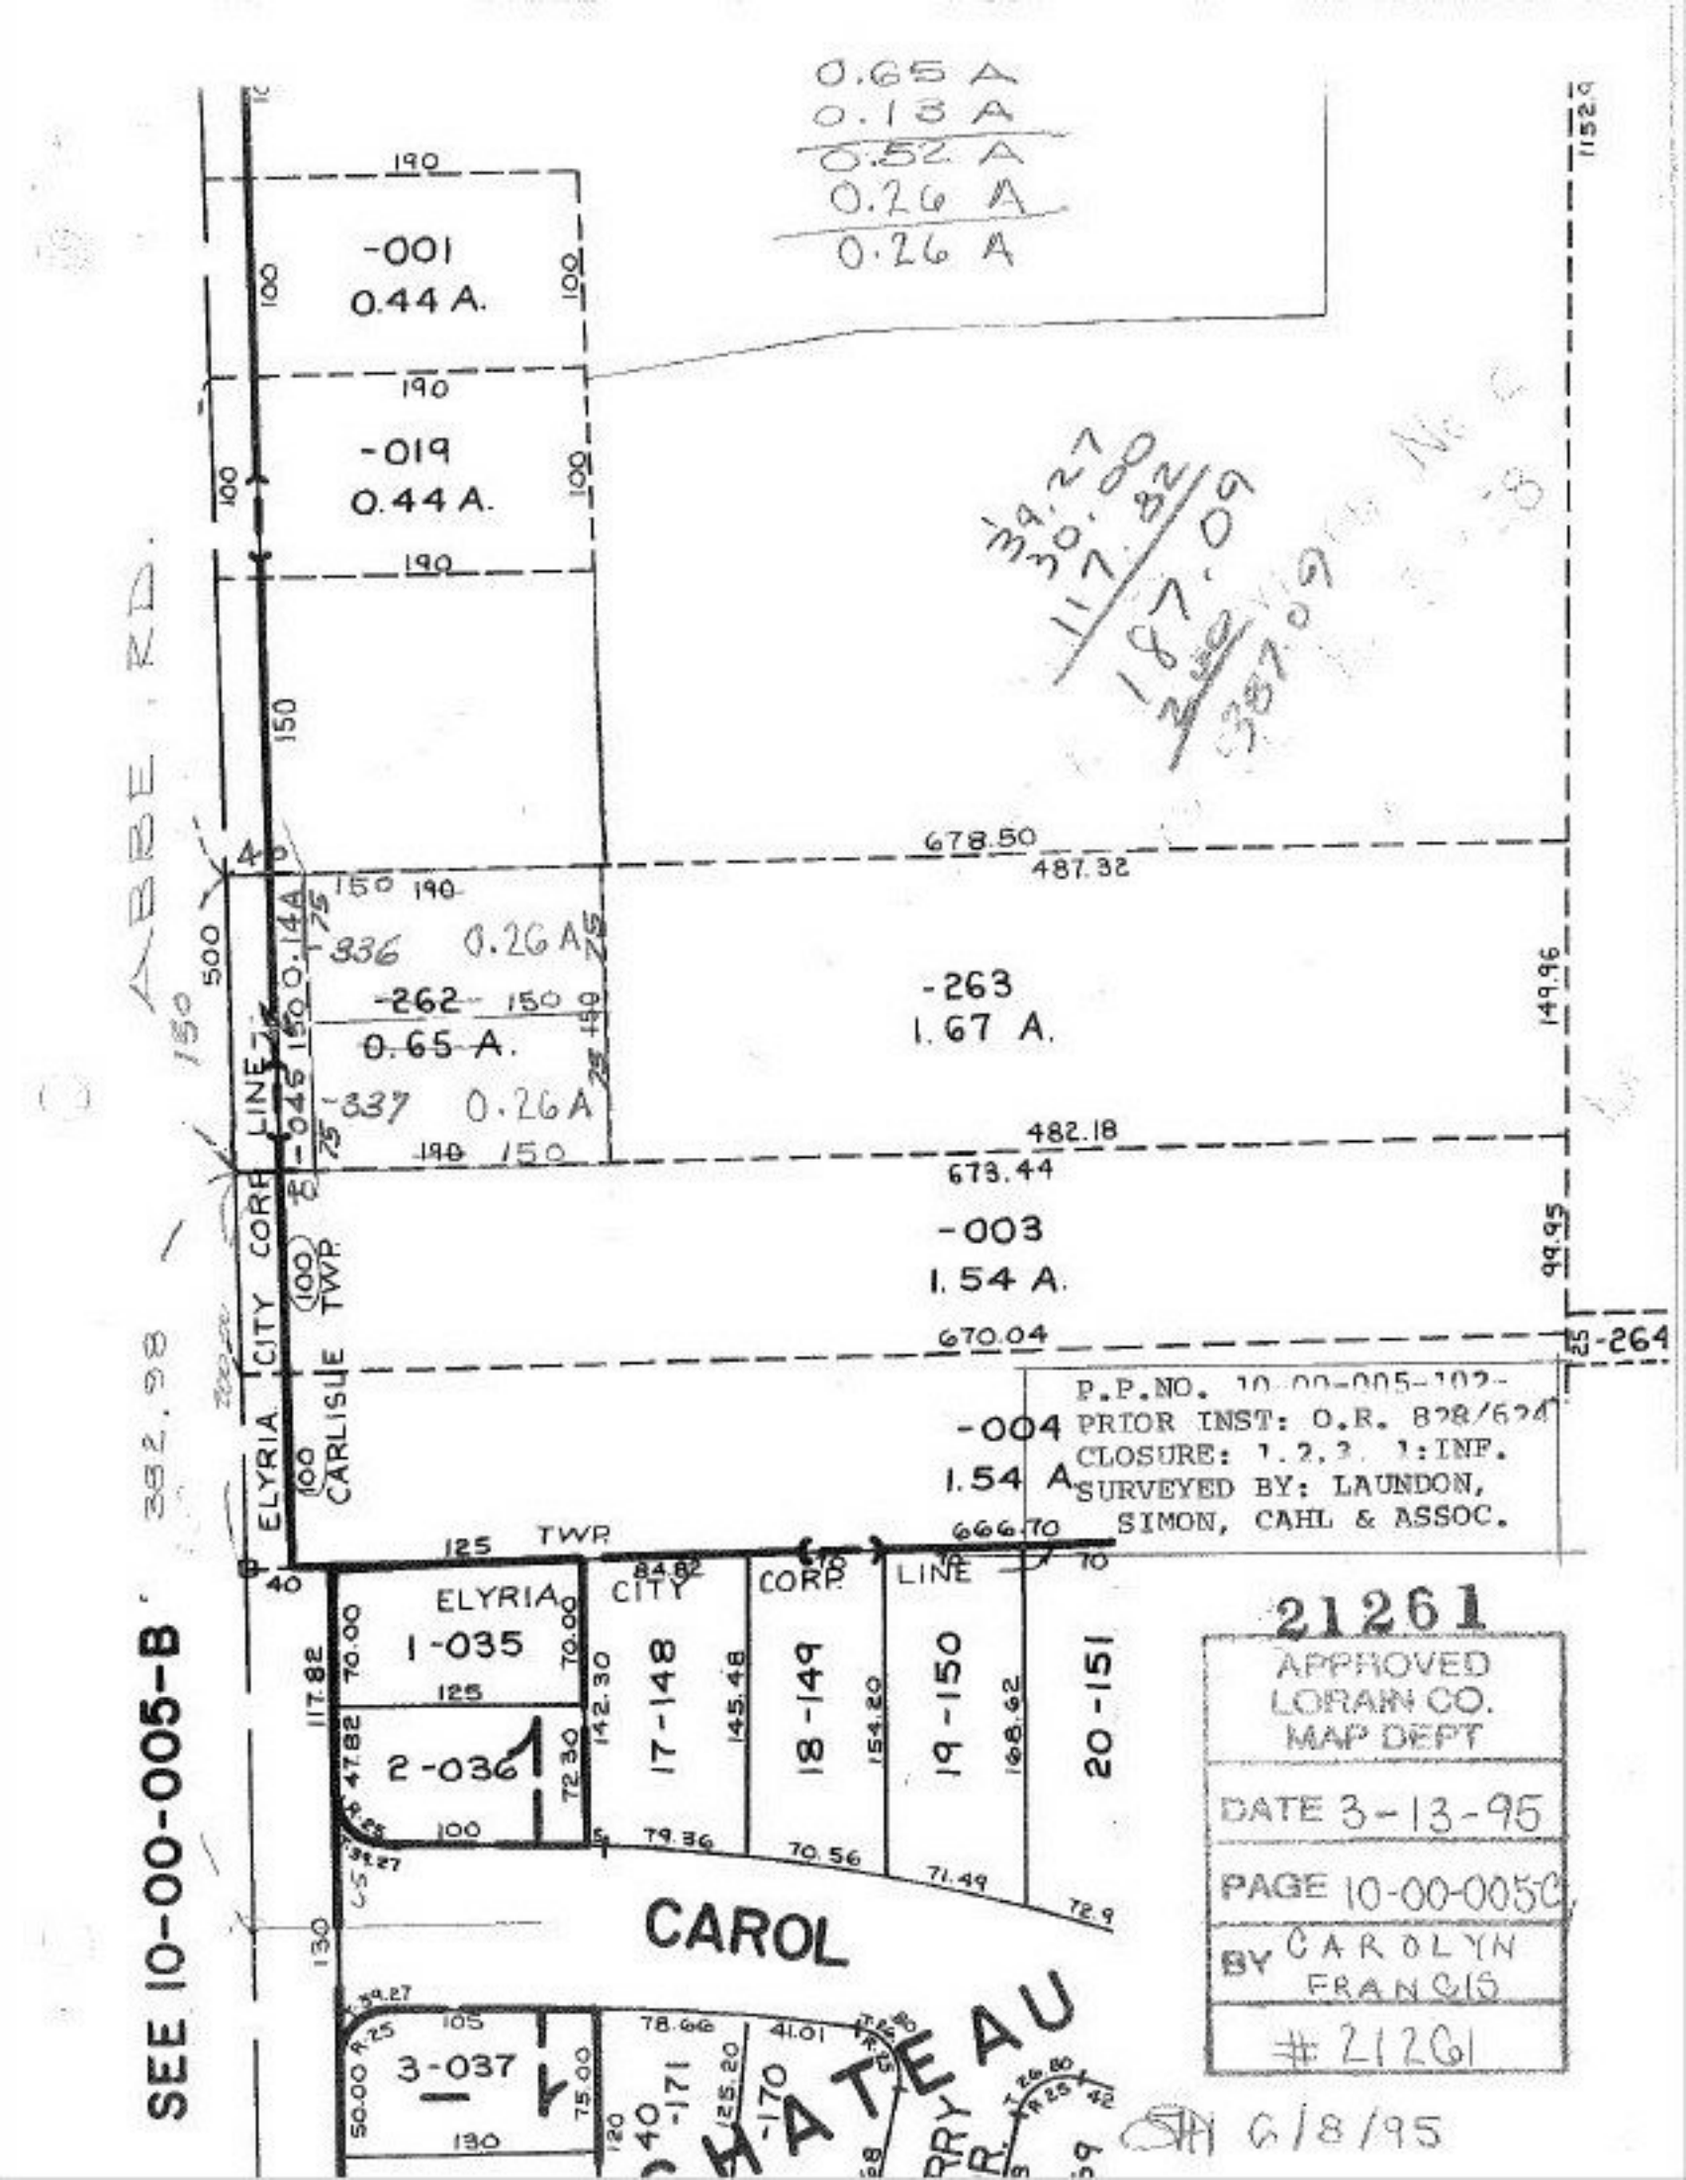
0.65 A
0.13 A
0.52 A
0.26 A
0.26 A
-001
0.44 A.
-019
0.44 A.
ABBE RD.
678.50
487.32
-263
1.67 A.
336 0.26 A
-262
0.65 A.
337 0.26 A
-045
0.14A
482.18
673.44
-003
1.54 A.
149.96
99.95
670.04
-264
ELYRIA CITY CORP LINE
CARLISLE TWP.
-004
1.54 A
666.70
125 TWP
ELYRIA CITY CORP. LINE
1-035
2-036
17-148
18-149
19-150
20-151
CAROL
3-037
-171
-170
SEE 10-00-005-B
P.P.NO. 10-00-005-102-
PRIOR INST: O.R. 828/624
CLOSURE: 1.2.3. 1:INF.
SURVEYED BY: LAUNDON, SIMON, CAHL & ASSOC.
21261
APPROVED LORAIN CO. MAP DEPT
DATE 3-13-95
PAGE 10-00-005C
BY CAROLYN FRANCIS
#21261
6/8/95