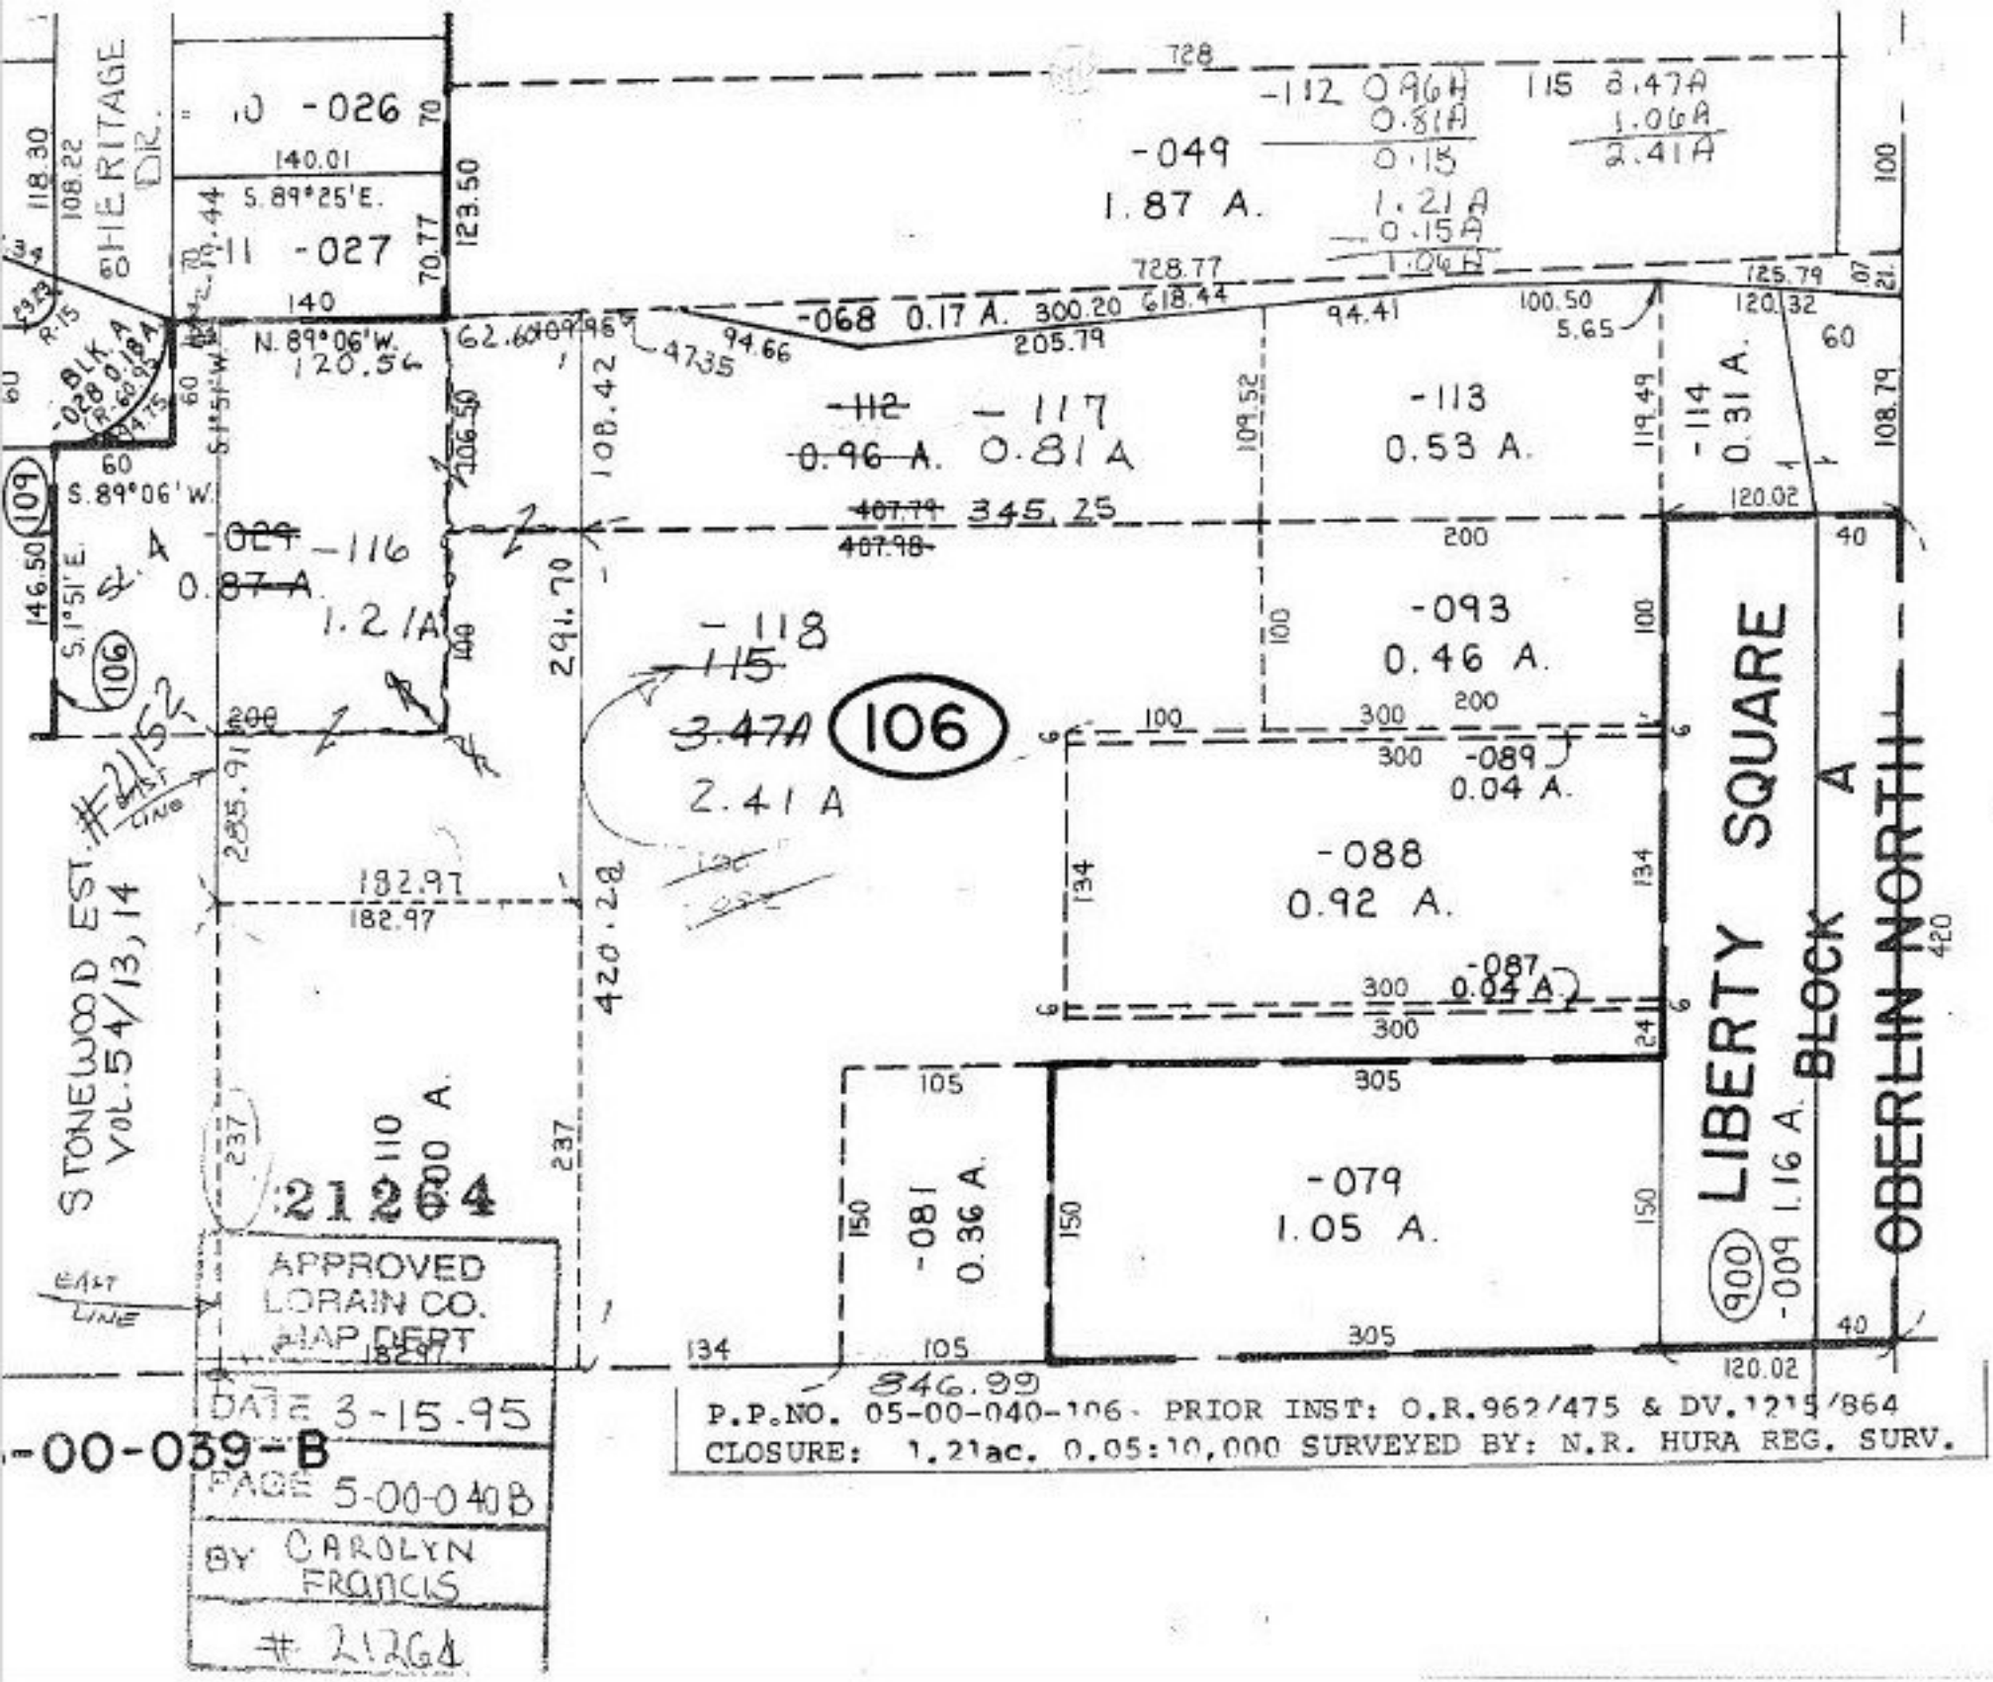
SHERITAGE DR.
-026
-027
-049
1.87 A.
-112 0.96A
0.81A
0.15
115 3.47A
1.06A
2.41A
1.21A
0.15A
1.06A
-068 0.17 A.
-112
0.96 A.
-117
0.81 A
-113
0.53 A.
-114
0.31 A.
-116
0.87 A
1.21A
-118
115
3.47A
2.41 A
106
-093
0.46 A.
-089
0.04 A.
-088
0.92 A.
-087
0.04 A.
-081
0.36 A.
-079
1.05 A.
900
-009 1.16 A.
LIBERTY SQUARE
BLOCK A
OBERLIN NORTH
STONEWOOD EST.
VOL. 54/13, 14
#21264
APPROVED
LORAIN CO.
MAP DEPT
DATE 3-15-95
PAGE 5-00-040B
BY CAROLYN FRANCIS
#21264
-00-039-B
P.P.NO. 05-00-040-106 PRIOR INST: O.R.962/475 & DV.1215/864
CLOSURE: 1.21ac. 0.05:10,000 SURVEYED BY: N.R. HURA REG. SURV.
NORTH
21264