21265-A

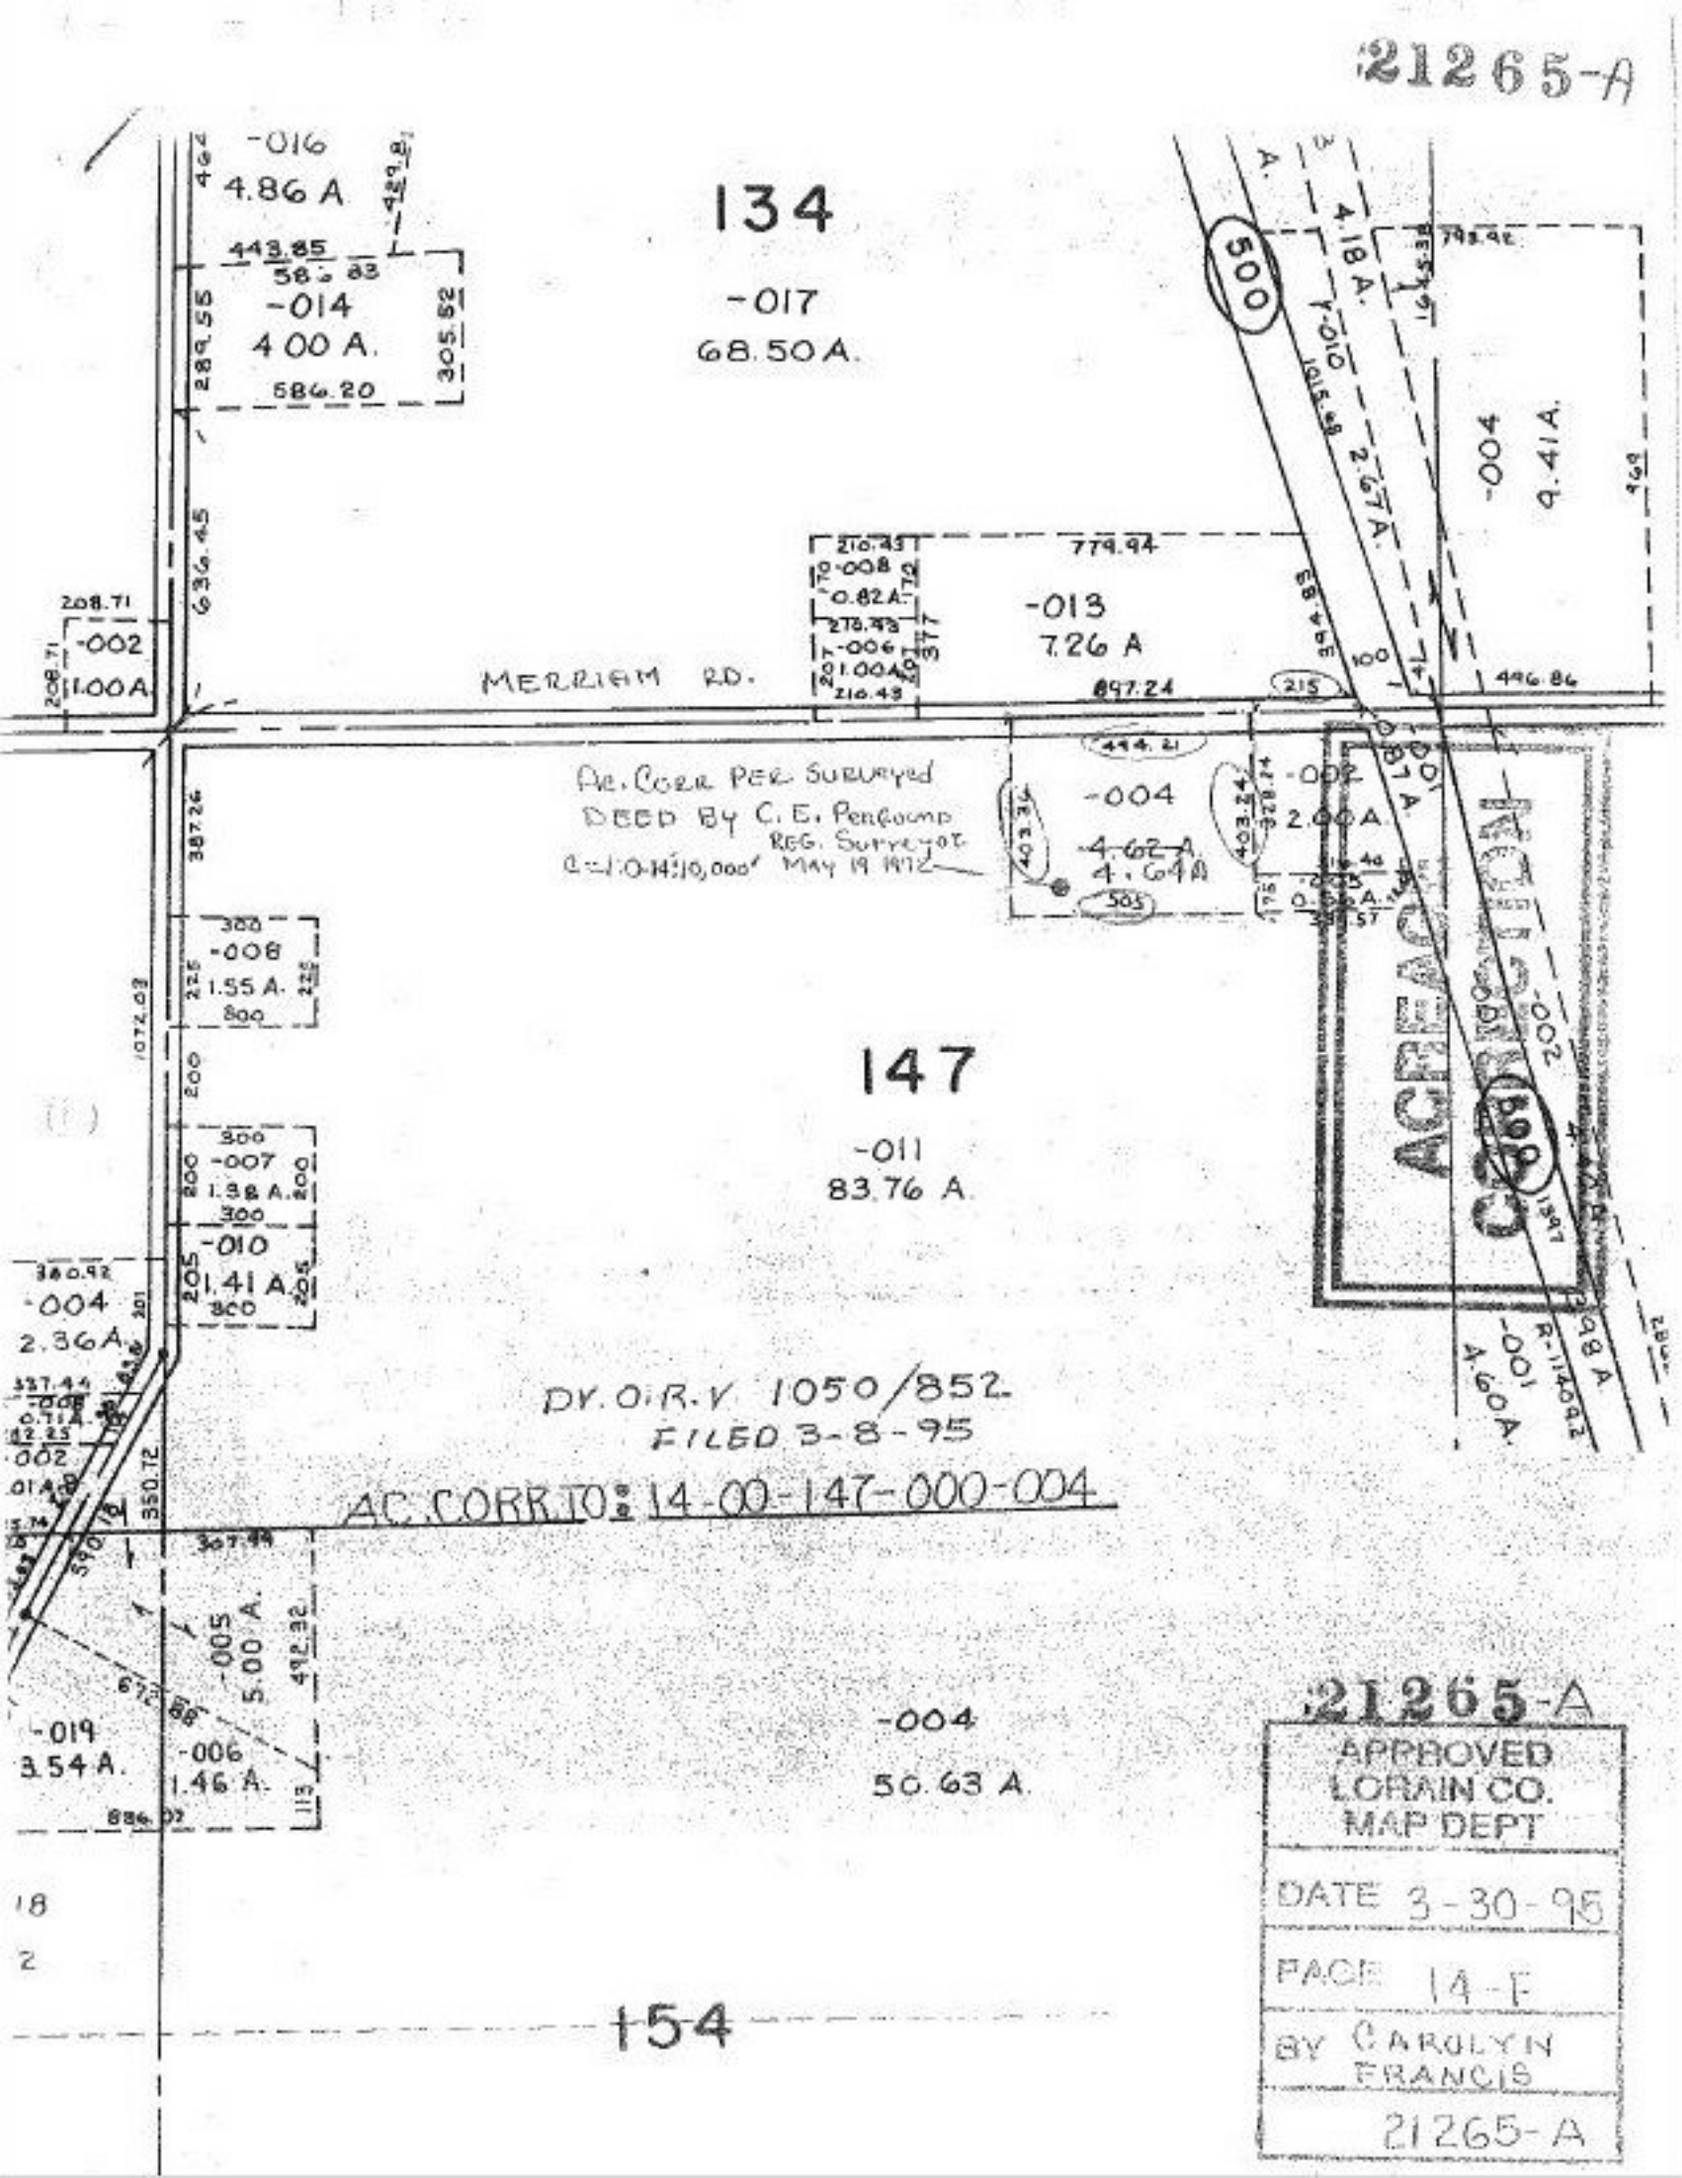

21265-A

APPROVED
LORAIN CO.
MAP DEPT

DATE 3-30-95

PAGE 14-F

BY CAROLYN FRANCIS

21265-A