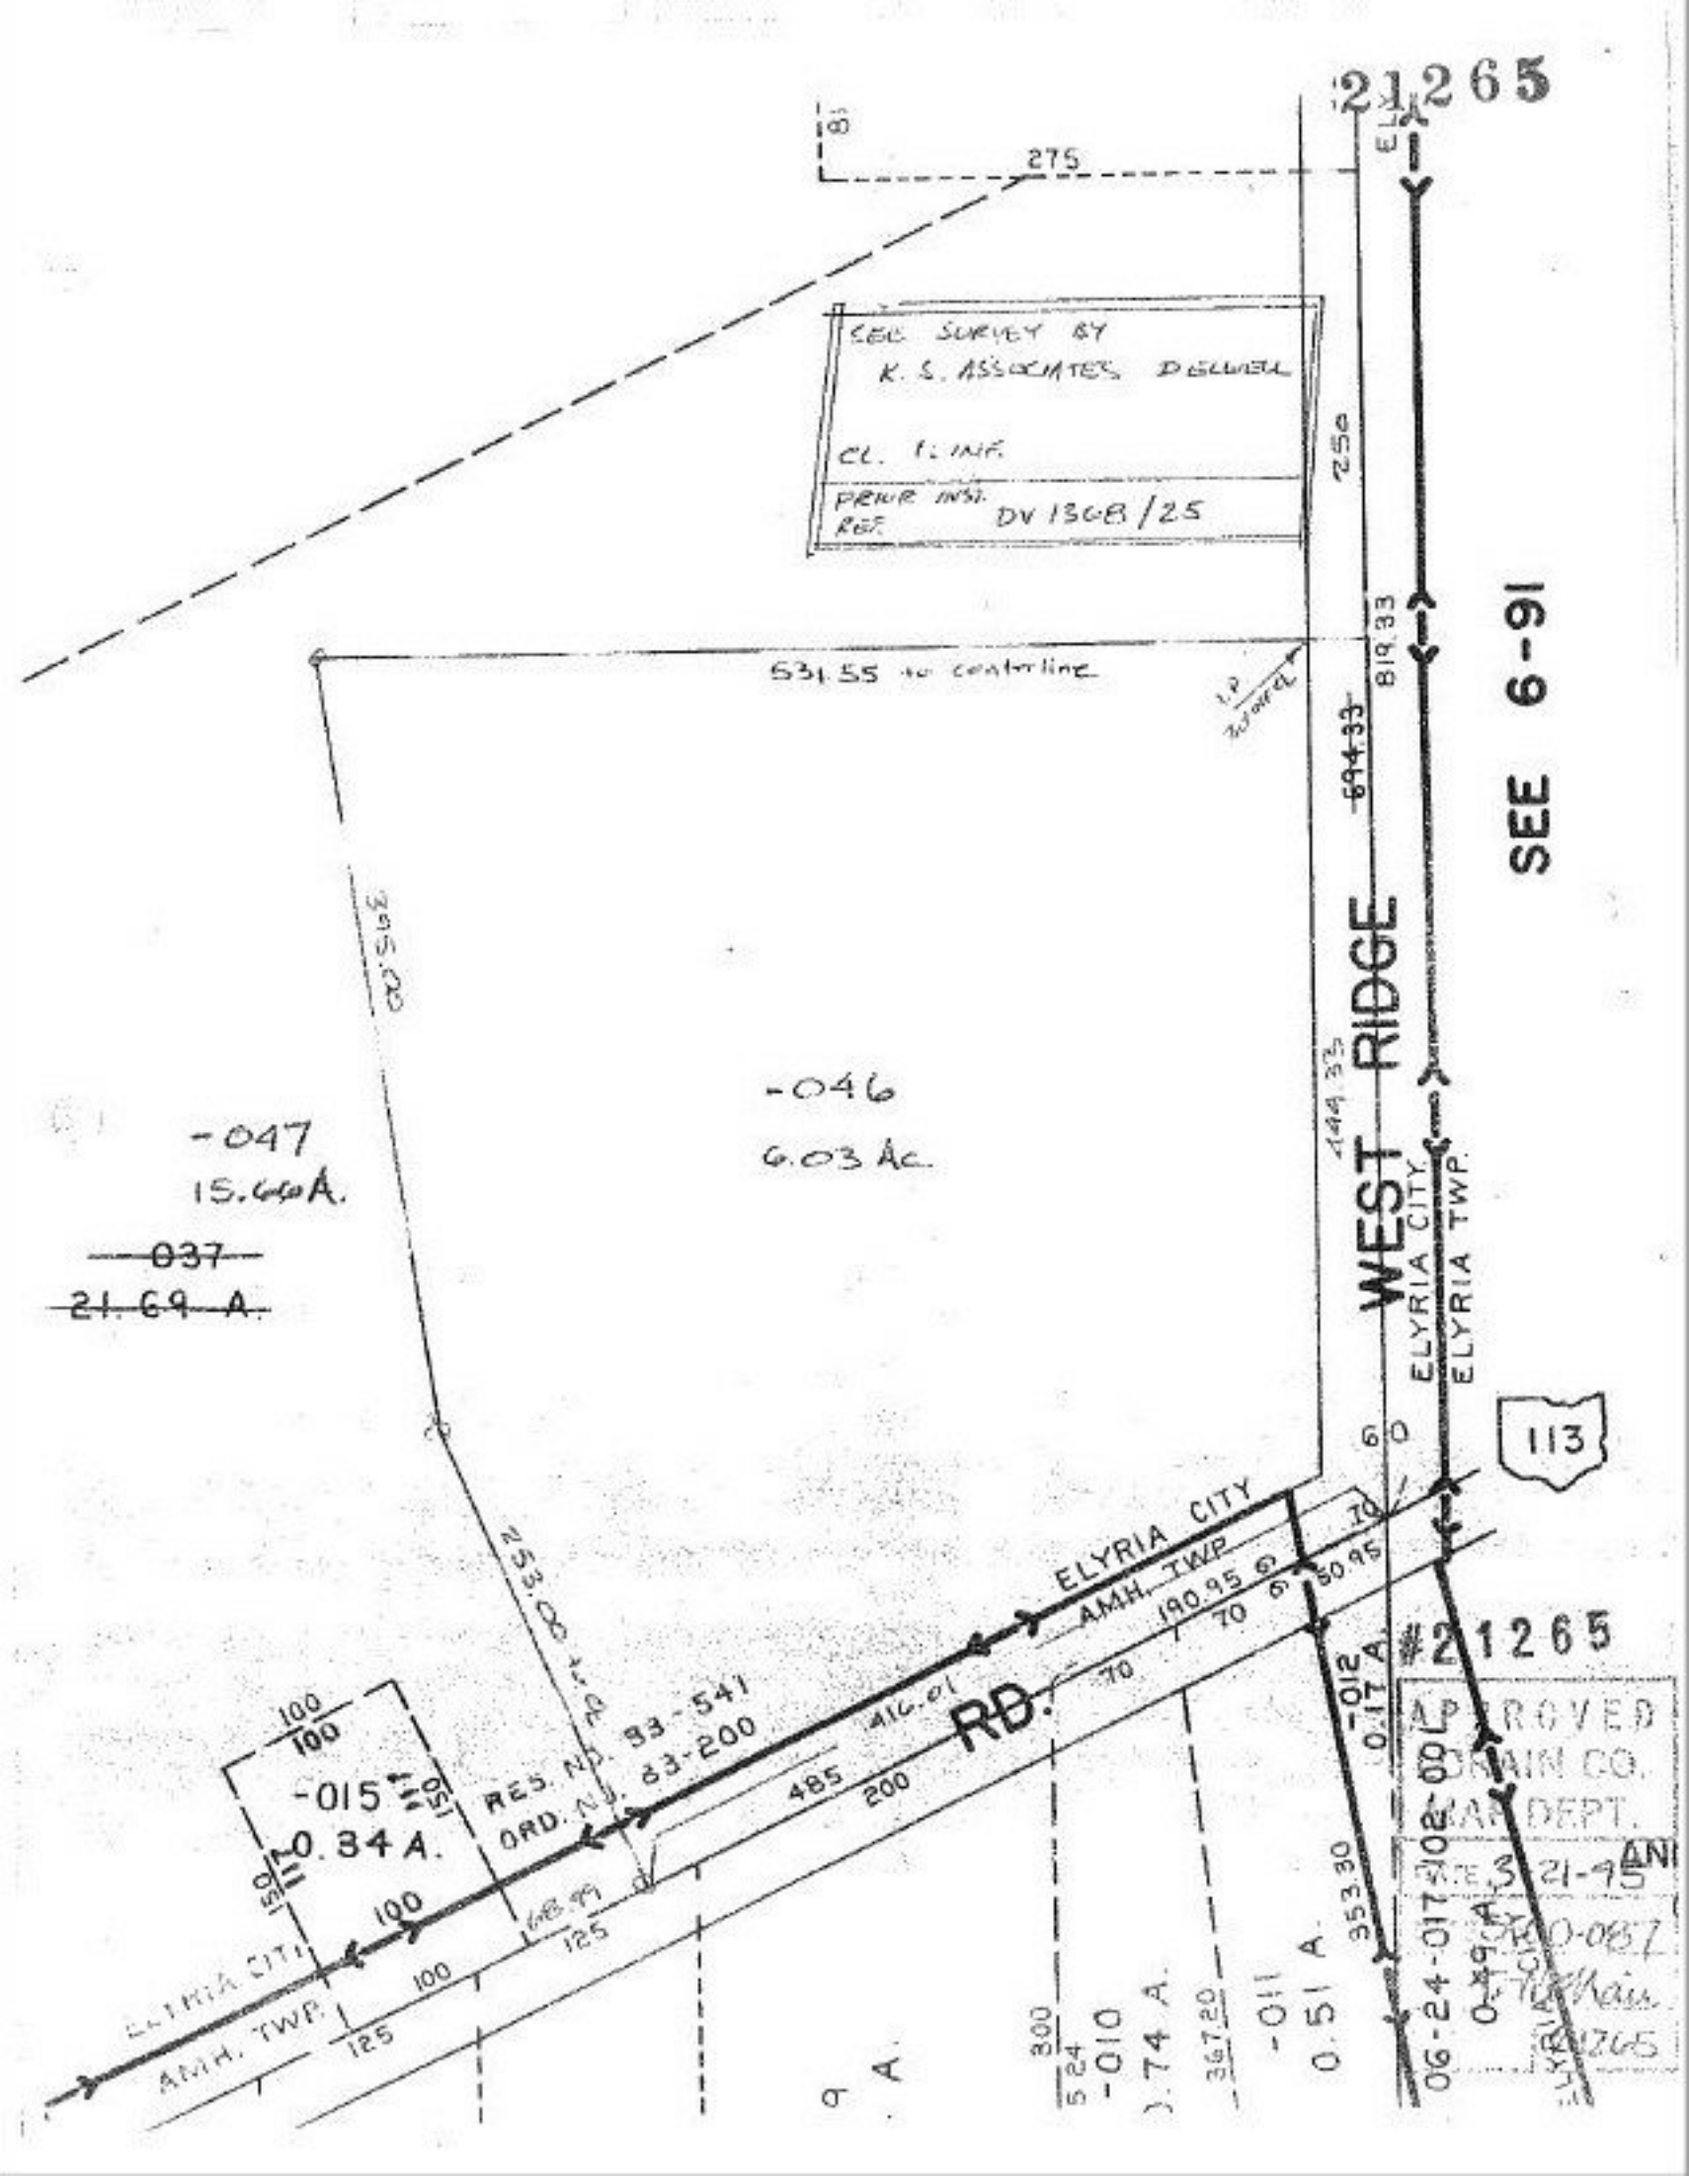
21265
SEE SURVEY BY
K. S. ASSOCIATES DELAWARE
CL. LINE
PRIOR INST. REF. DV 1308/25
275
250
819.33
694.33
531.55 to centerline
I.P. Found
SEE 6-91
WEST RIDGE
ELYRIA CITY
ELYRIA TWP.
-046
6.03 Ac.
-047
15.66 A.
-037
21.69 A.
-015
0.34 A.
100
150
RES. NO. 93-541
ORD. NO. 83-200
416.01
485
200
RD.
ELYRIA CITY
AMH. TWP.
190.95
70
50.95
-012
0.17 A.
353.30
-011
0.51 A.
-010
0.74 A.
9 A.
125
100
113
APPROVED
LAND DEPT.
06-24-02
0.49 A.
ELYRIA