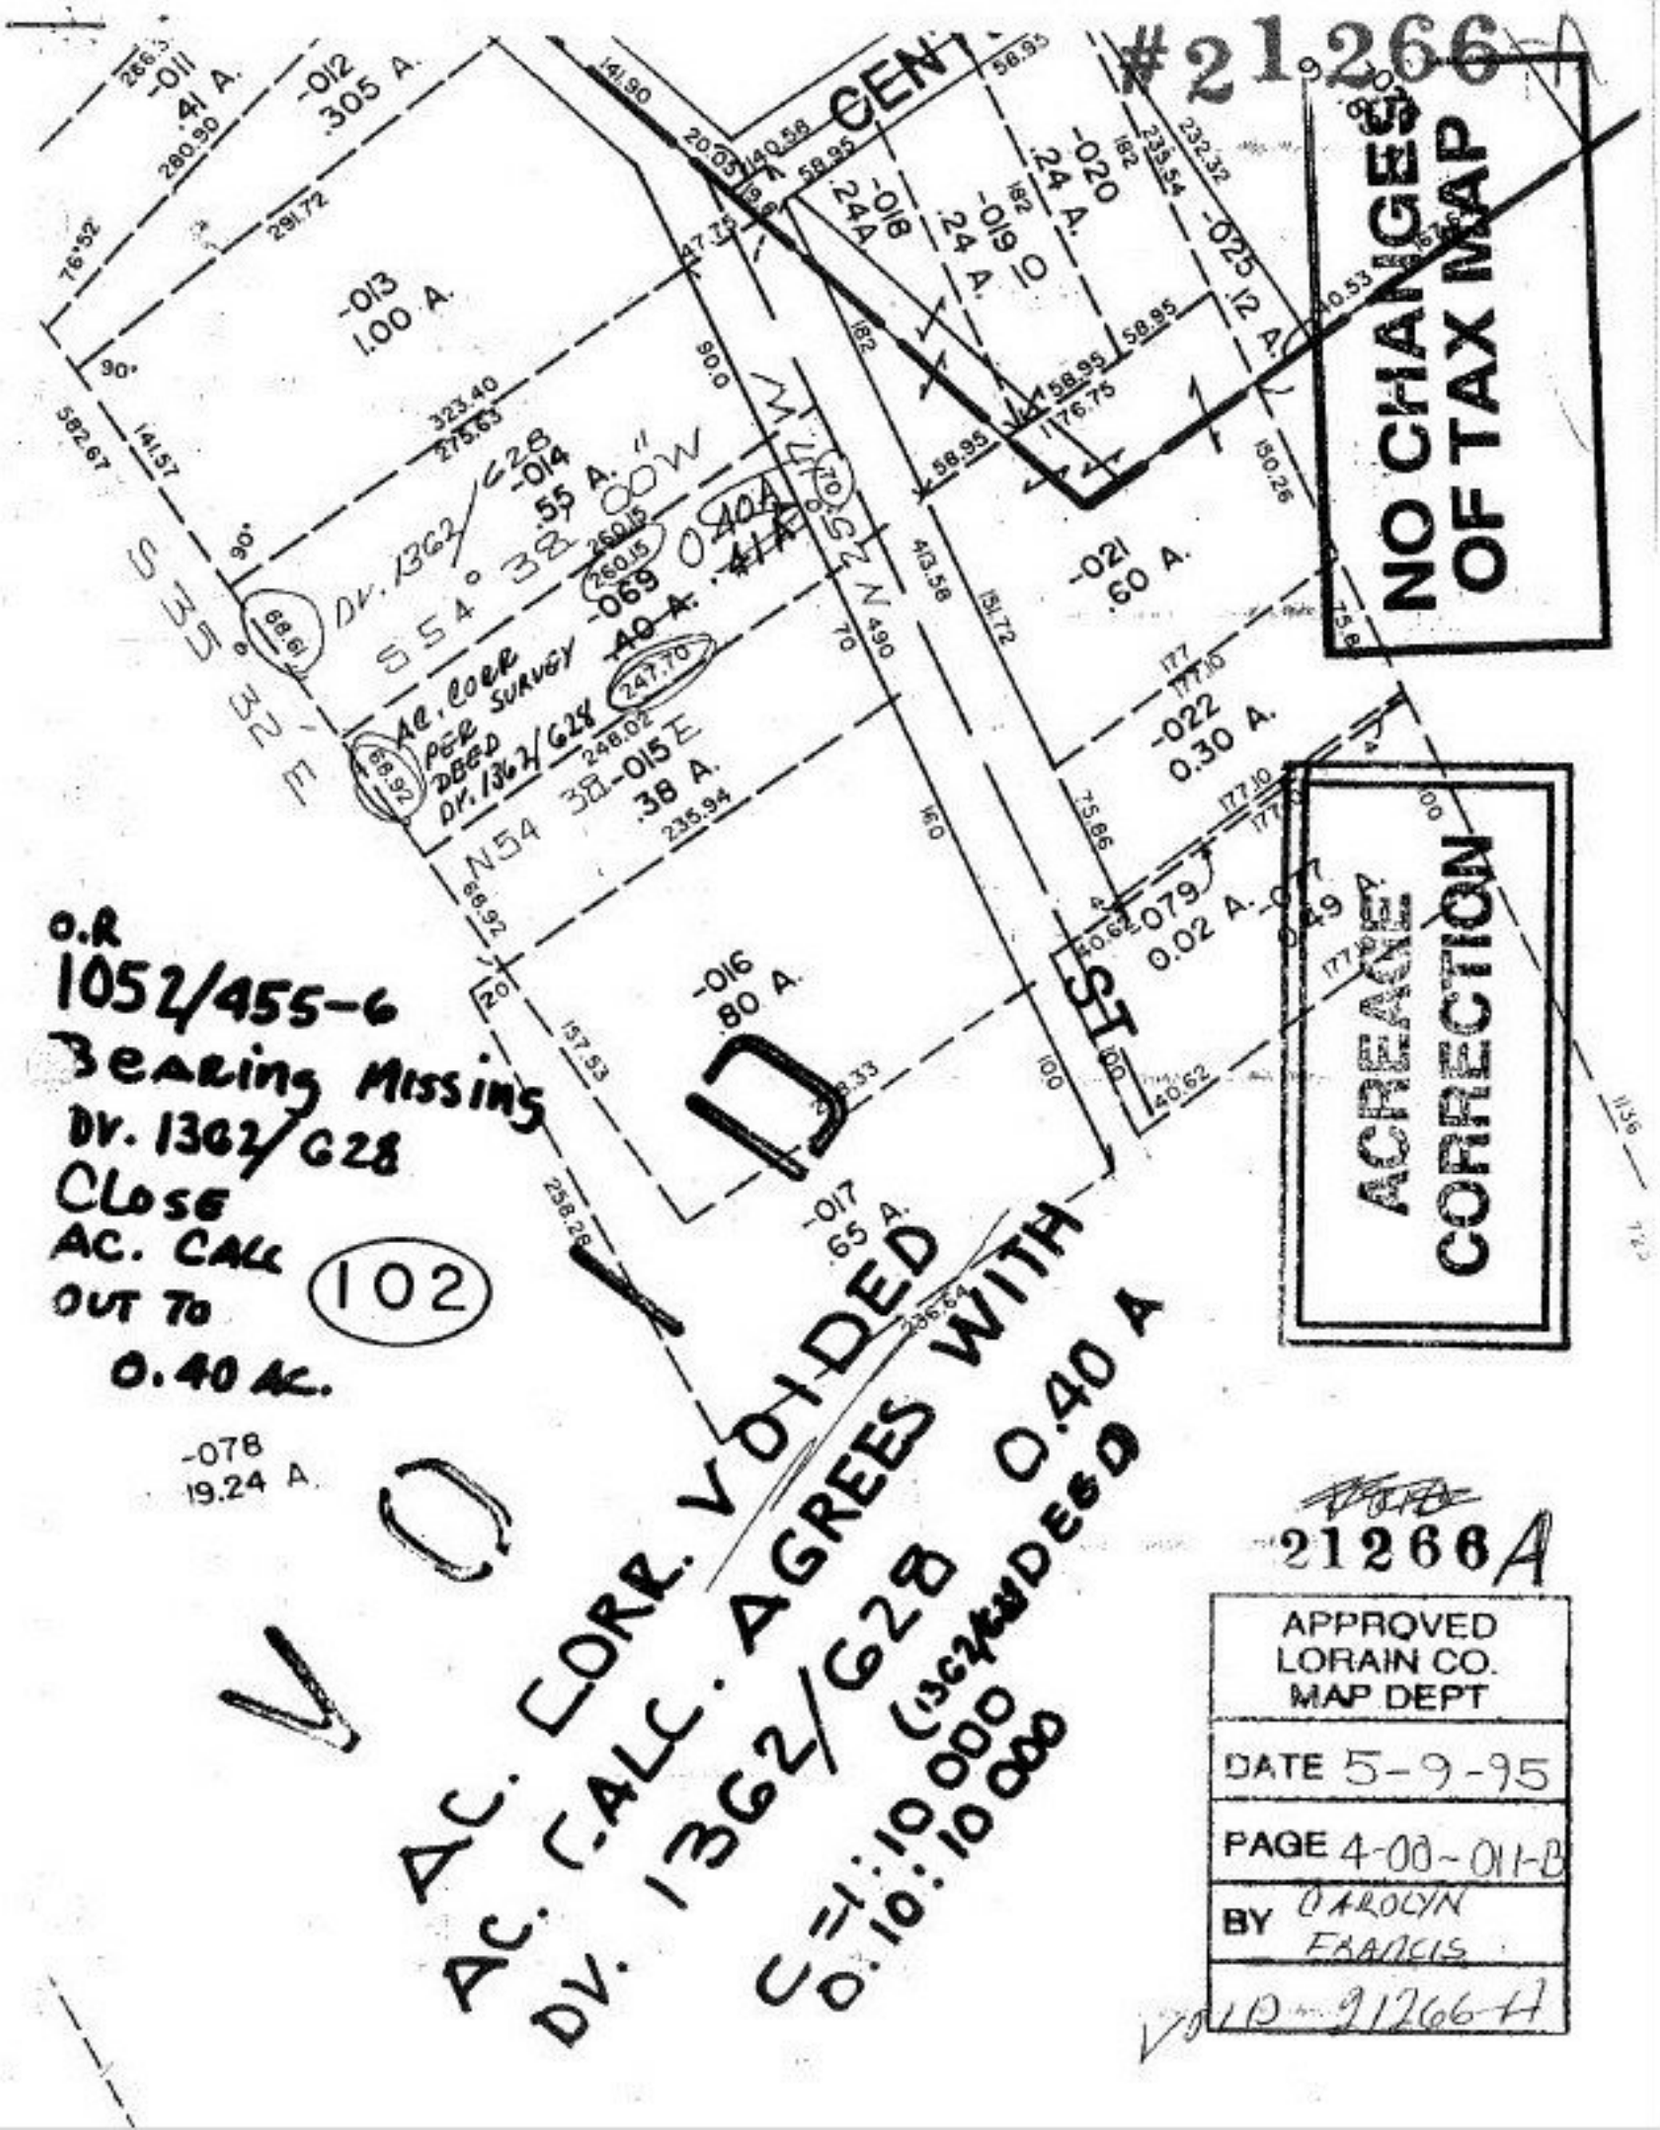
#21266
NO CHANGES OF TAX MAP
ACREAGE CORRECTION
-011 .41 A.
-012 .305 A.
-013 1.00 A.
-014 .55 A.
-015 .38 A.
-016 .80 A.
-017 .65 A.
-018 .24 A.
-019 .24 A.
-020 .24 A.
-021 .60 A.
-022 0.30 A.
-025 .12 A.
-069 .40 A.
-079 0.02 A.
-078 19.24 A.
CEN
ST
S 35° 32' E
N 54° 38' 00" W
O.R 1052/455-6
Bearing Missing
DV. 1362/628
Close
AC. CALC
OUT TO
0.40 AC.
102
VOIDED
AC. CORR. VOIDED
AC. CALC. AGREES WITH
DV. 1362/628 0.40 A
C=1":10.000
0.10:10.000
21266A
APPROVED
LORAIN CO.
MAP DEPT
DATE 5-9-95
PAGE 4-00-011-B
BY CAROLYN FRANCIS
VOID-21266-A