21266

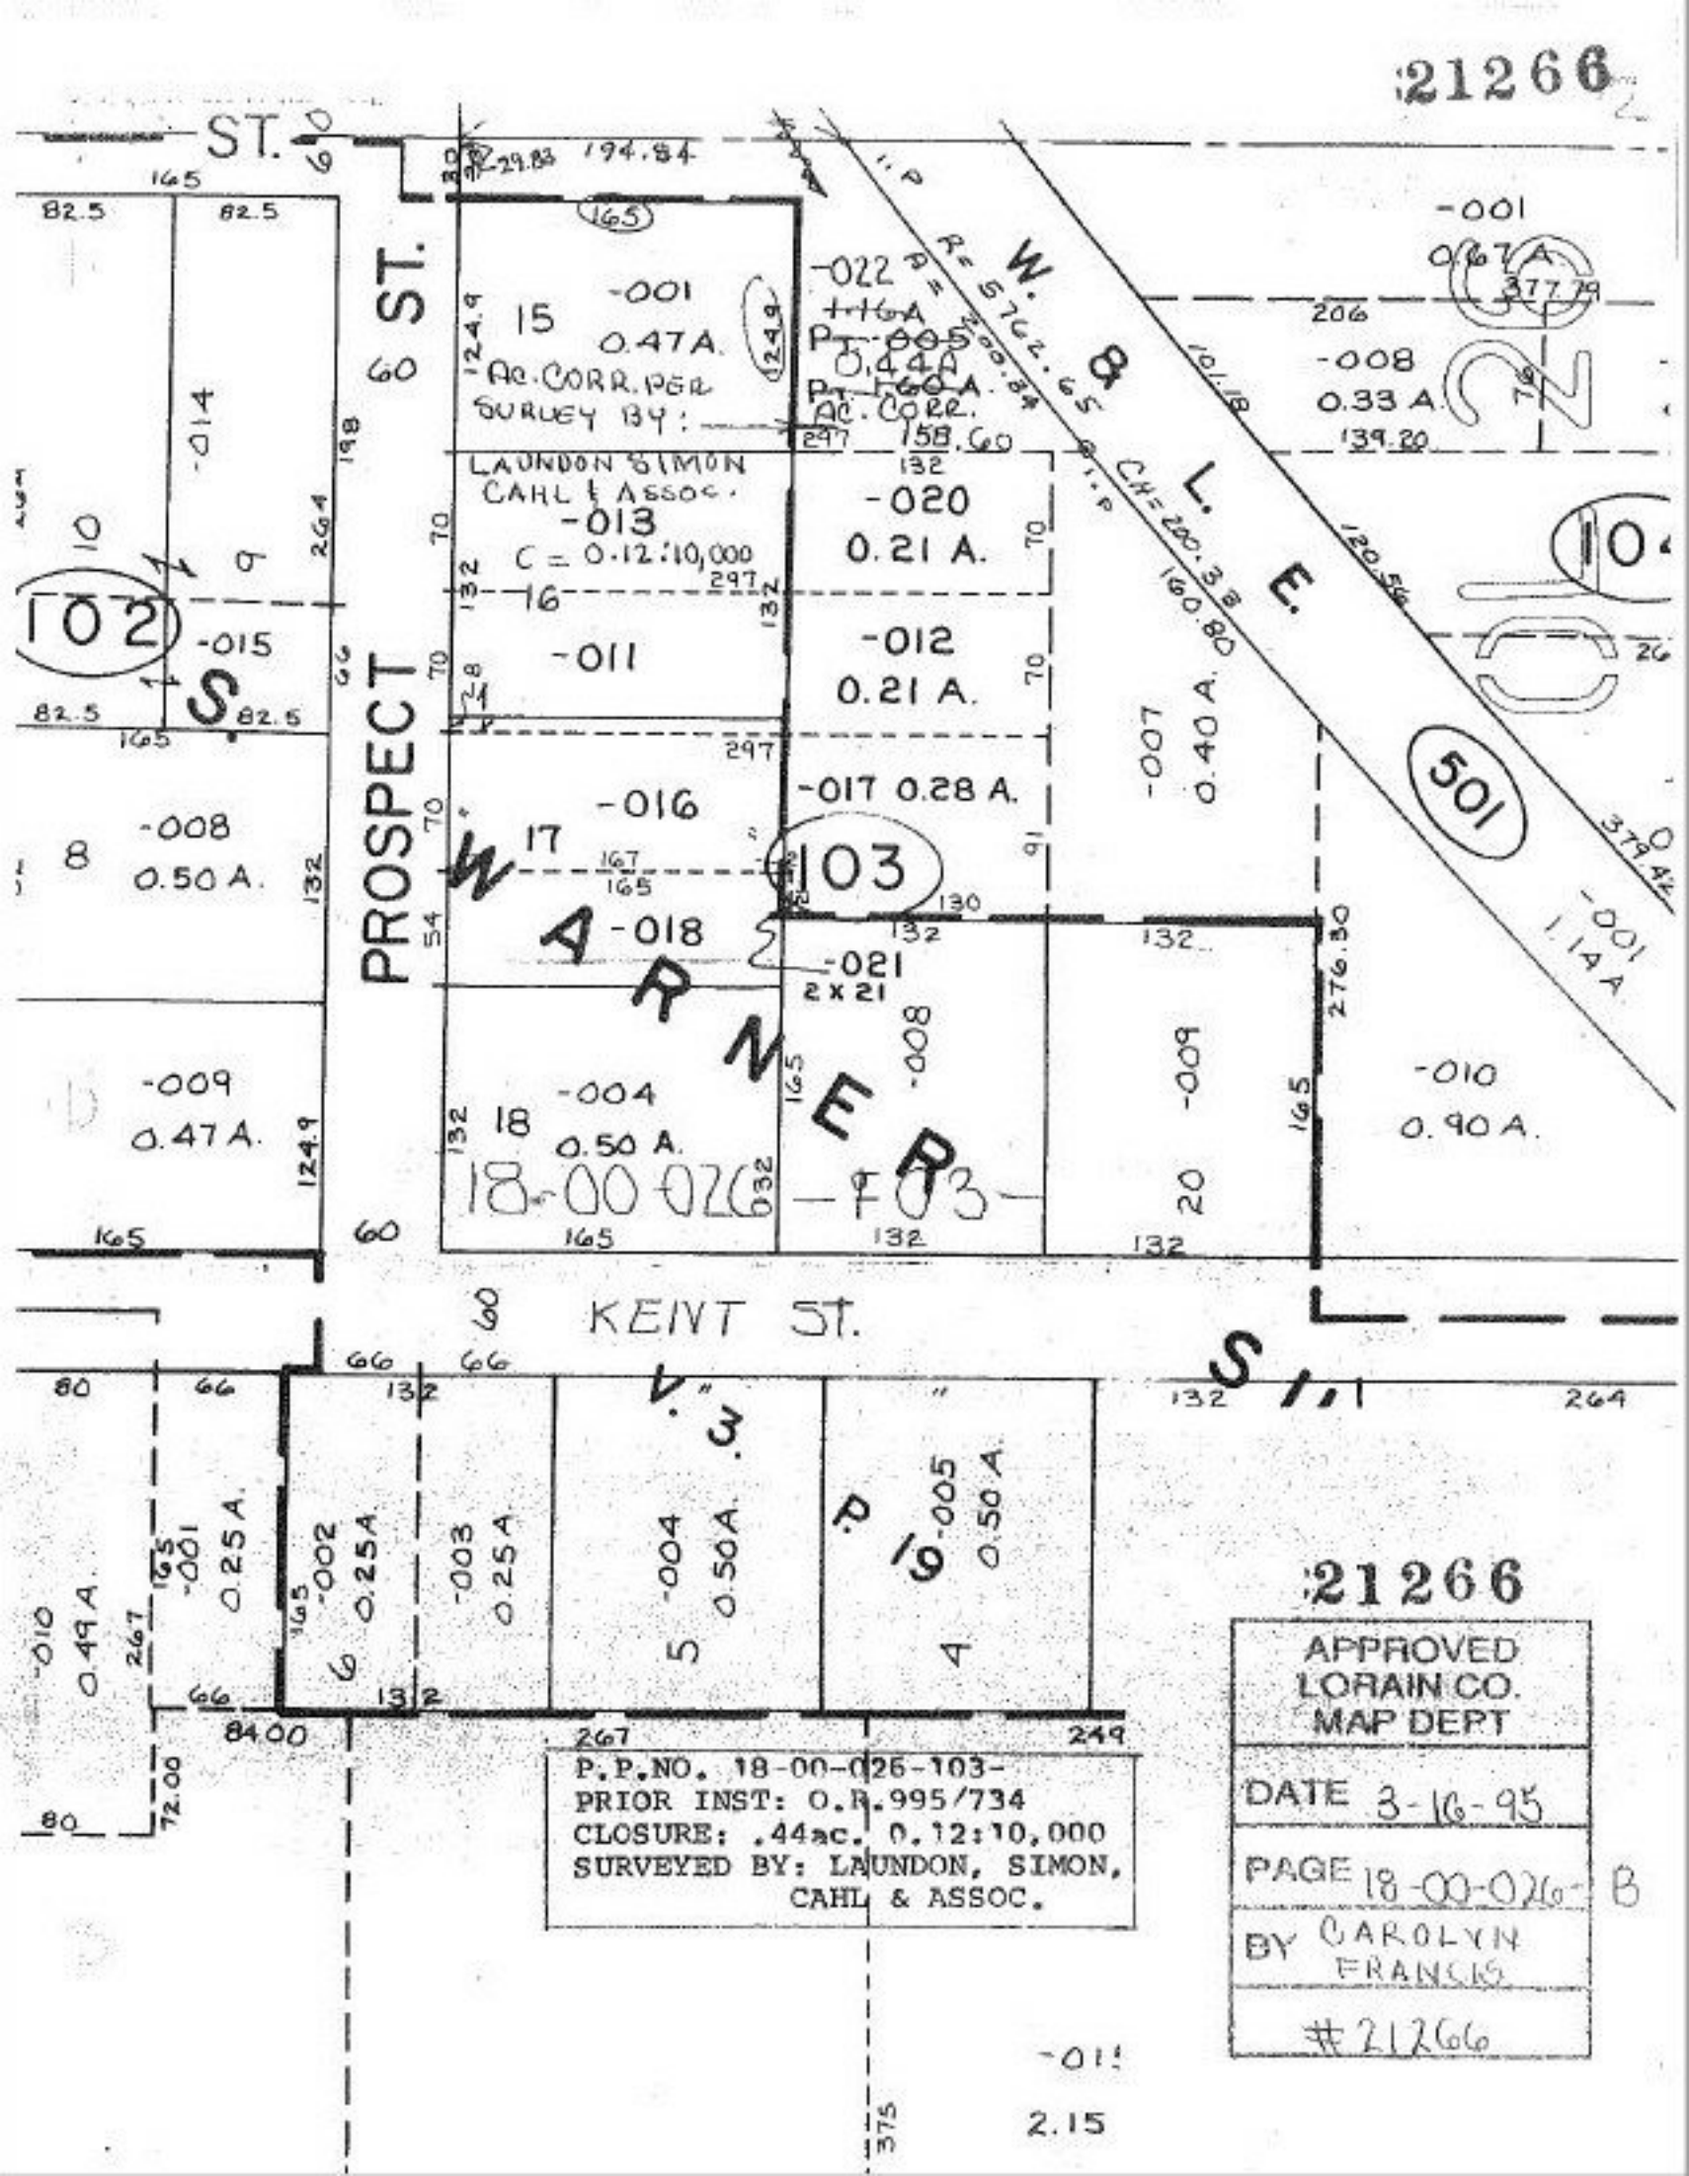

P.P.NO. 18-00-026-103-
PRIOR INST: O.R.995/734
CLOSURE: .44ac. 0.12:10,000
SURVEYED BY: LAUNDON, SIMON, CAHL & ASSOC.

21266

APPROVED
LORAIN CO.
MAP DEPT

DATE 3-16-95

PAGE 18-00-026-B

BY CAROLYN FRANCIS

#21266