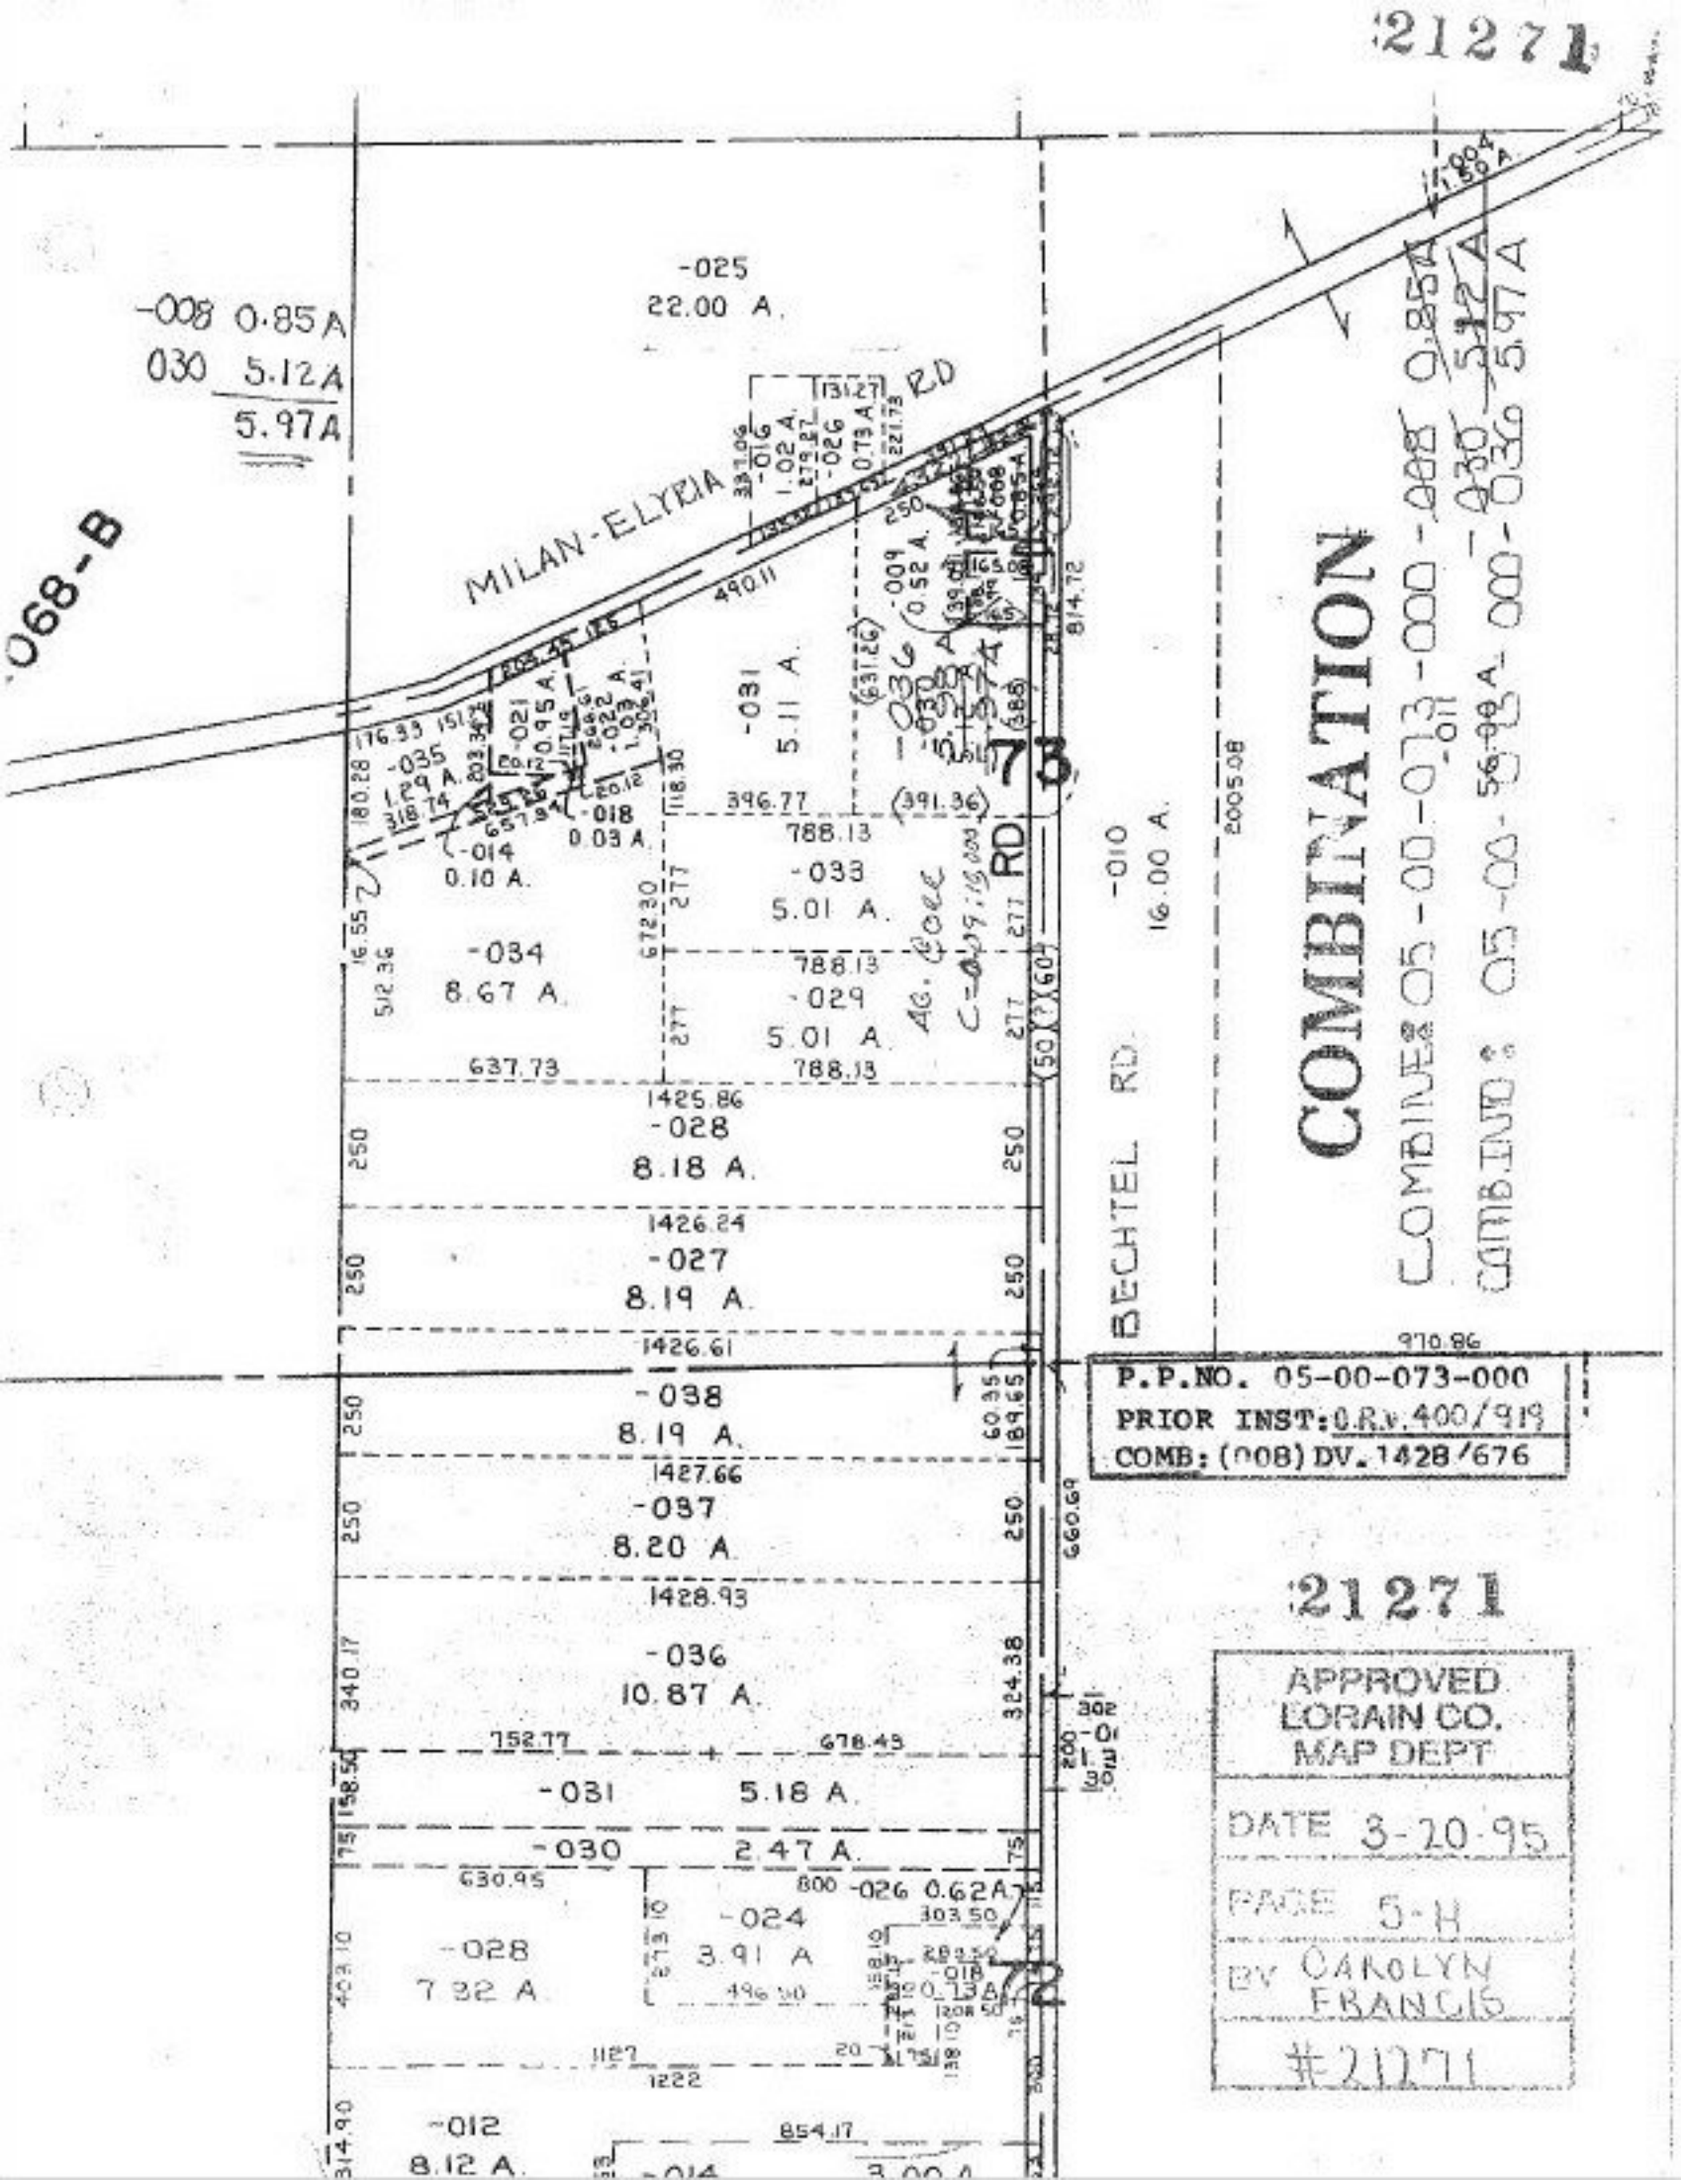
-008 0.85 A
030 5.12 A
5.97 A
-025
22.00 A.
MILAN-ELYRIA RD
068-B
-035
3.29 A.
-021
0.95 A.
-023
1.02 A.
-031
5.11 A.
-036
5.37 A.
-009
0.52 A.
-016
1.02 A.
-026
0.73 A.
-018
0.03 A.
-014
0.10 A.
-034
8.67 A.
-033
5.01 A.
-029
5.01 A.
-028
8.18 A.
-027
8.19 A.
-038
8.19 A.
-037
8.20 A.
-036
10.87 A.
-031
5.18 A.
-030
2.47 A.
-026 0.62A
-024
3.91 A
-028
7.32 A
-012
8.12 A.
-010
16.00 A.
AG. Use
C-49; 1600
BECHTEL RD.
COMBINATION
COMBINED 05-00-073-000 - 088 0.85A
-011
-030 5.12A
COMBINED 05-00-56.00A. 000 - 030 5.97A
P.P.NO. 05-00-073-000
PRIOR INST: O.R.v.400/913
COMB: (008) DV. 1428/676
21271
APPROVED
LORAIN CO.
MAP DEPT
DATE 3-20-95
PAGE 5-H
BY CAROLYN FRANCIS
#21271