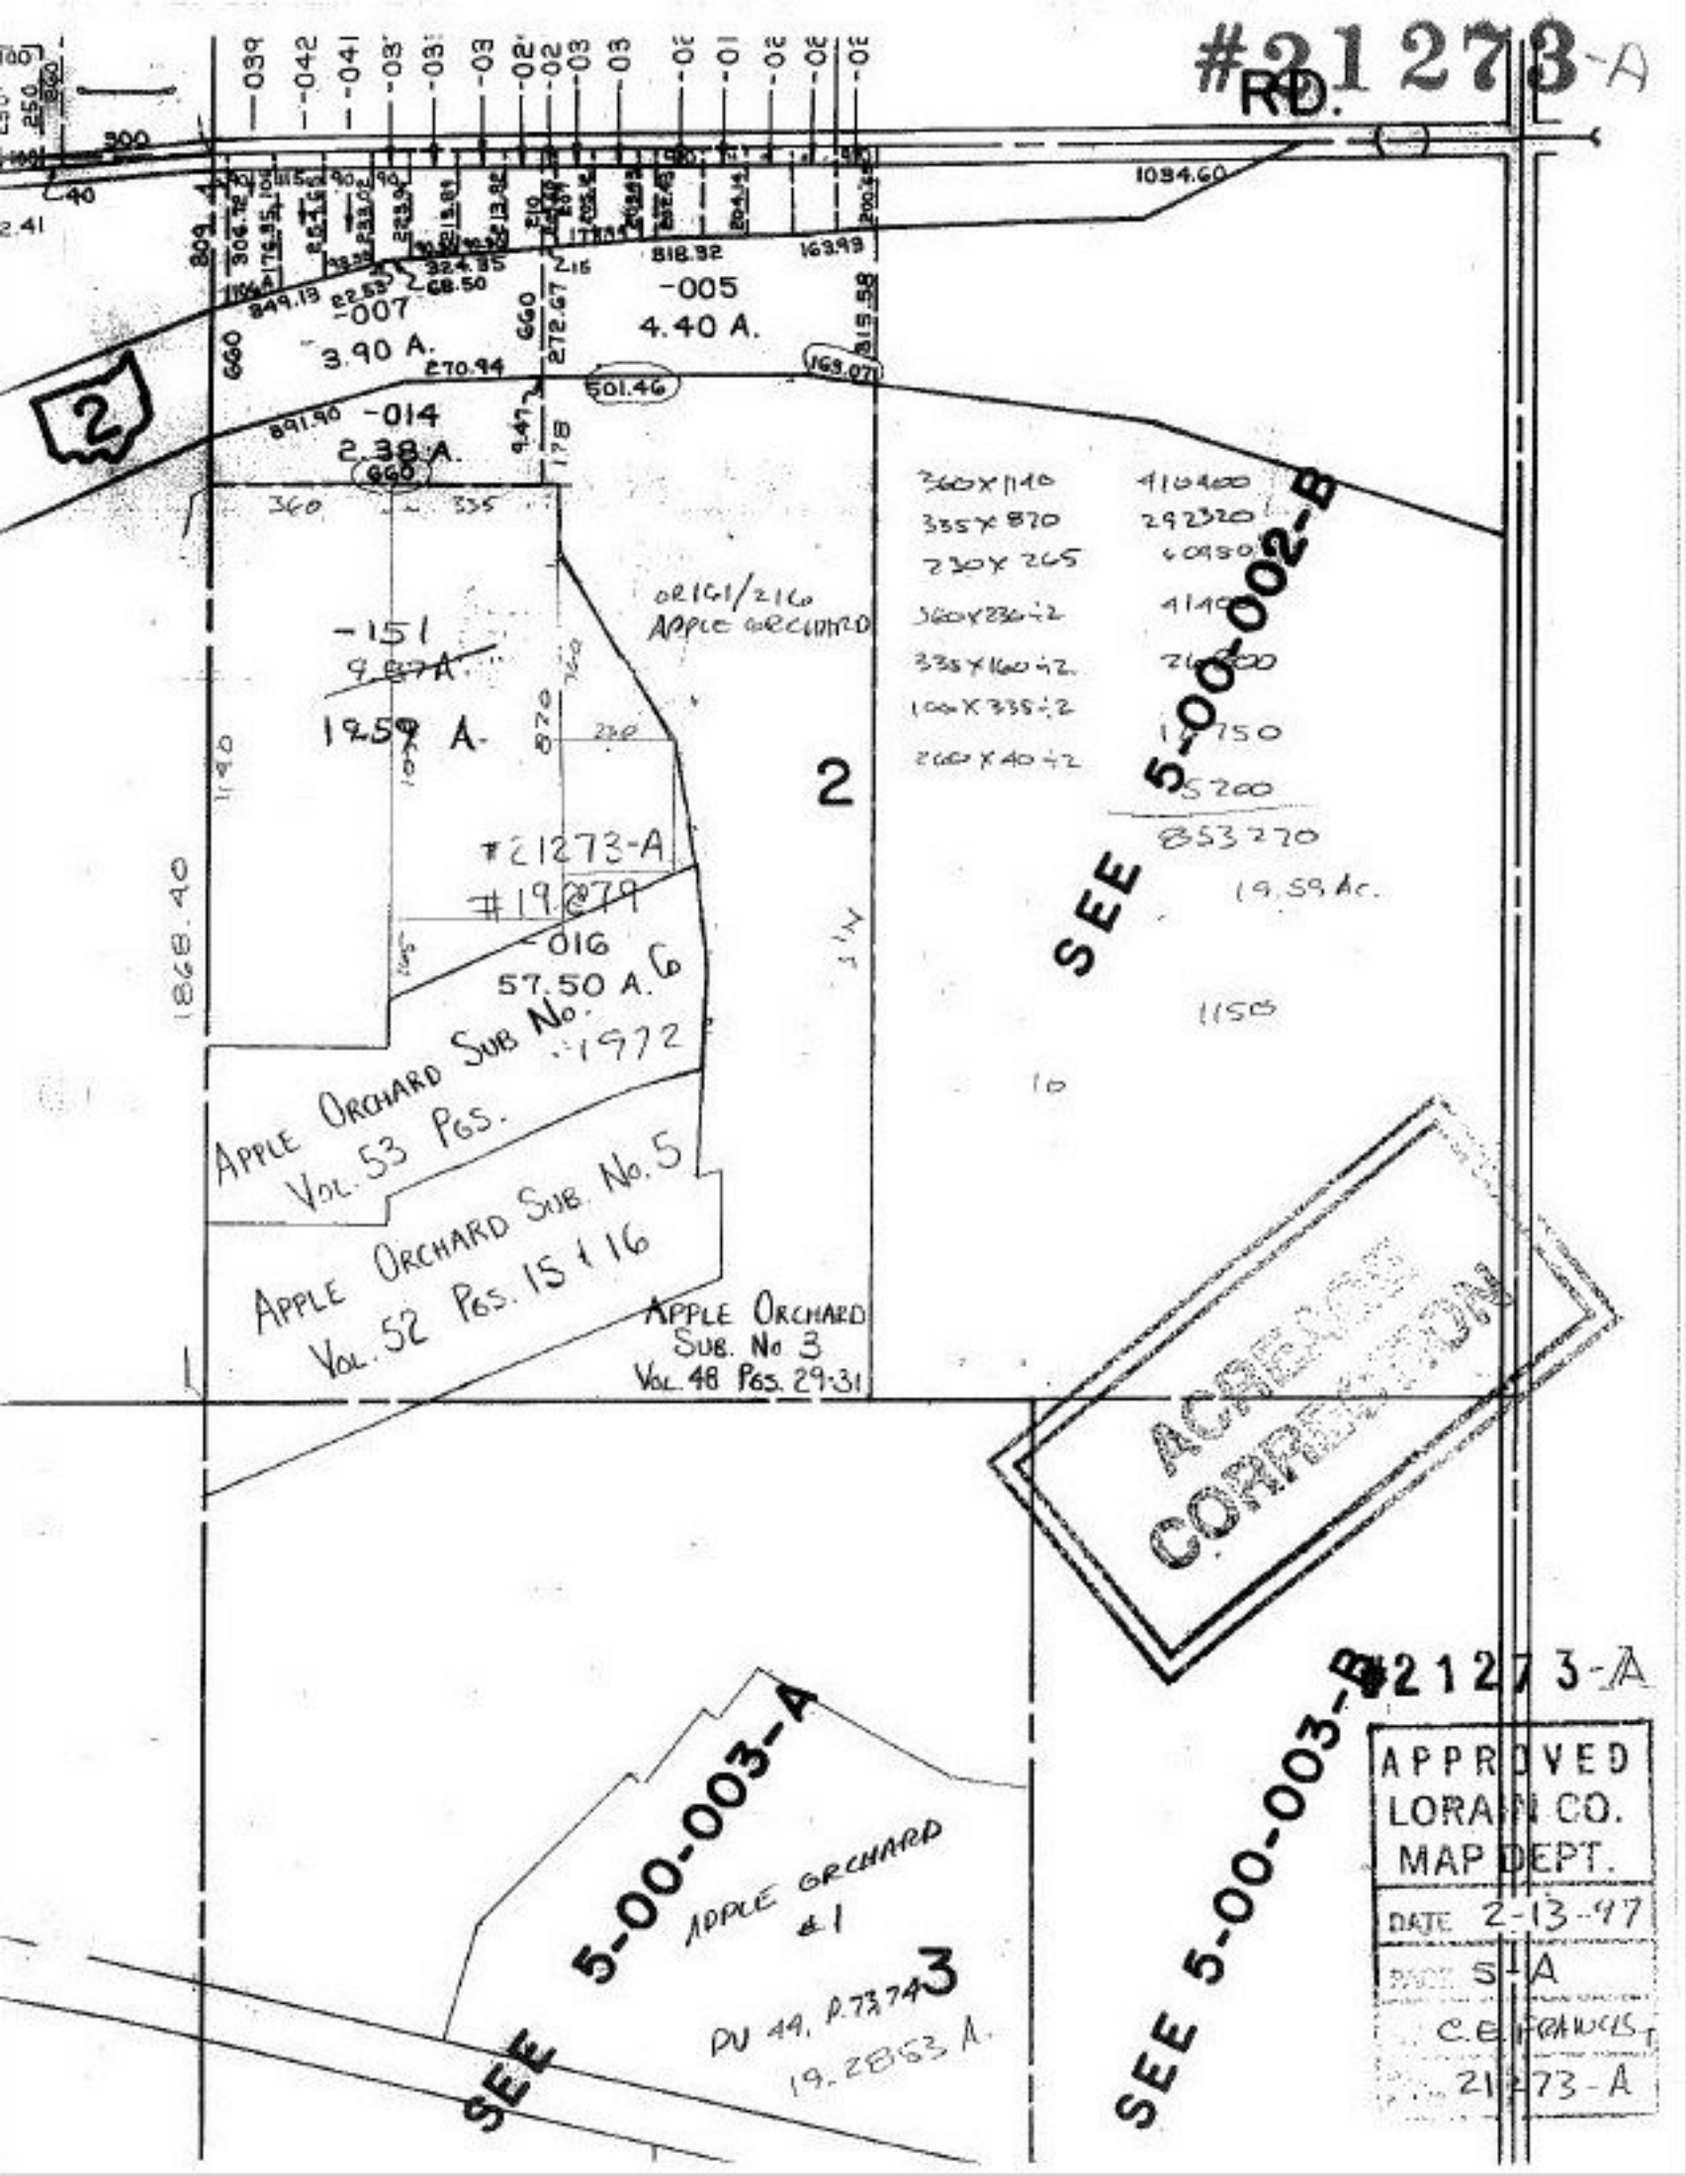
#21273-A
RD.
1034.60
-005
4.40 A.
-007
3.90 A.
-014
2.38 A.
501.46
-151
9.87 A.
19.59 A.
OR 161/216
APPLE ORCHARD
2
#21273-A
#19279
-016
57.50 A.
APPLE ORCHARD SUB No. 6
1972
VOL. 53 PGS.
APPLE ORCHARD SUB. No. 5
VOL. 52 PGS. 15 & 16
APPLE ORCHARD
SUB. No 3
VOL. 48 PGS. 29-31
1868.40
360 X 1140
335 X 870
230 X 265
360 X 230 ÷ 2
335 X 160 ÷ 2
100 X 335 ÷ 2
260 X 40 ÷ 2
410400
292320
60950
4140
26800
14750
5200
853270
19.59 Ac.
1150
SEE 5-00-002-B
ACREAGE CORRECTION
#21273-A
APPROVED
LORAIN CO.
MAP DEPT.
DATE 2-13-97
PAGE 5-A
C.E. FRANCIS
21273-A
SEE 5-00-003-A
APPLE ORCHARD
#1
PV 44, P.73,74
3
19.2853 A.
SEE 5-00-003-B