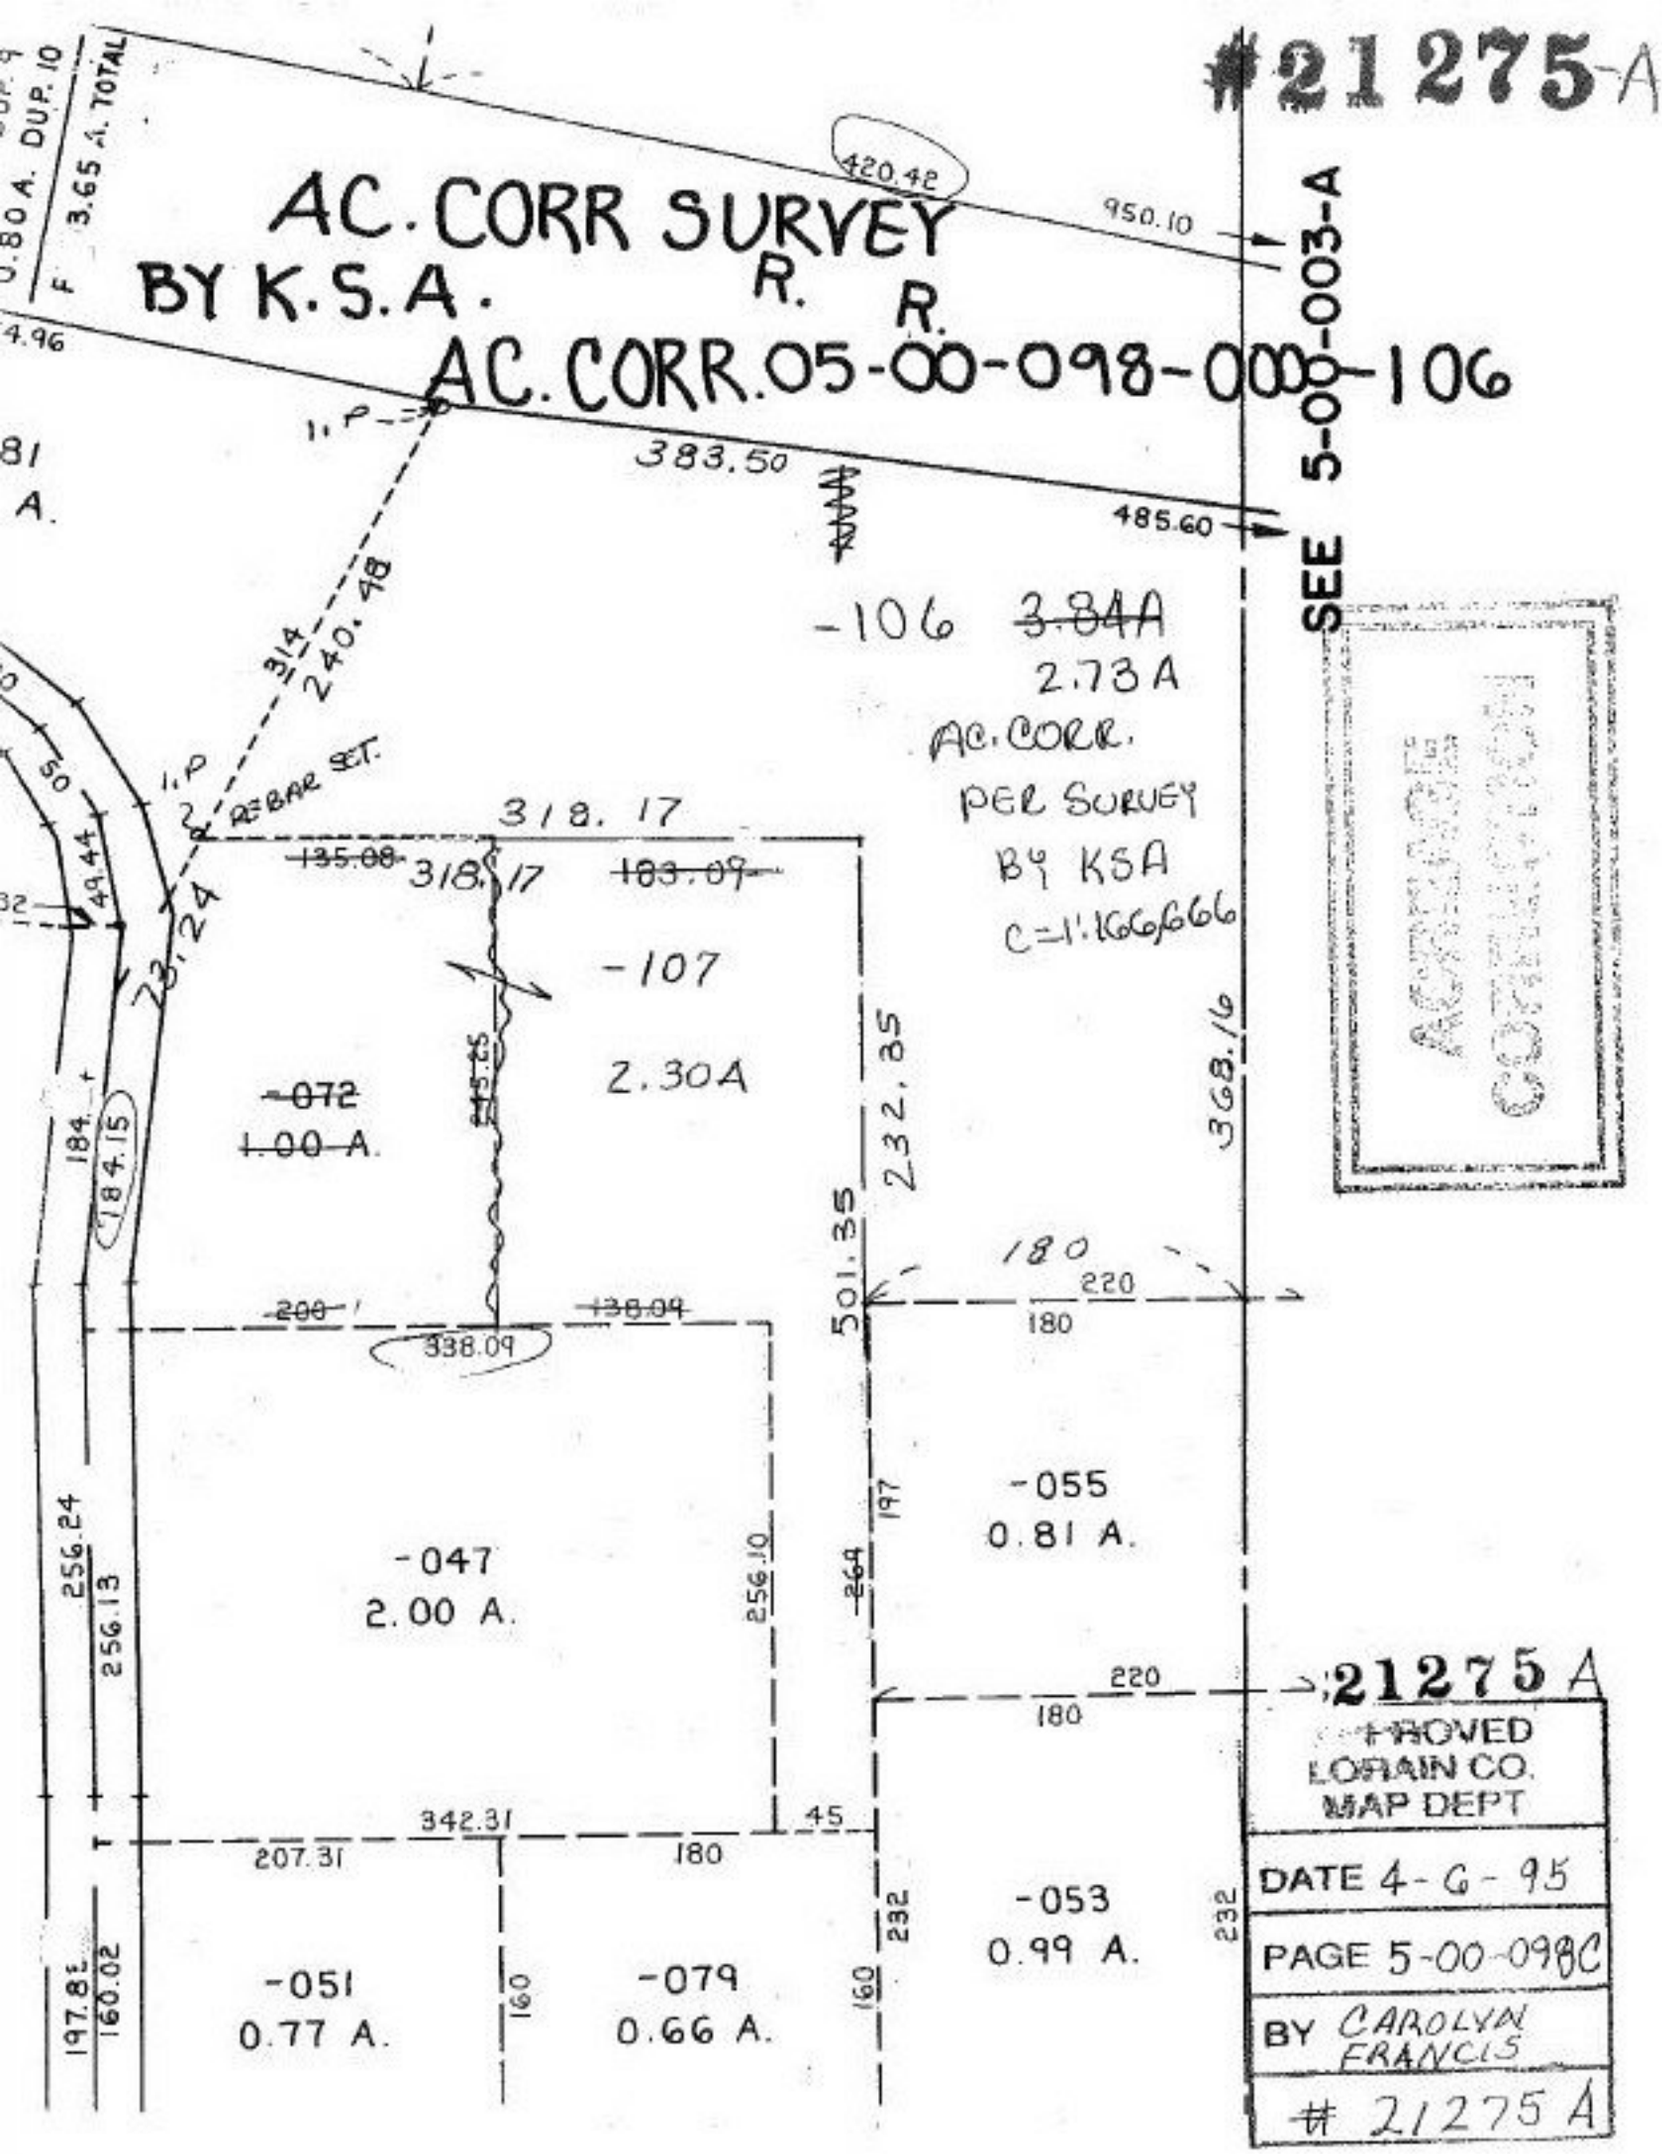
#21275-A
AC. CORR SURVEY
BY K.S.A.
R. R.
AC. CORR. 05-00-098-000-106
SEE 5-00-003-A
420.42
950.10
383.50
485.60
-106 ~~3.84A~~
2.73 A
AC. CORR.
PER SURVEY
BY KSA
C=1:166,666
314
240.48
REBAR SET.
318.17
~~135.08~~
318.17
~~183.09~~
-107
2.30A
~~-072~~
~~1.00 A.~~
232.35
368.16
501.35
180
220
180
~~200~~
~~138.09~~
338.09
-047
2.00 A.
256.10
-055
0.81 A.
197
256.24
256.13
342.31
207.31
180
45
-053
0.99 A.
232
-051
0.77 A.
-079
0.66 A.
160
197.85
160.02
21275 A
APPROVED
LORAIN CO.
MAP DEPT
DATE 4-6-95
PAGE 5-00-098C
BY CAROLYN FRANCIS
21275 A