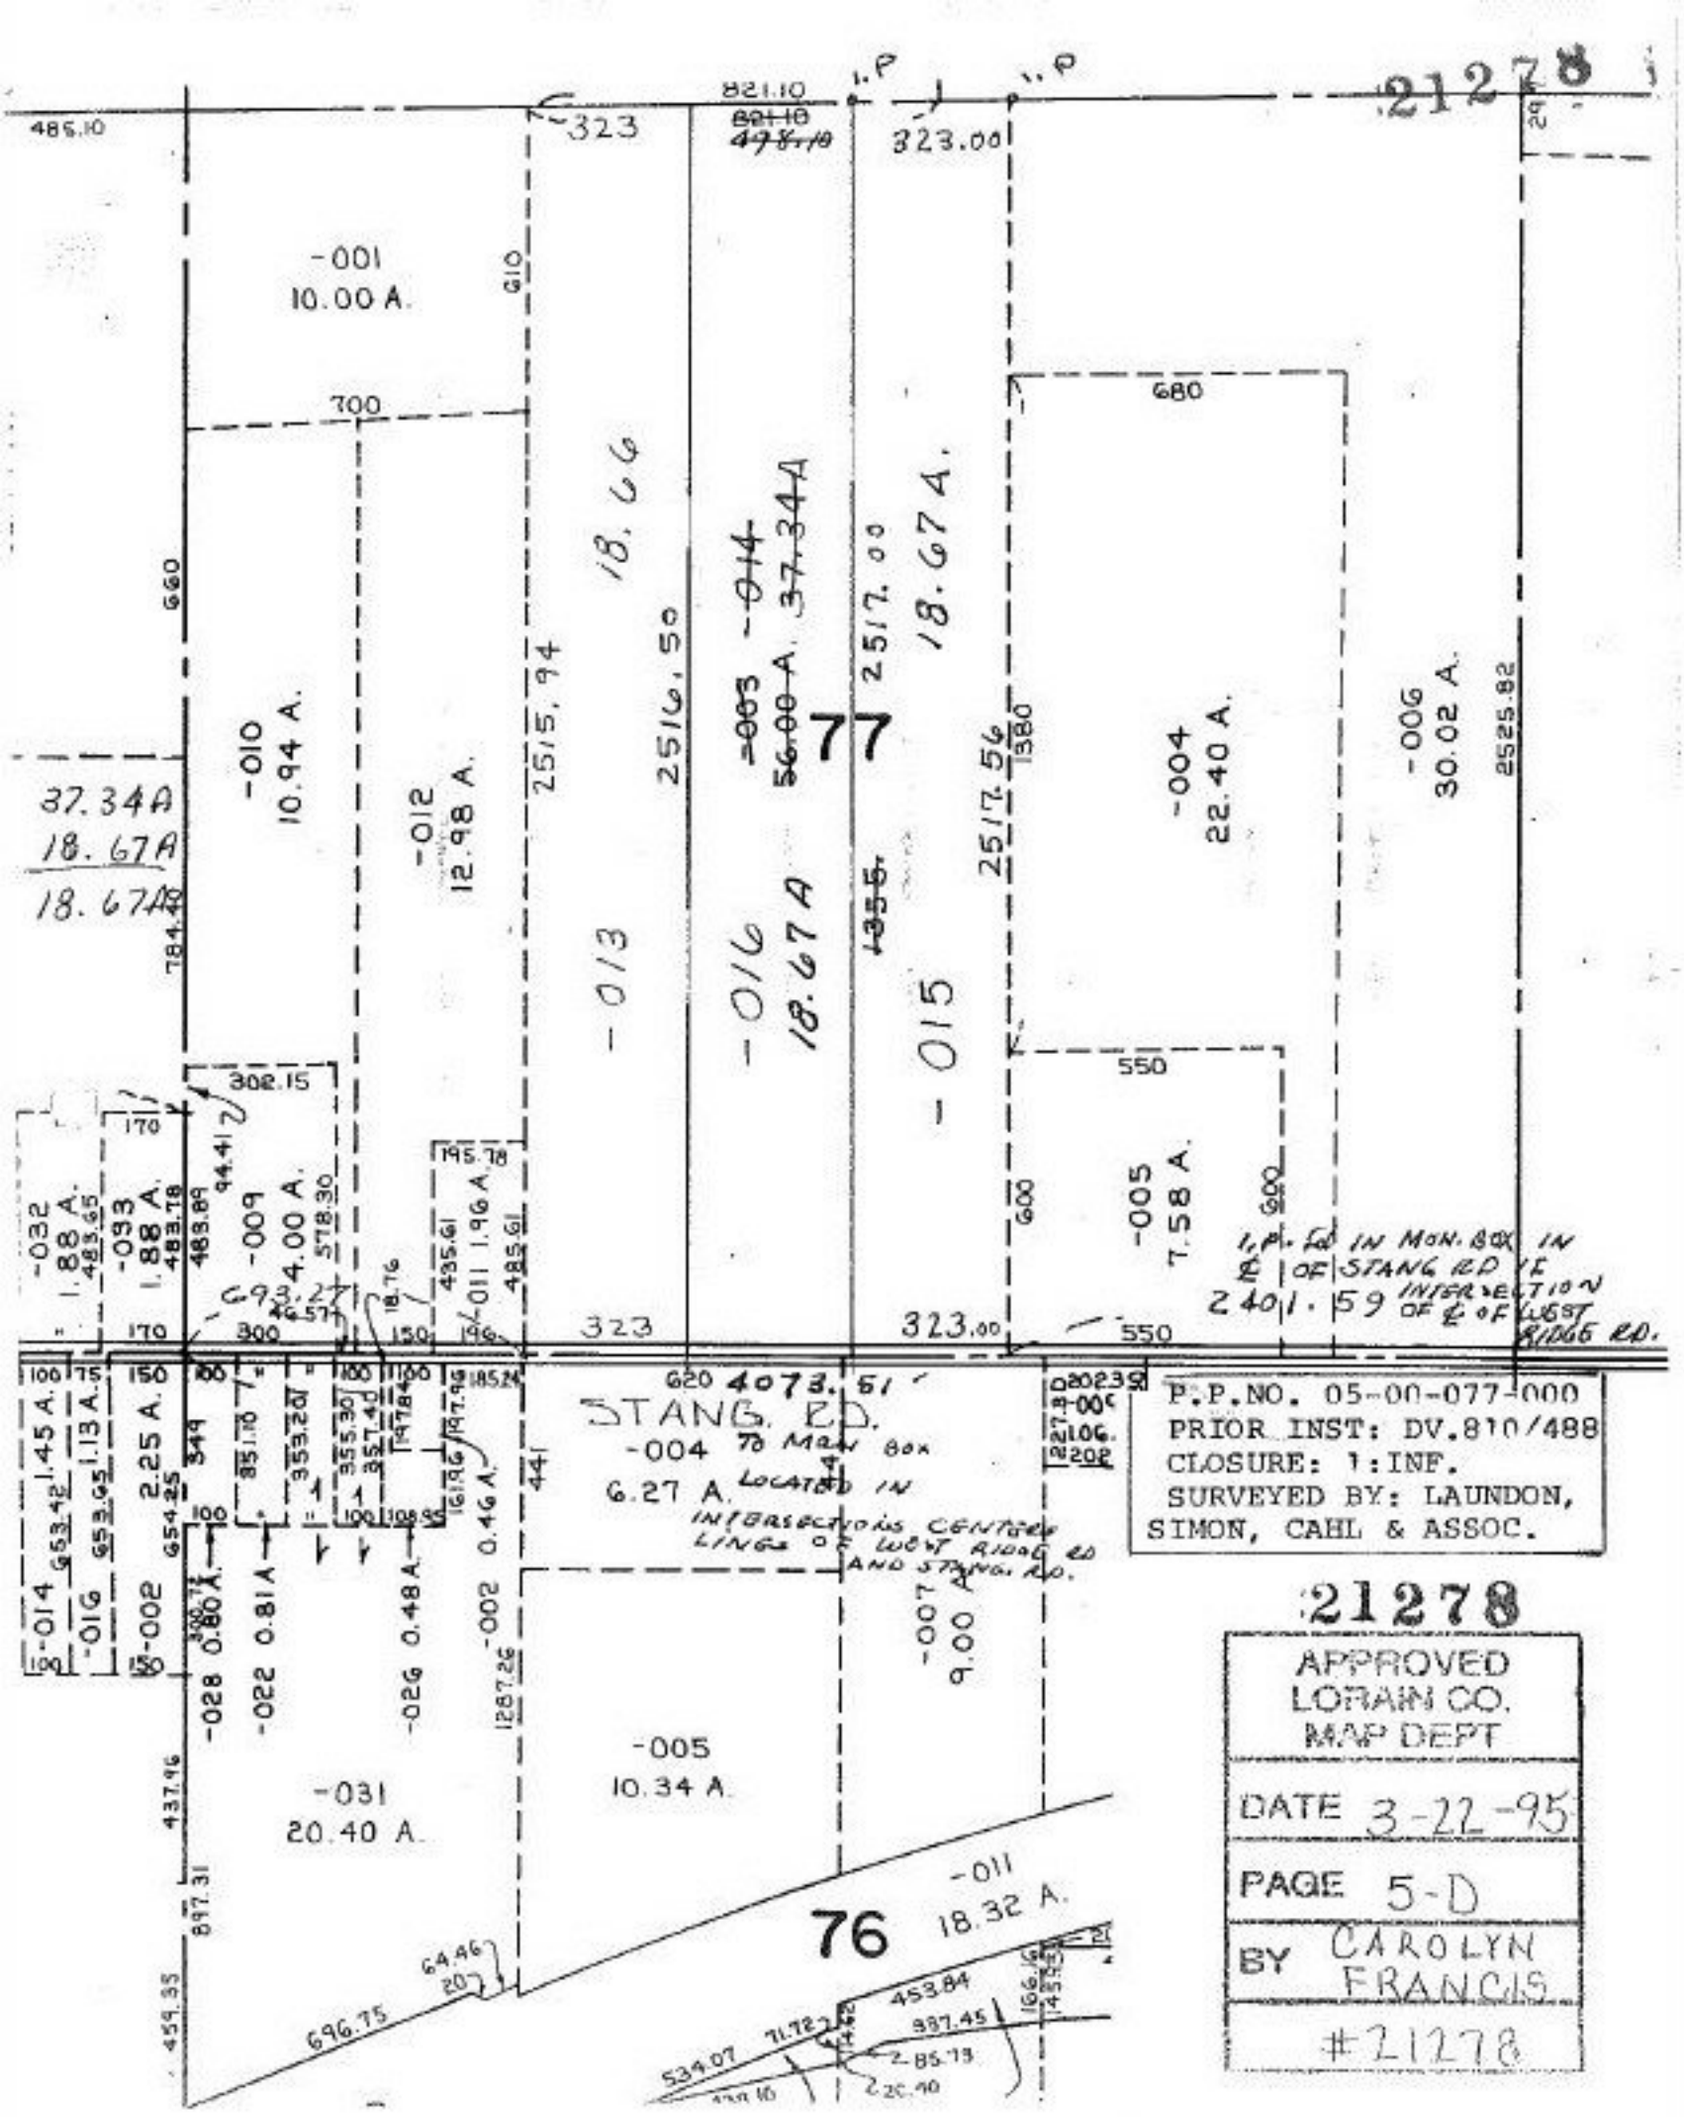
21278
77
76
-001
10.00 A.
-010
10.94 A.
-012
12.98 A.
-013
18.66
-014
37.34A
-015
18.67A
-016
18.67A
-003
56.00 A.
-004
22.40 A.
-005
7.58 A.
-006
30.02 A.
-009
4.00 A.
-011 1.96 A.
-032
1.88 A.
-093
1.88 A.
-002 0.81A
-026 0.48 A.
-028 0.80 A.
-031
20.40 A.
-005
10.34 A.
-011
18.32 A.
-004
6.27 A.
-007
9.00 A.
STANG RD.
I.P. FD IN MON. BOX IN INTERSECTION OF ℄ OF STANG RD & ℄ OF WEST RIDGE RD.
INTERSECTIONS CENTER LINES OF WEST RIDGE RD AND STANG RD.
P.P.NO. 05-00-077-000
PRIOR INST: DV.810/488
CLOSURE: 1:INF.
SURVEYED BY: LAUNDON, SIMON, CAHL & ASSOC.
21278
APPROVED
LORAIN CO.
MAP DEPT
DATE 3-22-95
PAGE 5-D
BY CAROLYN FRANCIS
#21278