#21279-V

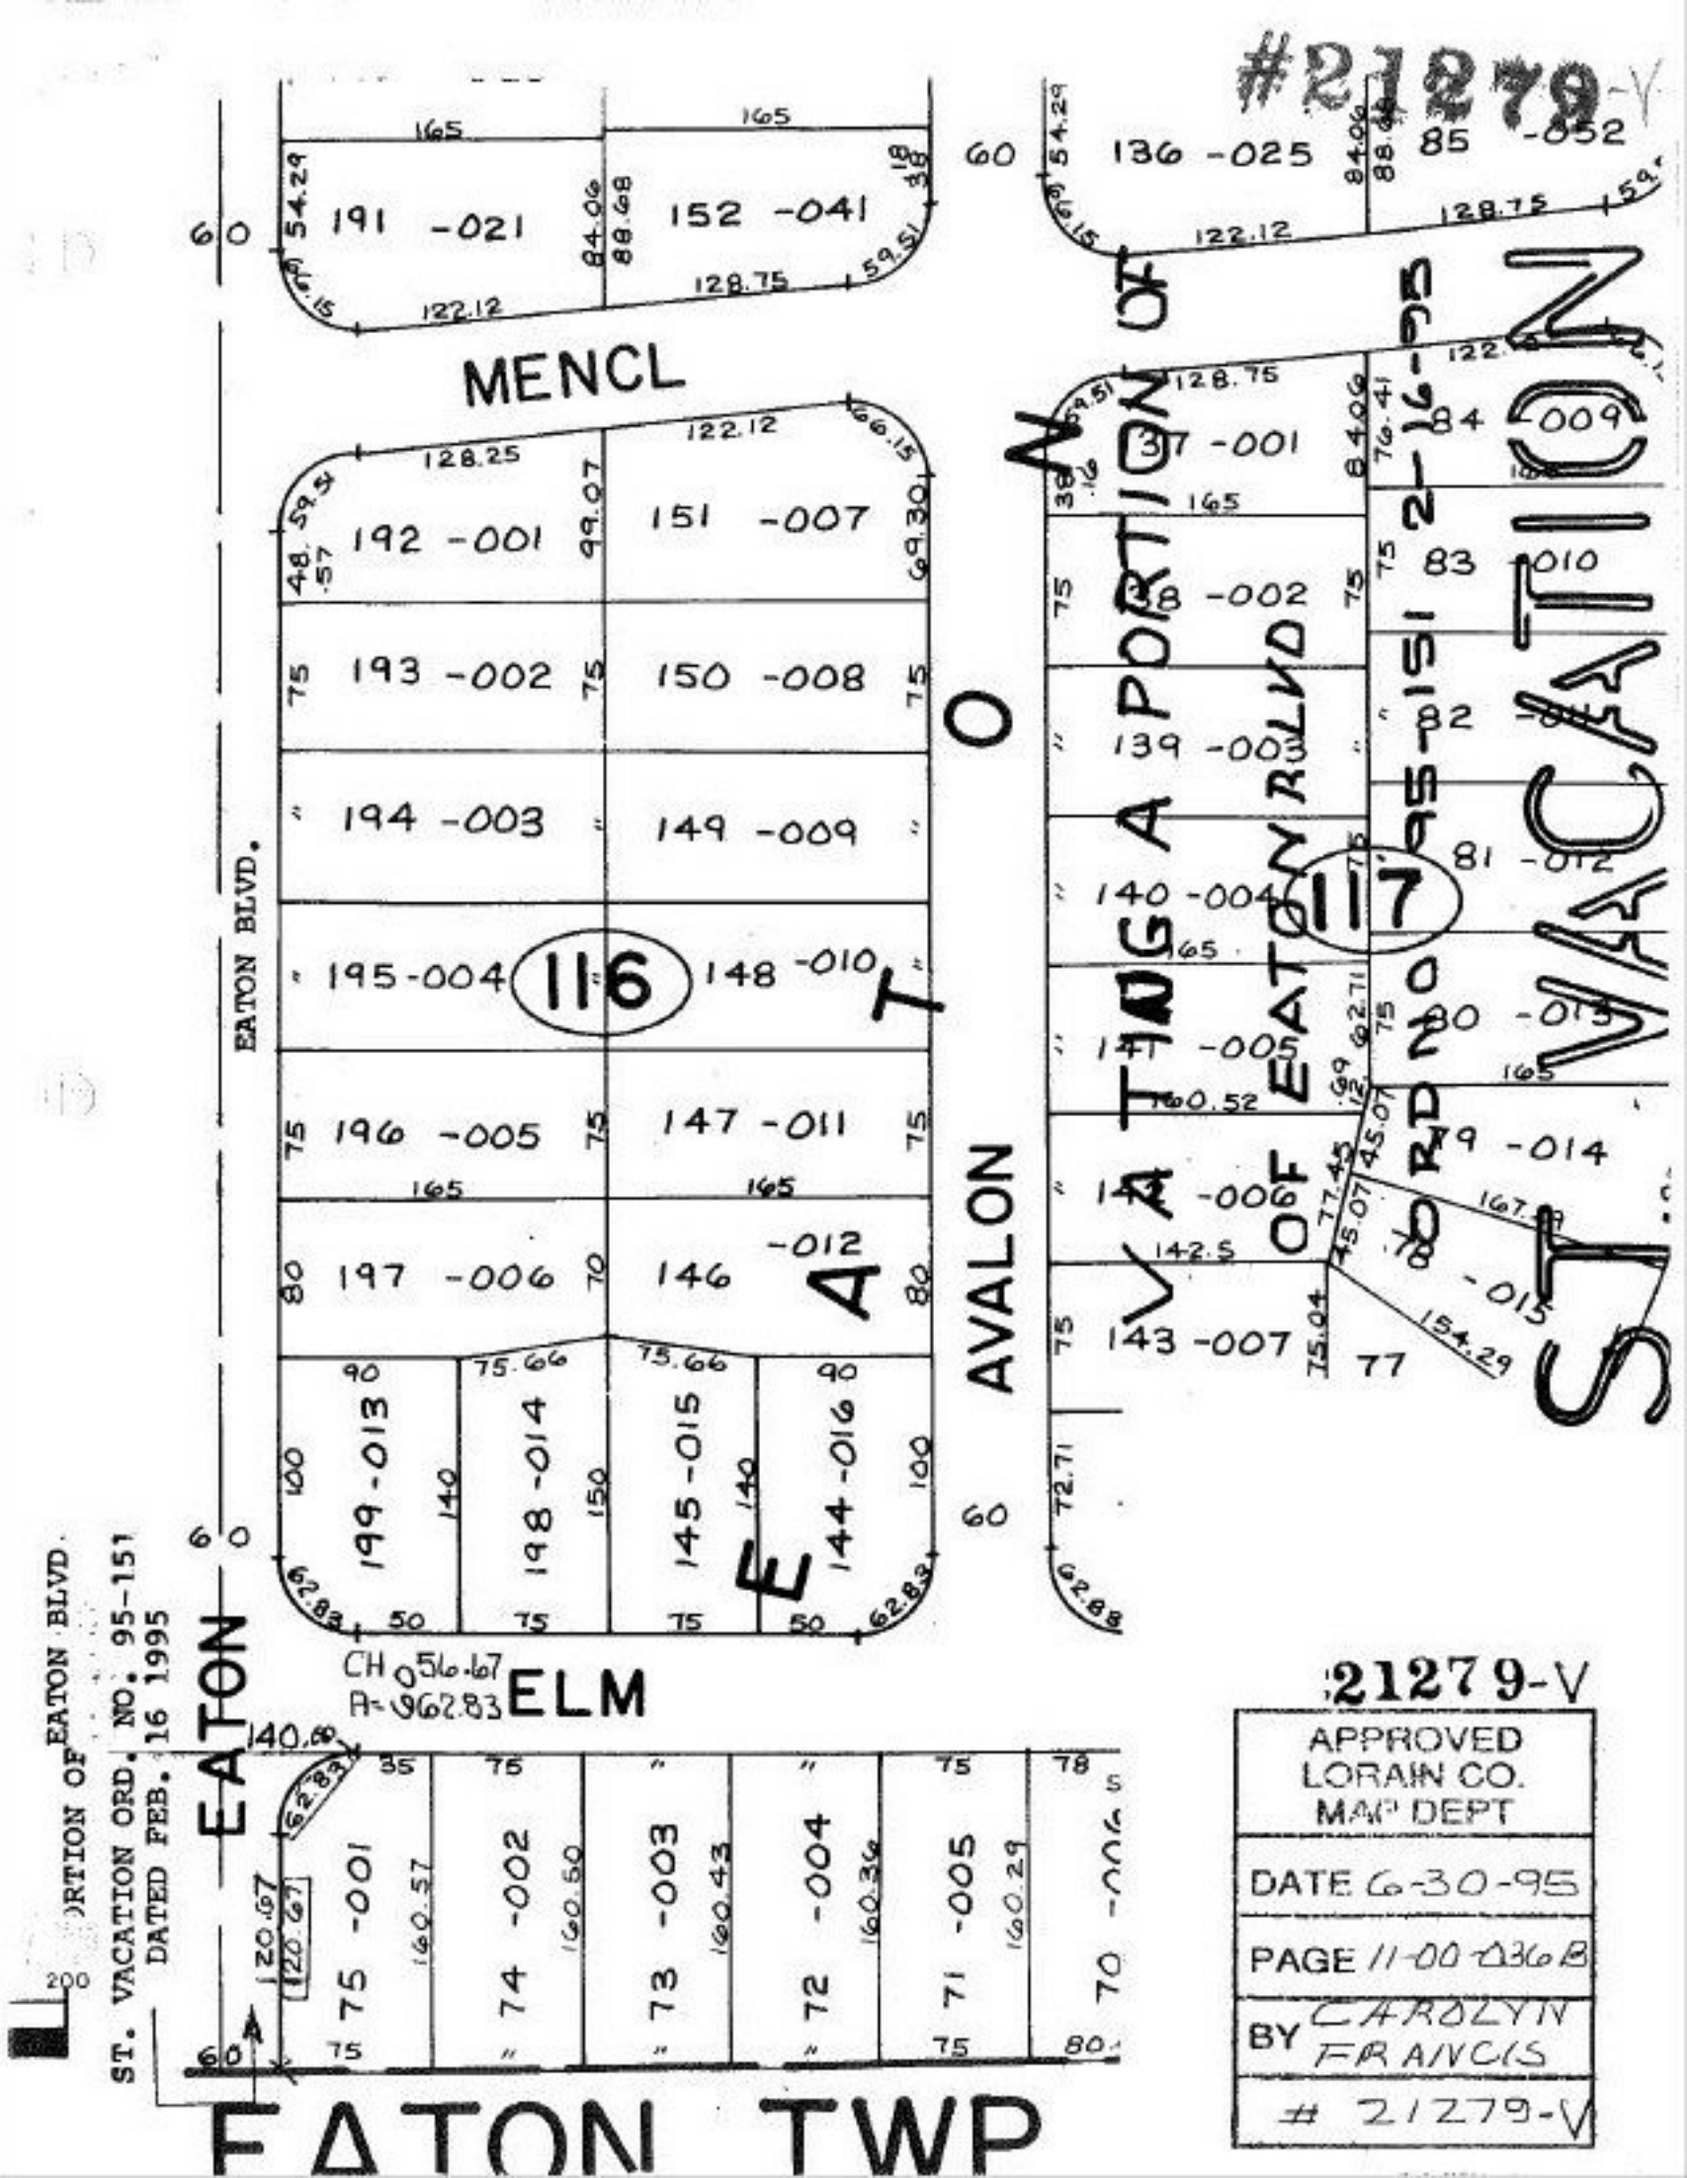

#21279-V
APPROVED LORAIN CO. MAP DEPT
DATE 6-30-95
PAGE 11-00 0036 B
BY CAROLYN FRANCIS
21279-V