#21279-V

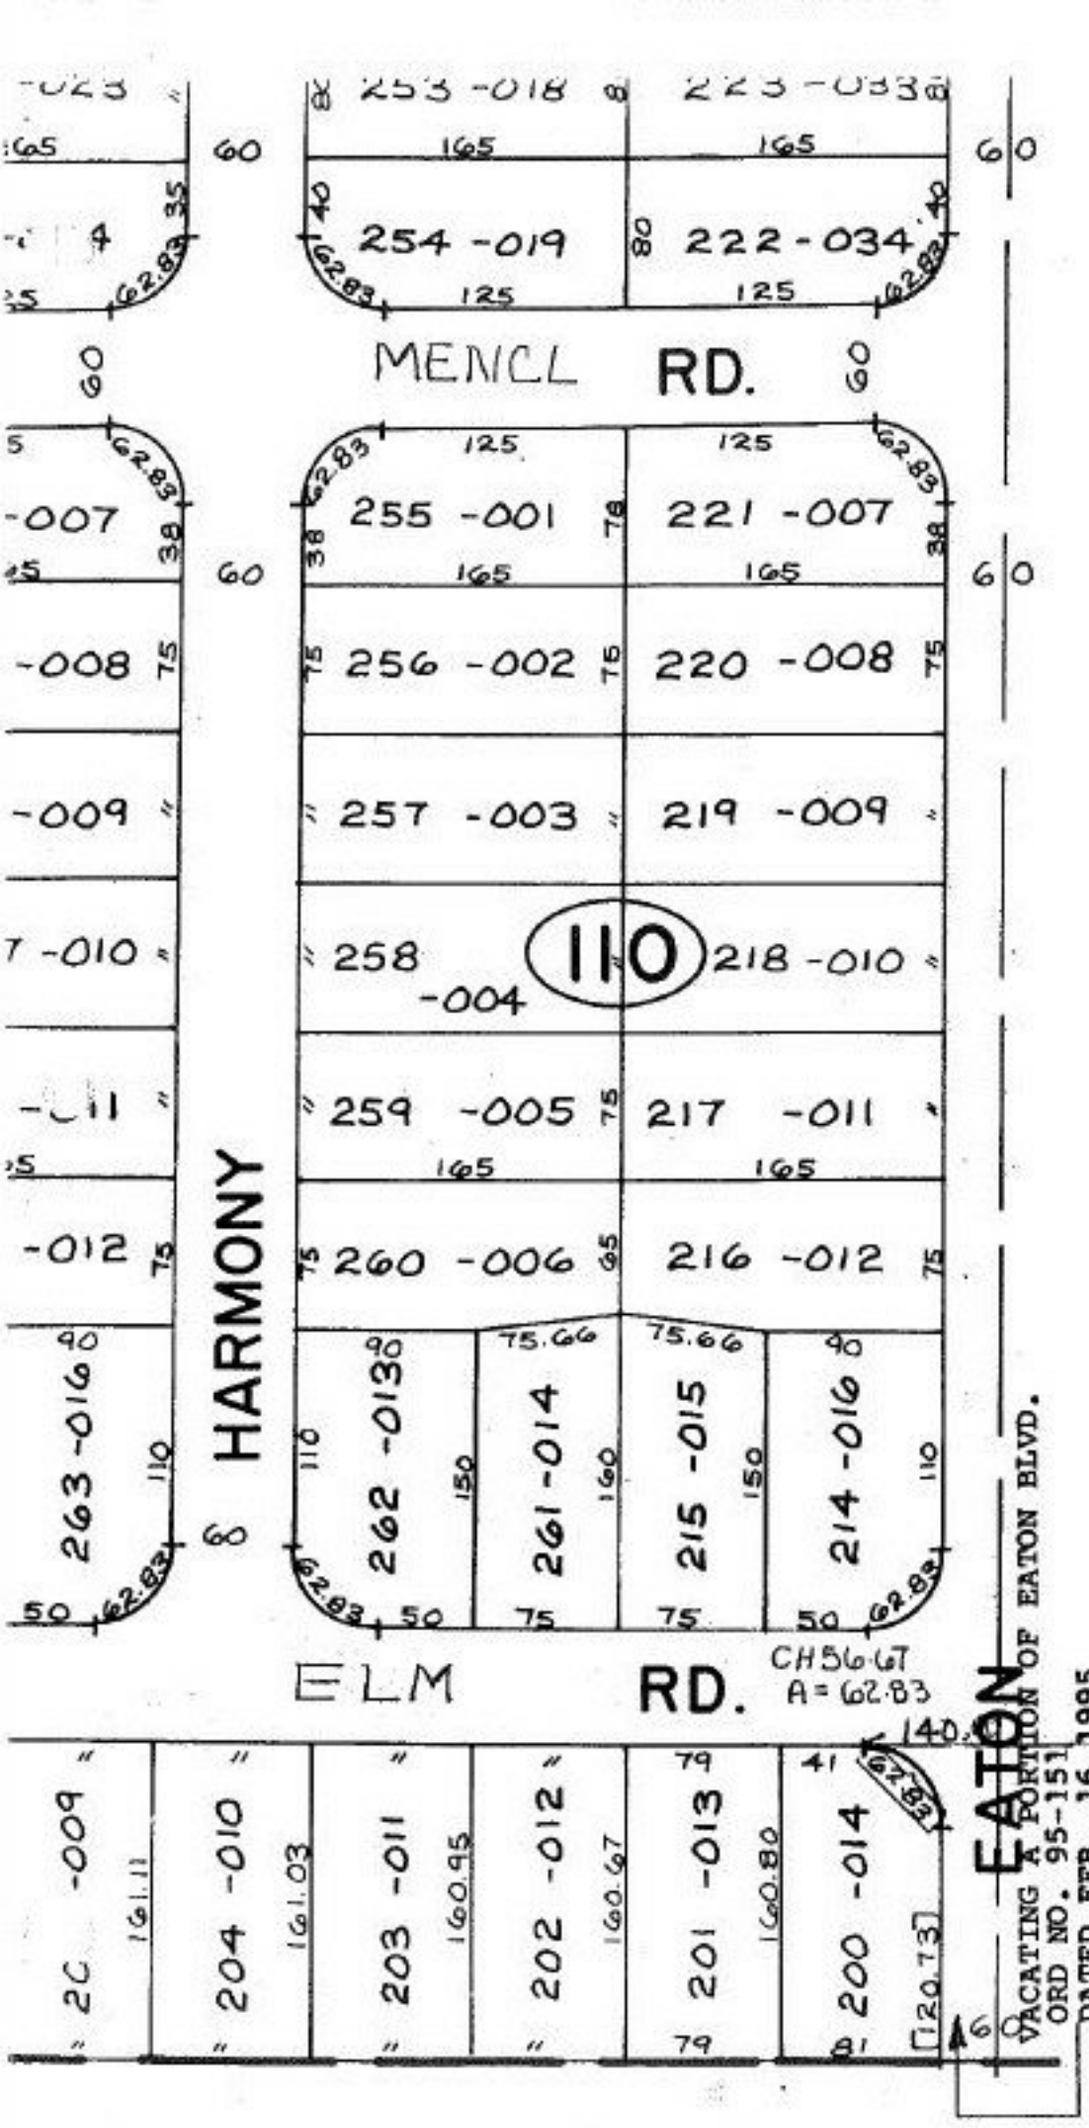

VACATION

ORD 20 95-151-2-16-95

VACATING A PORTION OF EATON BLVD

21279-V
APPROVED LORAIN CO. MAP DEPT
DATE 6-30-95
PAGE 11-00 036-A
BY CAROLYN FRANCIS
#21279-V