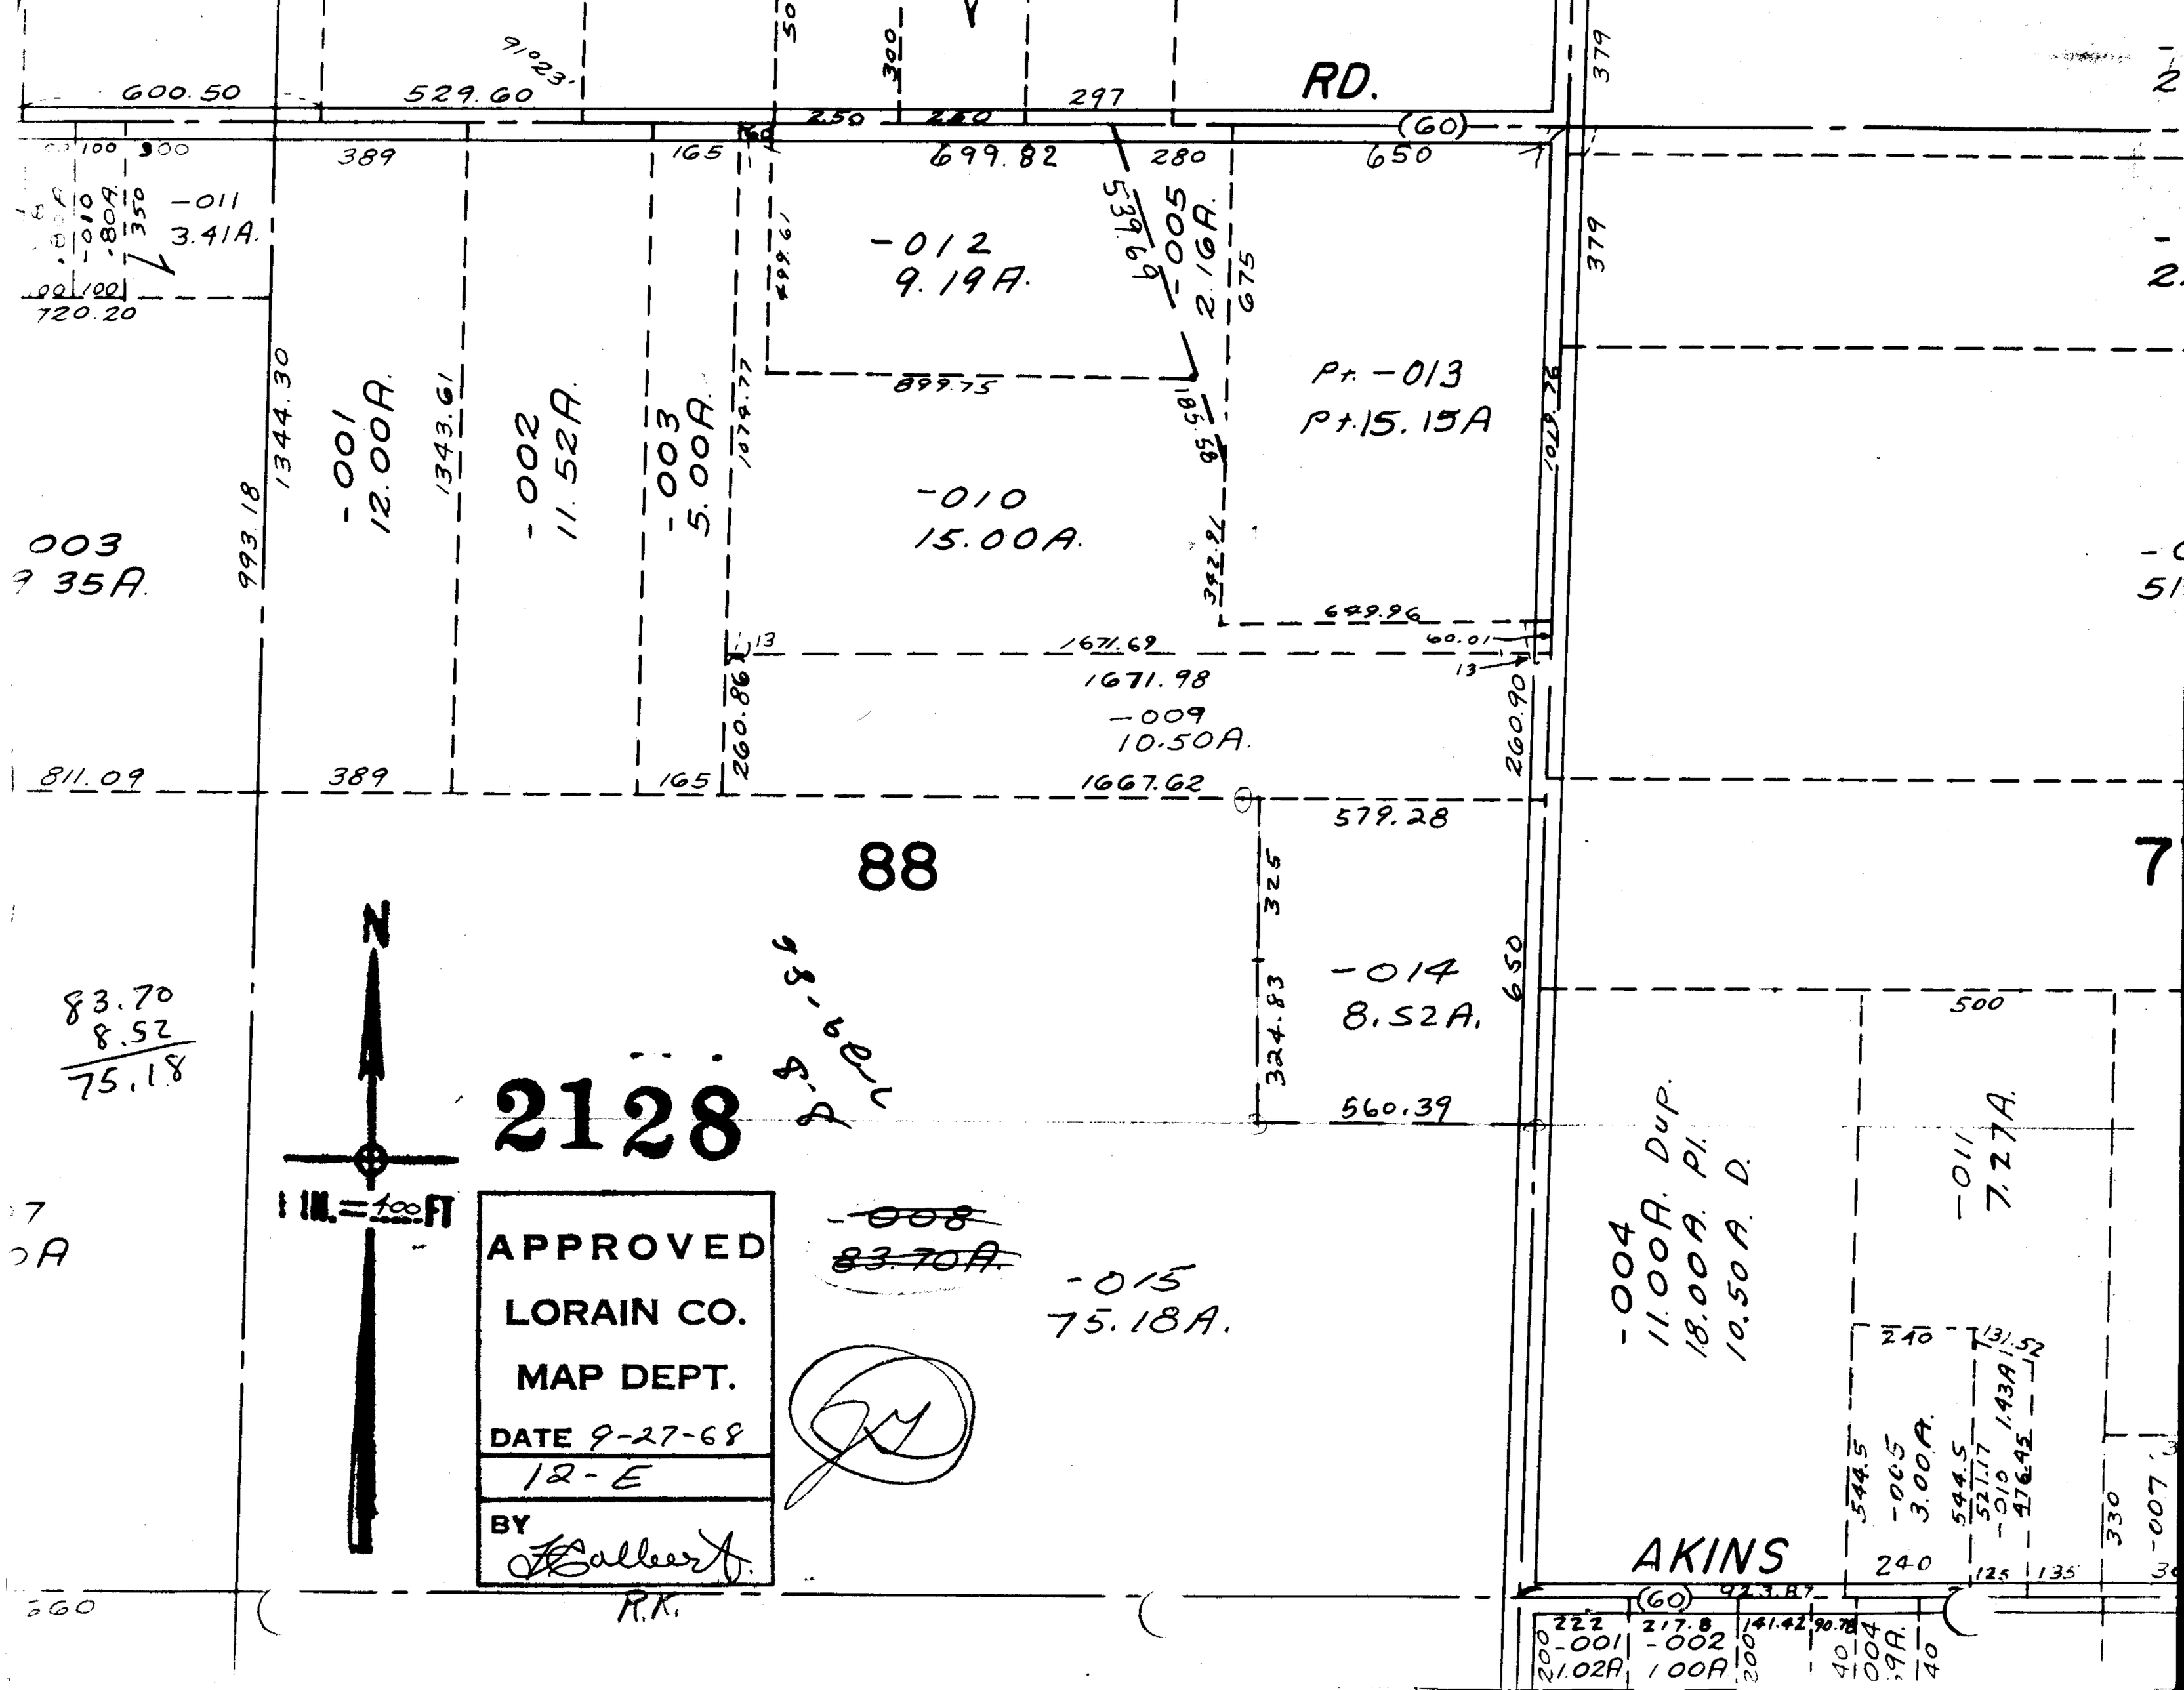

RD.
600.50
529.60
297
250
250
(60)
699.82
280
650
379
389
165
-011
3.41A.
720.20
-012
9.19A.
539.69
-005
2.16A.
675
899.75
Pt. -013
Pt. 15.15A
-001
12.00A.
-002
11.52A.
-003
5.00A.
1344.30
1343.61
993.18
-010
15.00A.
003
9.35A.
649.96
1671.69
1671.98
-009
10.50A.
260.86
260.90
811.09
389
165
1667.62
579.28
88
7
-014
8.52A.
324.83
650
500
560.39
83.70
8.52
75.18
2128
1 IN. = 400 FT
APPROVED
LORAIN CO.
MAP DEPT.
DATE 9-27-68
12-E
BY
-008
83.70A.
-015
75.18A.
-004
11.00A. Dup.
18.00A. Pl.
10.50A. D.
-011
7.27A.
240
131.52
544.5
-005
3.00A.
544.5
521.17
-010
476.45
1.43A
330
AKINS
240
125
135
(60)
923.87
222
-001
1.02A
217.8
-002
1.00A
141.42
90.78
R.K.