21281

SEE 4-00-012-C

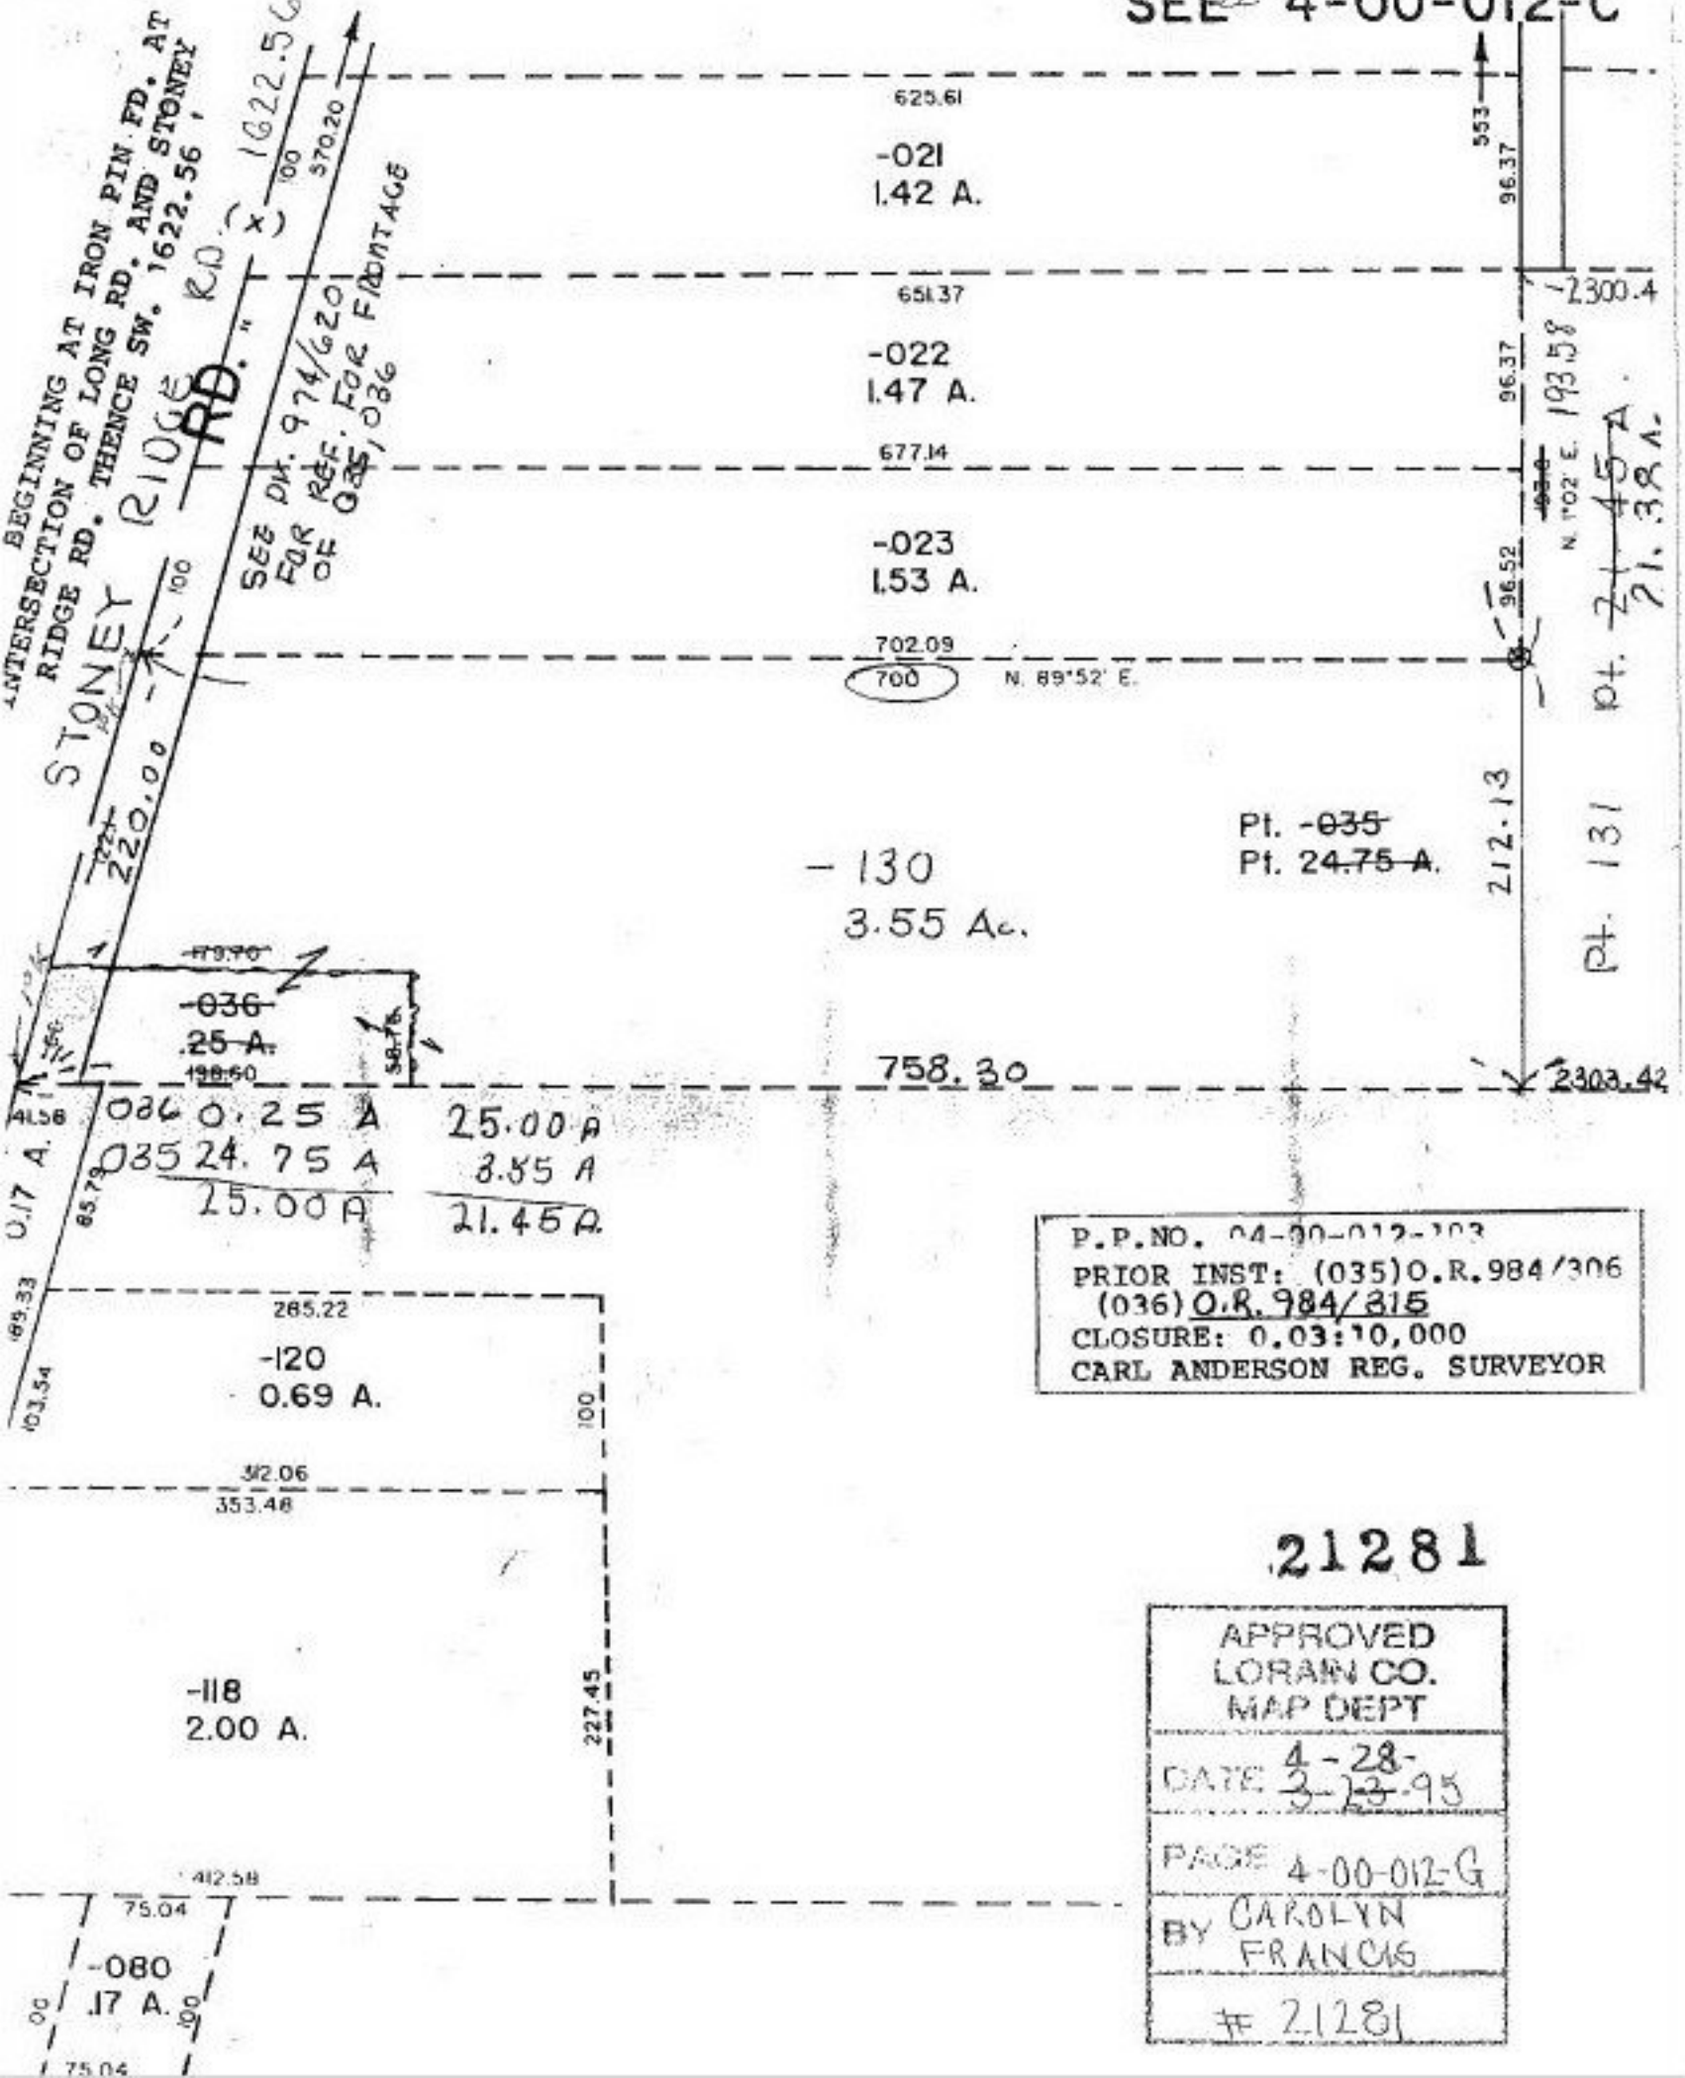

P.P.NO. 04-00-012-103
PRIOR INST: (035)O.R.984/306
(036) O.R. 984/315
CLOSURE: 0.03:10,000
CARL ANDERSON REG. SURVEYOR

21281

APPROVED
LORAIN CO.
MAP DEPT

DATE 4-28-95

PAGE 4-00-012-G

BY CAROLYN FRANCIS

21281