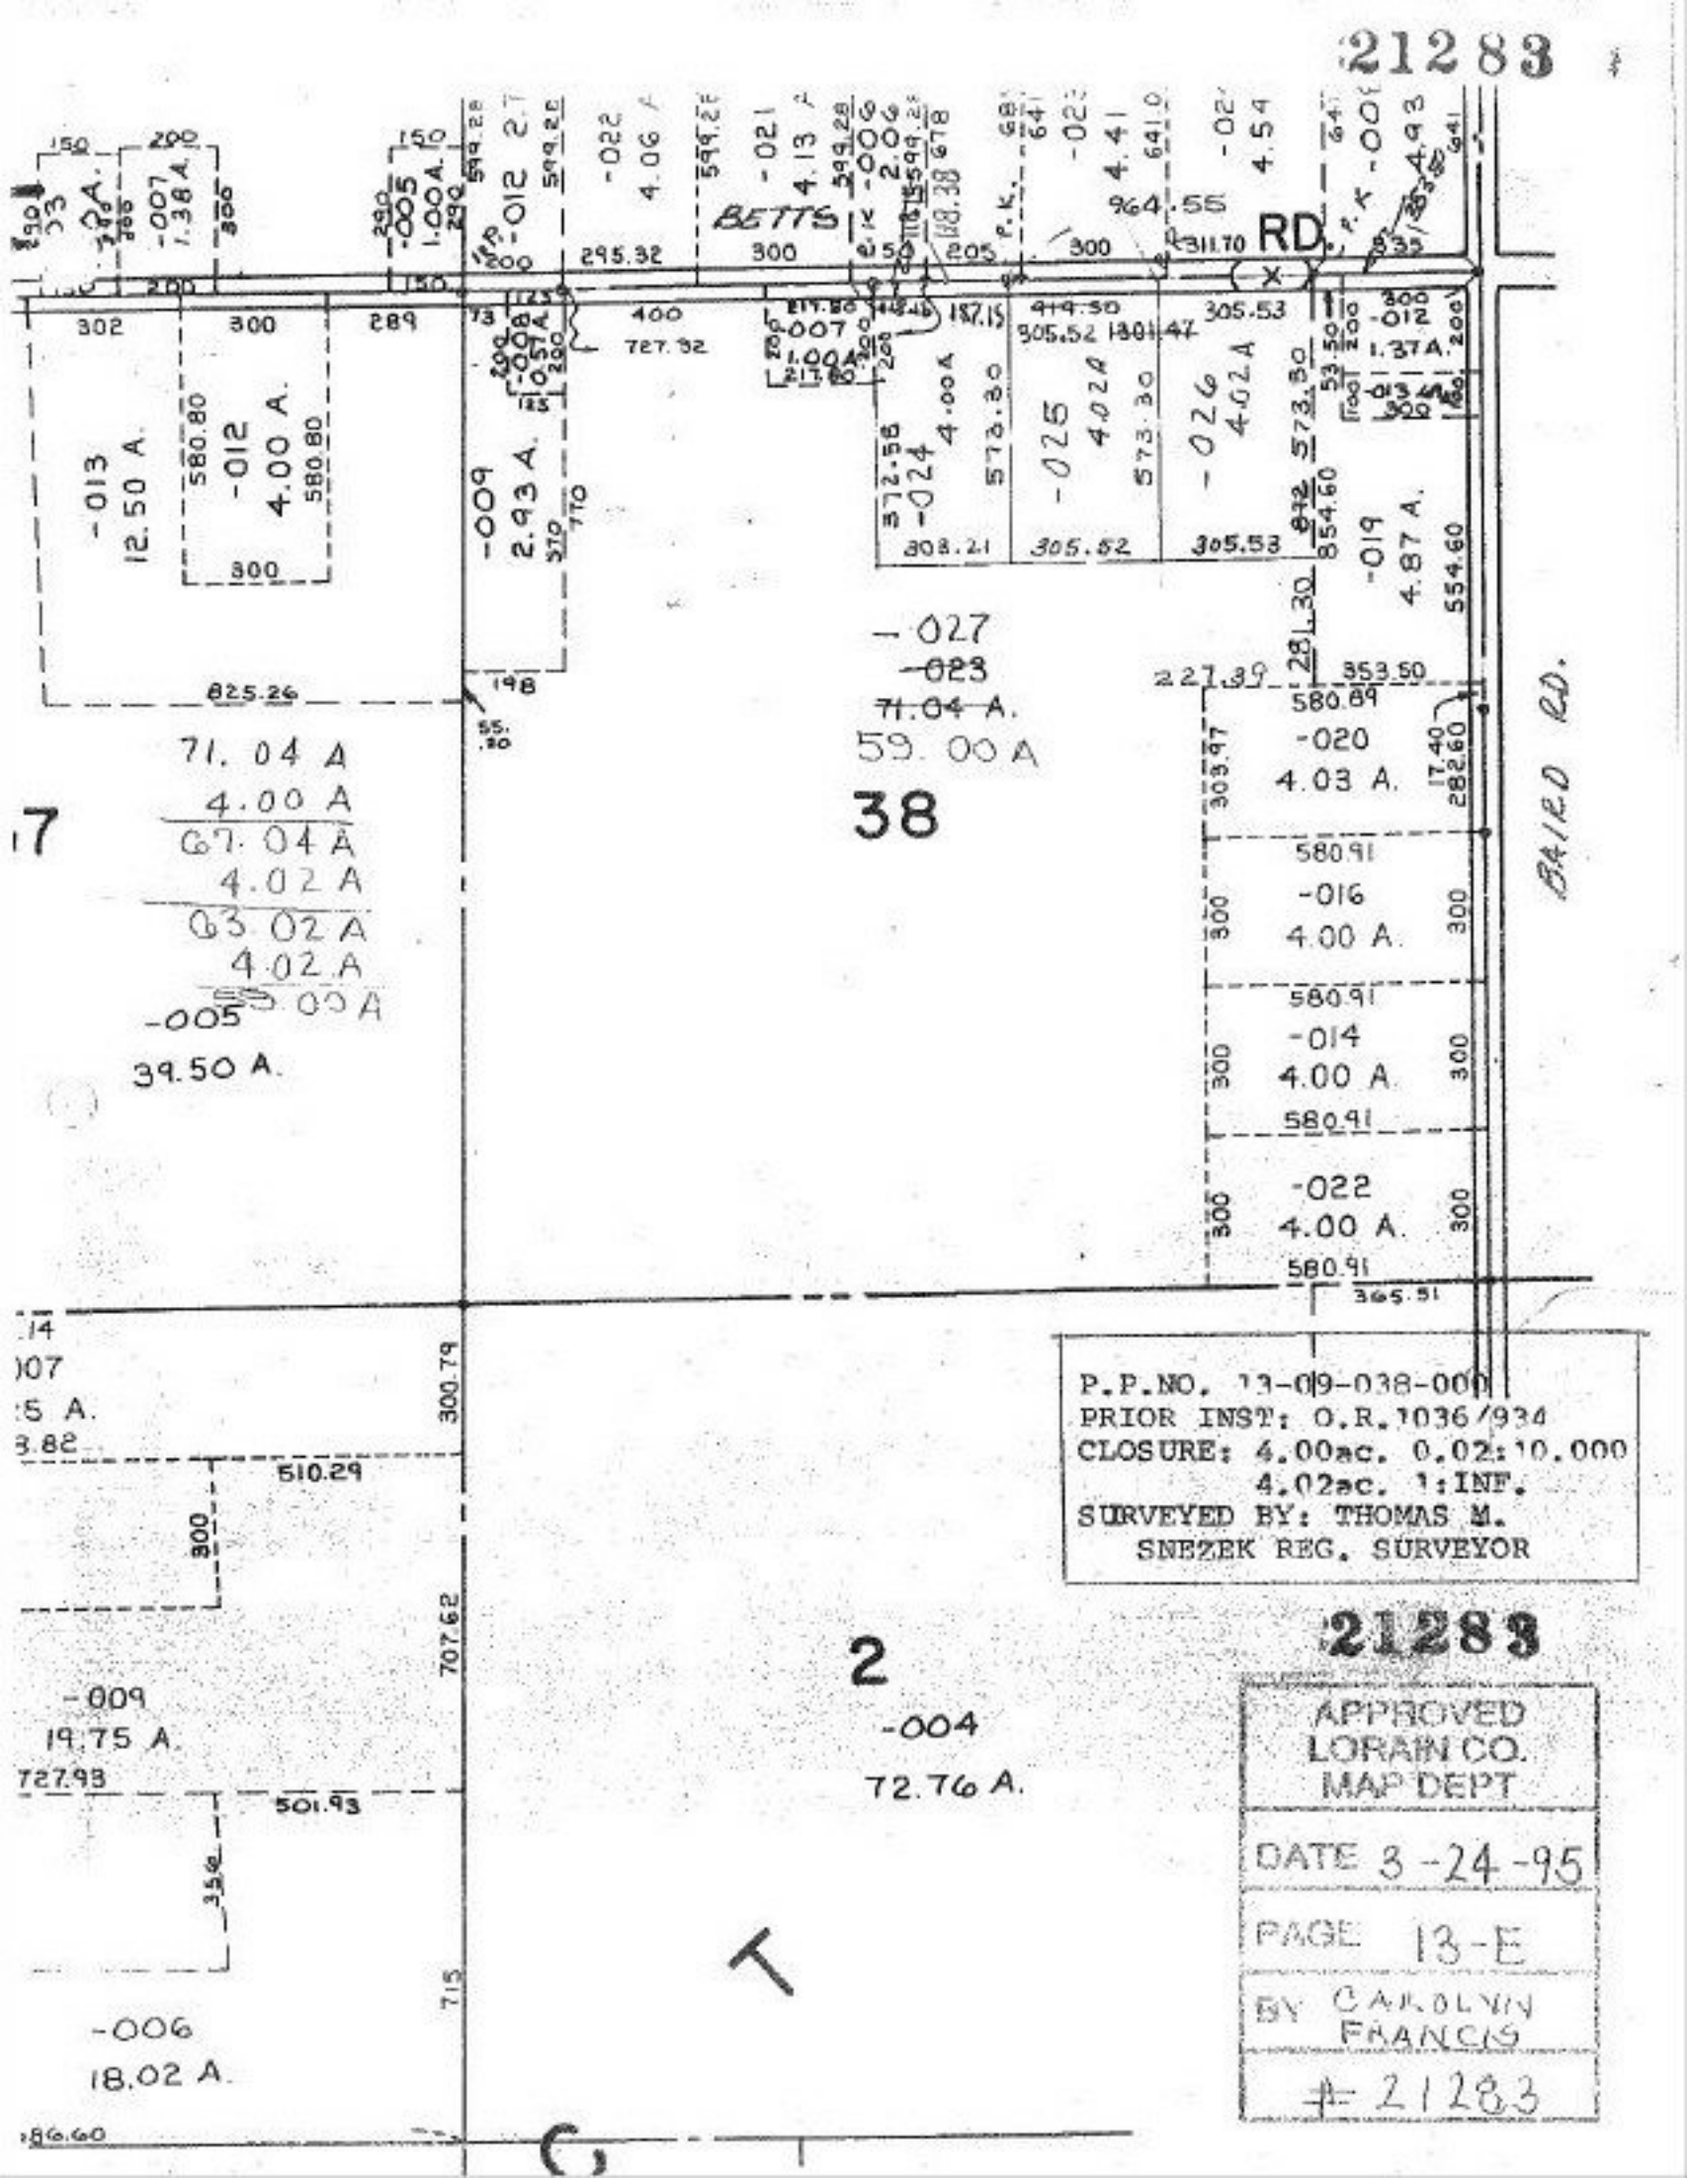
21283
BETTS
RD.
BAIRD RD.
-013
12.50 A.
-012
4.00 A.
-009
2.93 A.
-027
-023
71.04 A.
59.00 A
38
-025
4.02 A.
-026
4.02 A.
-024
4.00 A.
-019
4.87 A.
-020
4.03 A.
-016
4.00 A.
-014
4.00 A.
-022
4.00 A.
71.04 A
4.00 A
67.04 A
4.02 A
63.02 A
4.02 A
-005
39.50 A.
-009
19.75 A.
-006
18.02 A.
-004
72.76 A.
2
P.P.NO. 13-09-038-000
PRIOR INST: O.R.1036/934
CLOSURE: 4.00ac. 0.02:10.000
4.02ac. 1:INF.
SURVEYED BY: THOMAS M.
SNEZEK REG. SURVEYOR
21283
APPROVED
LORAIN CO.
MAP DEPT
DATE 3-24-95
PAGE 13-E
BY CAROLYN
FRANCIS
21283