21284

SEE 17-A
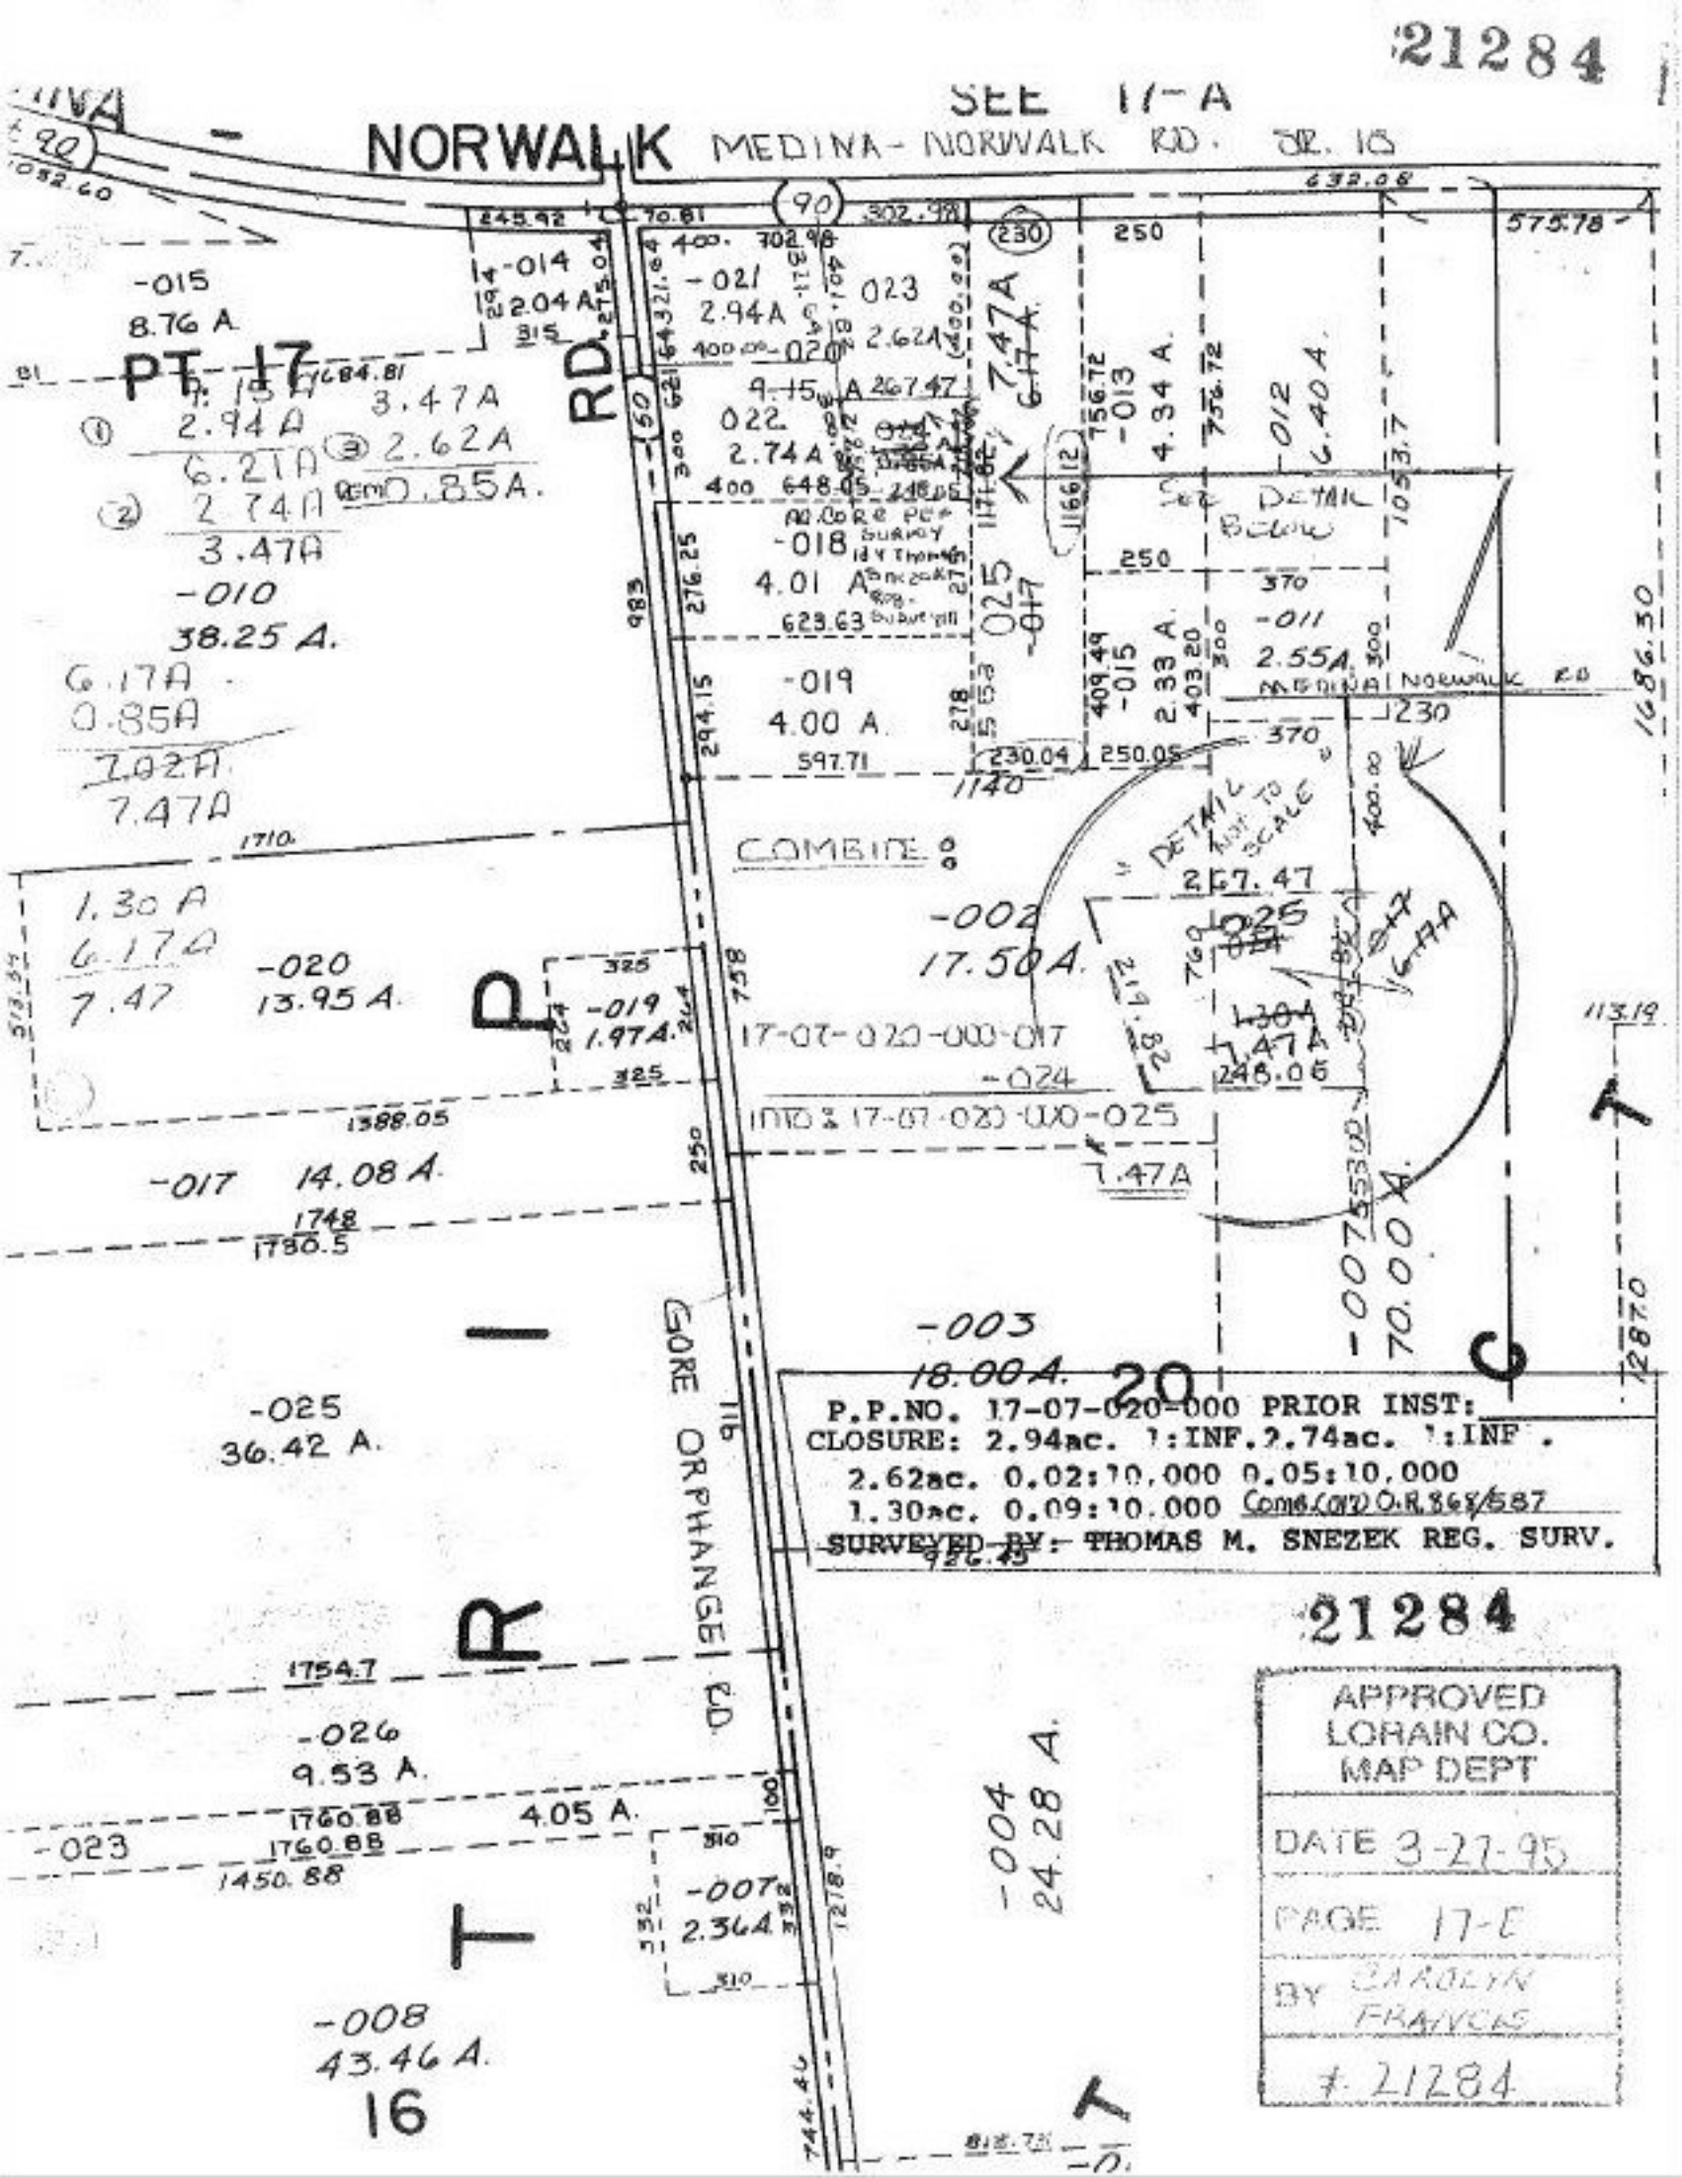
NORWALK MEDINA-NORWALK RD. RT. 18