21286

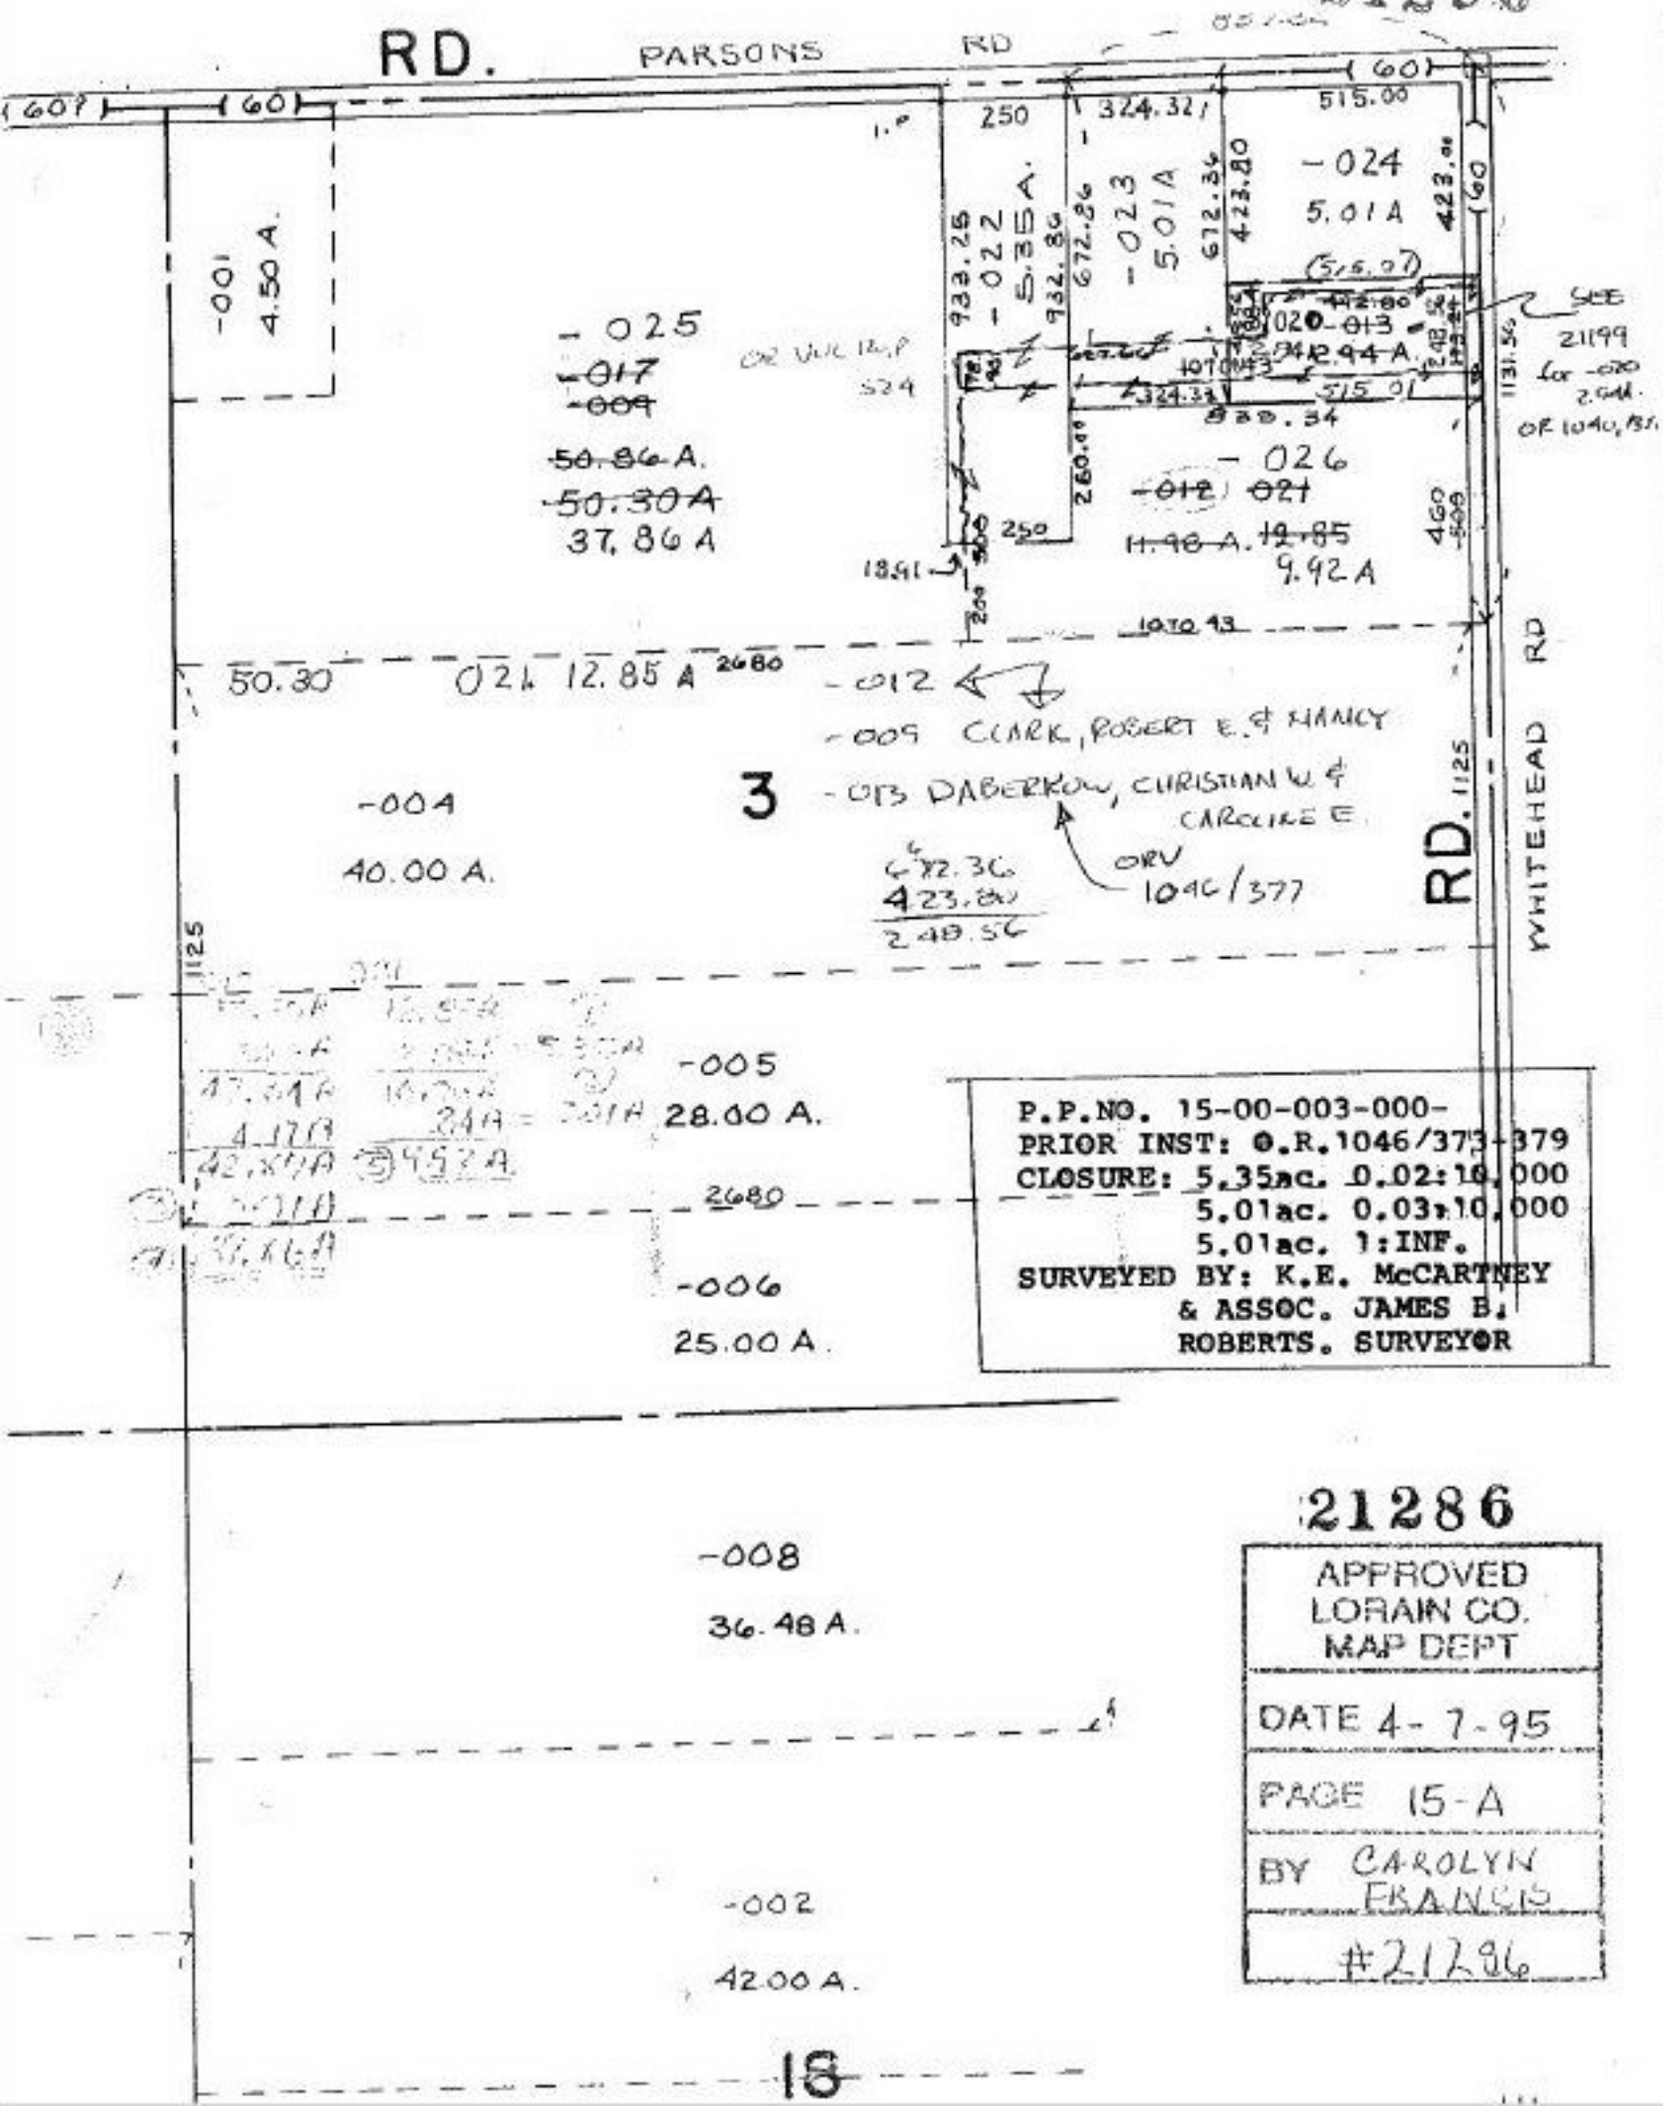

P.P.NO. 15-00-003-000-
PRIOR INST: O.R.1046/373-379
CLOSURE: 5.35ac. 0.02:10,000
5.01ac. 0.03:10,000
5.01ac. 1:INF.
SURVEYED BY: K.E. McCARTNEY & ASSOC. JAMES B. ROBERTS. SURVEYOR

21286

APPROVED
LORAIN CO.
MAP DEPT

DATE 4-7-95

PAGE 15-A

BY CAROLYN FRANCIS

#21286