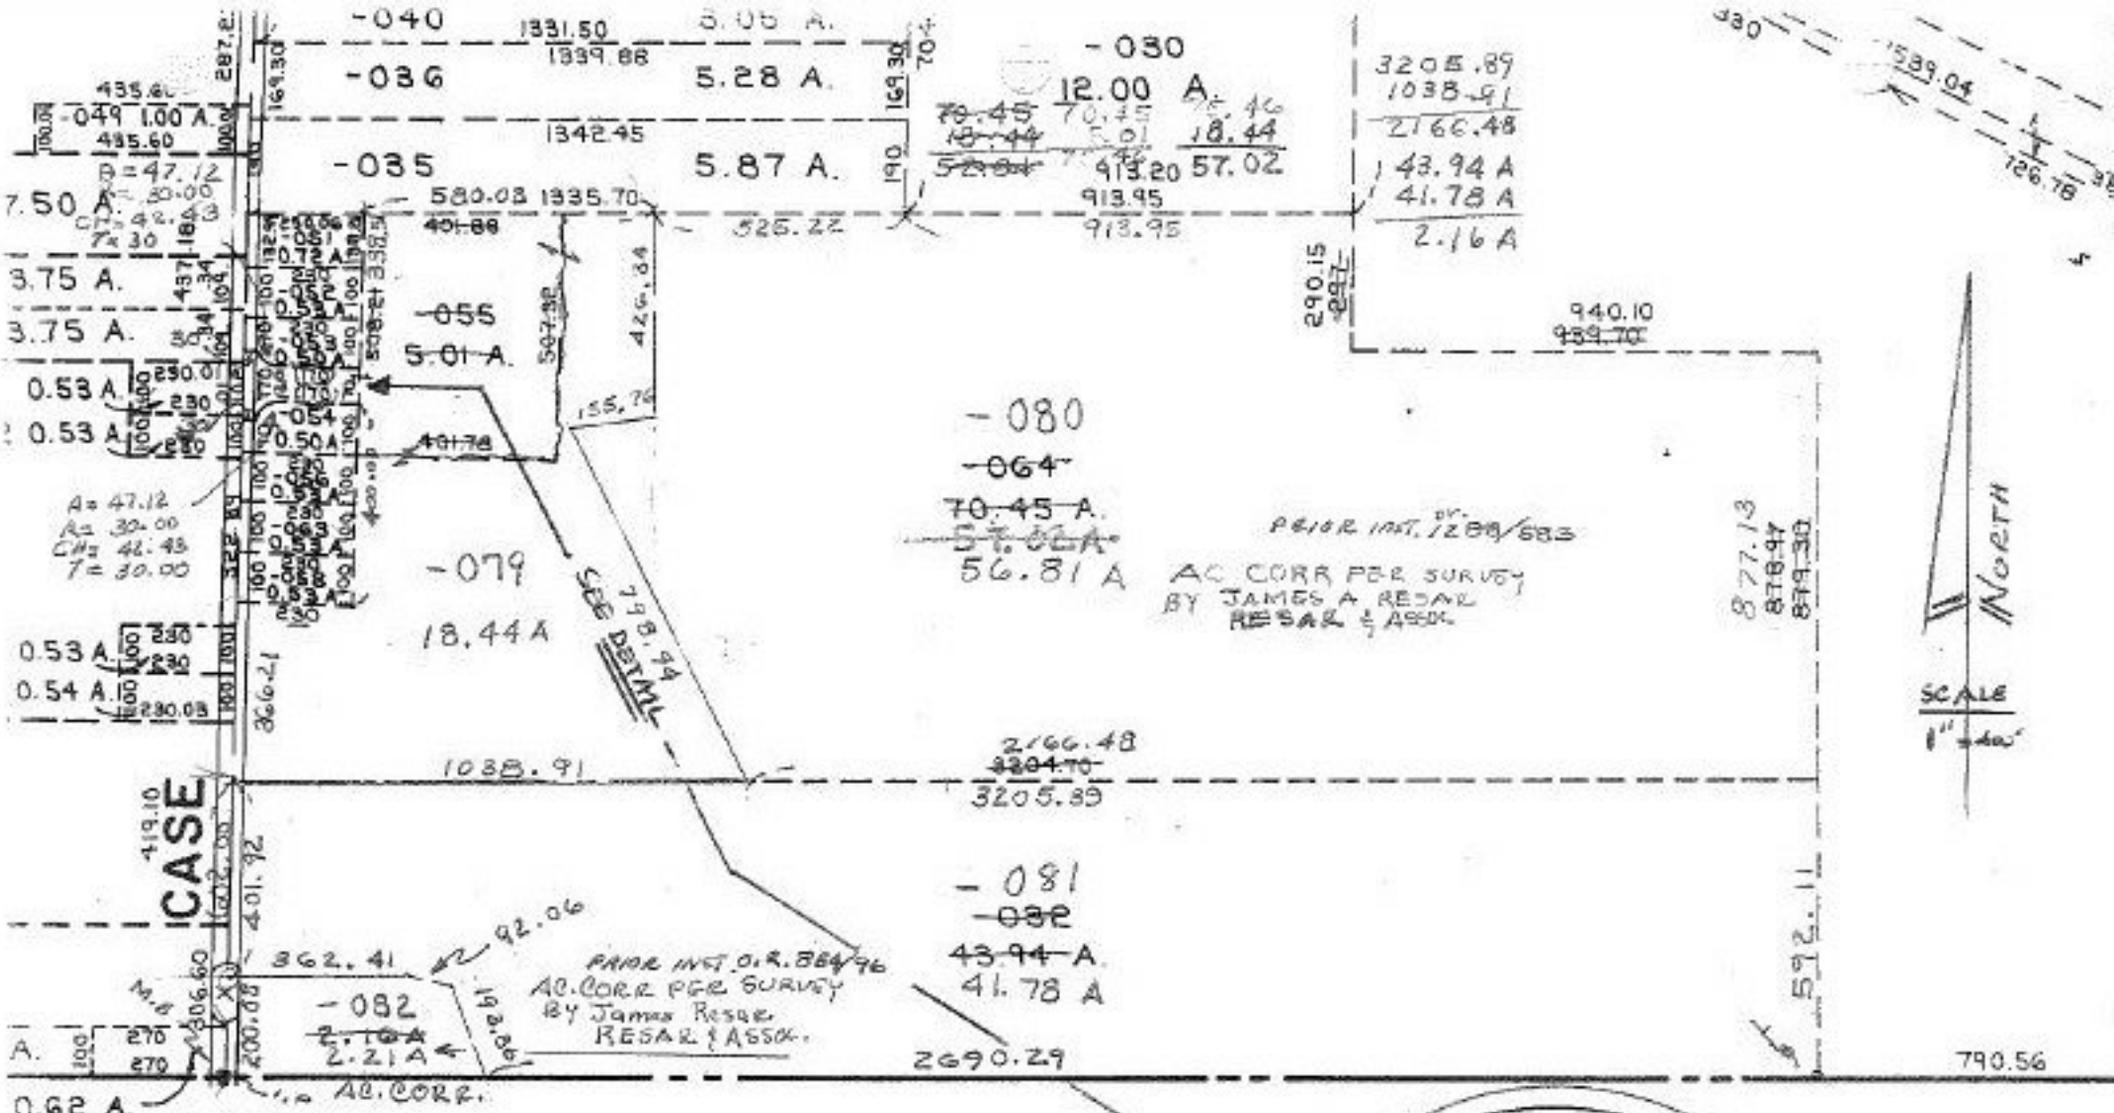

21288

APPROVED
LORAIN CO.
MAP DEPT

DATE 3-29-95

PAGE 4-I

BY CAROLYN FRANCE

21288

SEE 7-A

P.P.NO. 04-00-001-103-
PRIOR INST: O.R.854/96 DV. 1288/583
CLOSURE: 18.45ac. 0.04:10,000
41.78ac. 0.01:10,000
56.81ac. 0.01:10,000
2.21ac. 0.05:10,000
SURVEYED BY: JAMES RESAR
REG. SURVEYOR

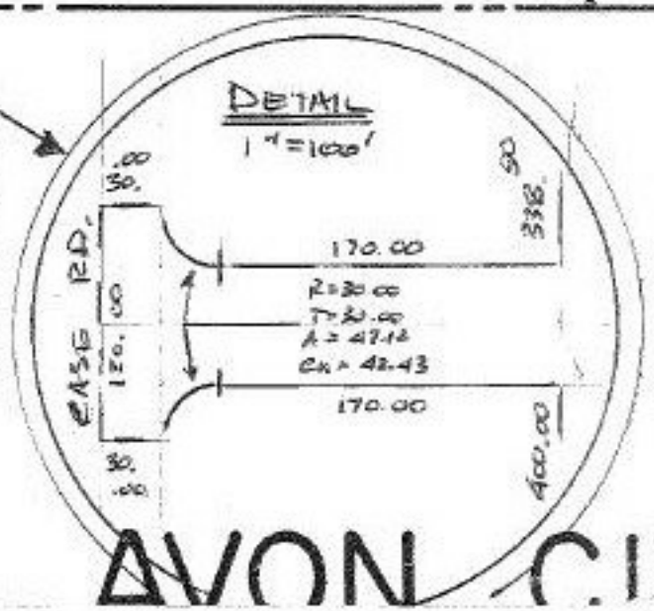

800 1000

AVON CIT