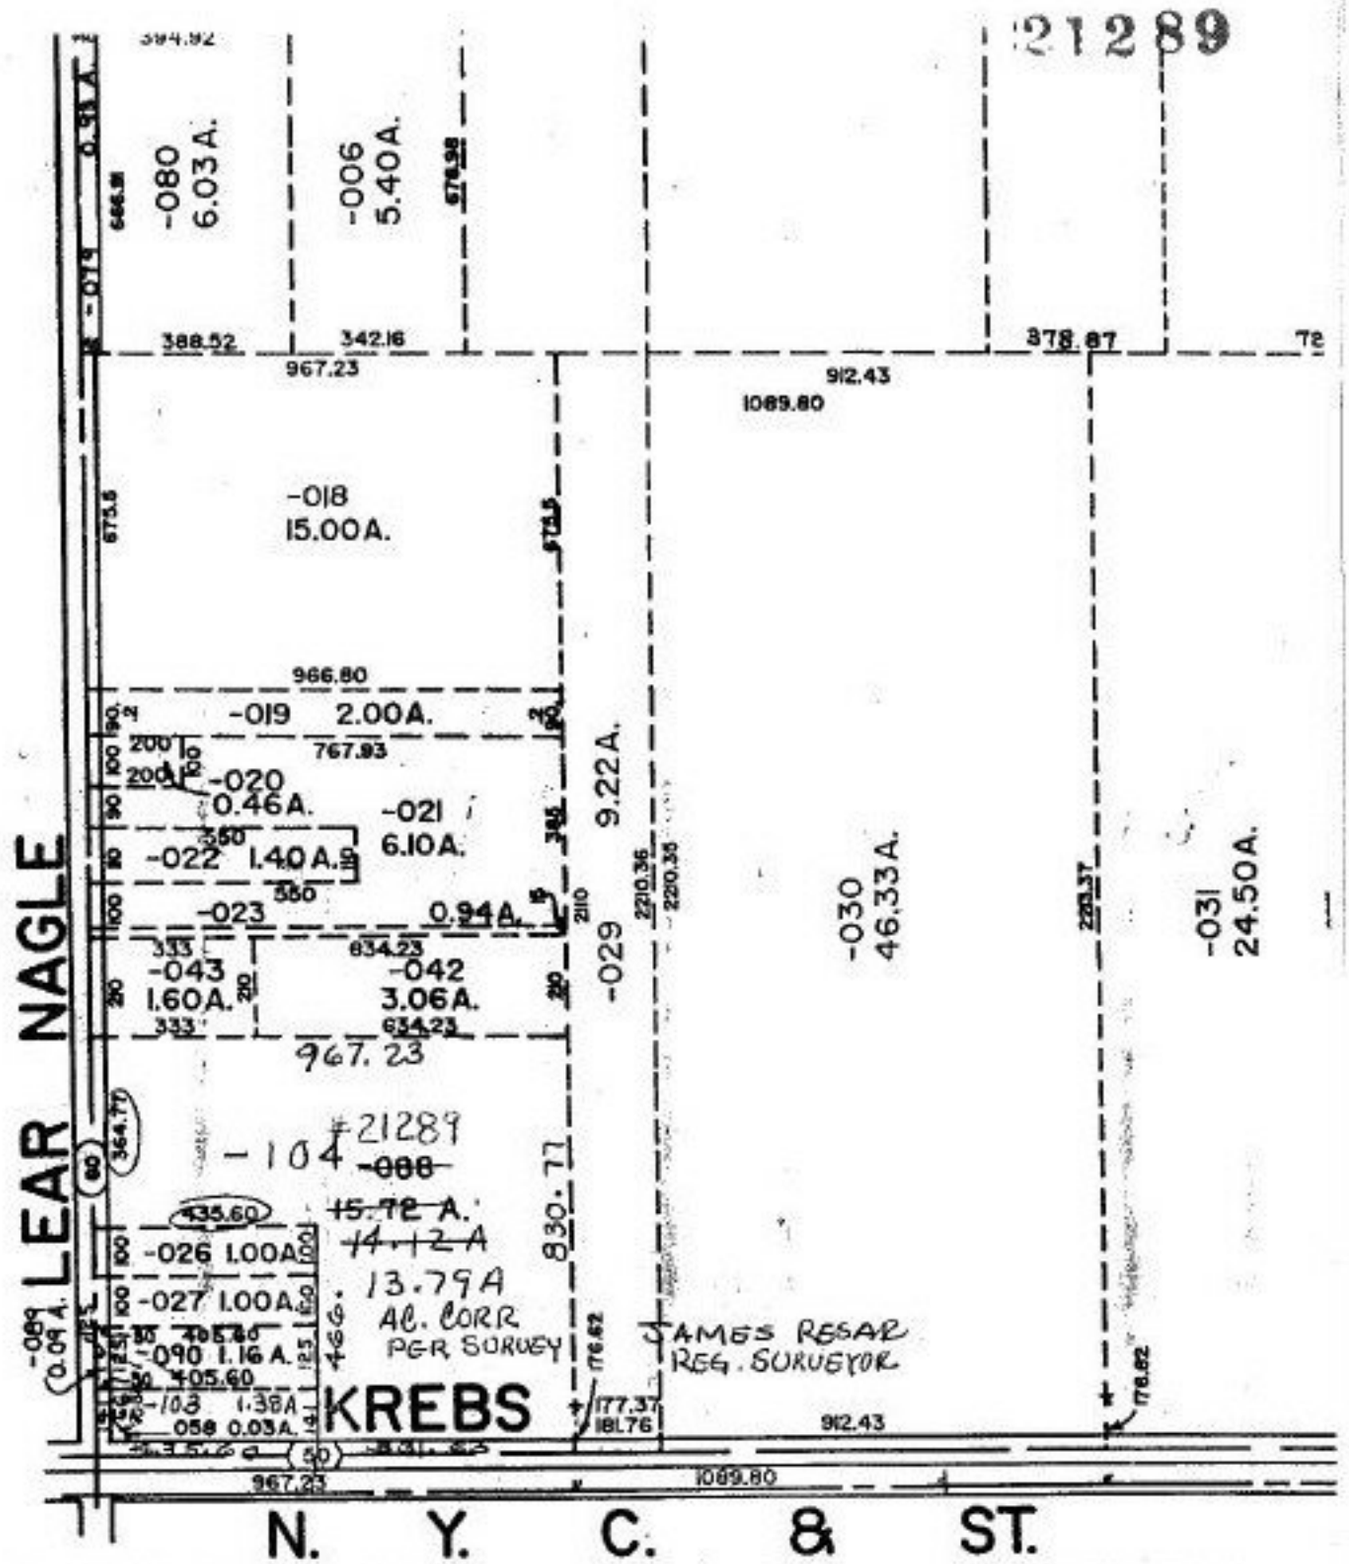

P.P.NO. 04-00-029-000-
PRIOR INST: DV. 712/324
CLOSURE: 13.79ac. 0.00:10,000
1.38ac. 1:INF.
SURVEYED BY: JAMES A RESAR
REG. SURVEYOR

21289

APPROVED
LORAIN CO.
MAP DEPT

DATE 4-25-95

PAGE 4-D

BY CAROLYN FRANCIS

21289