21290-U

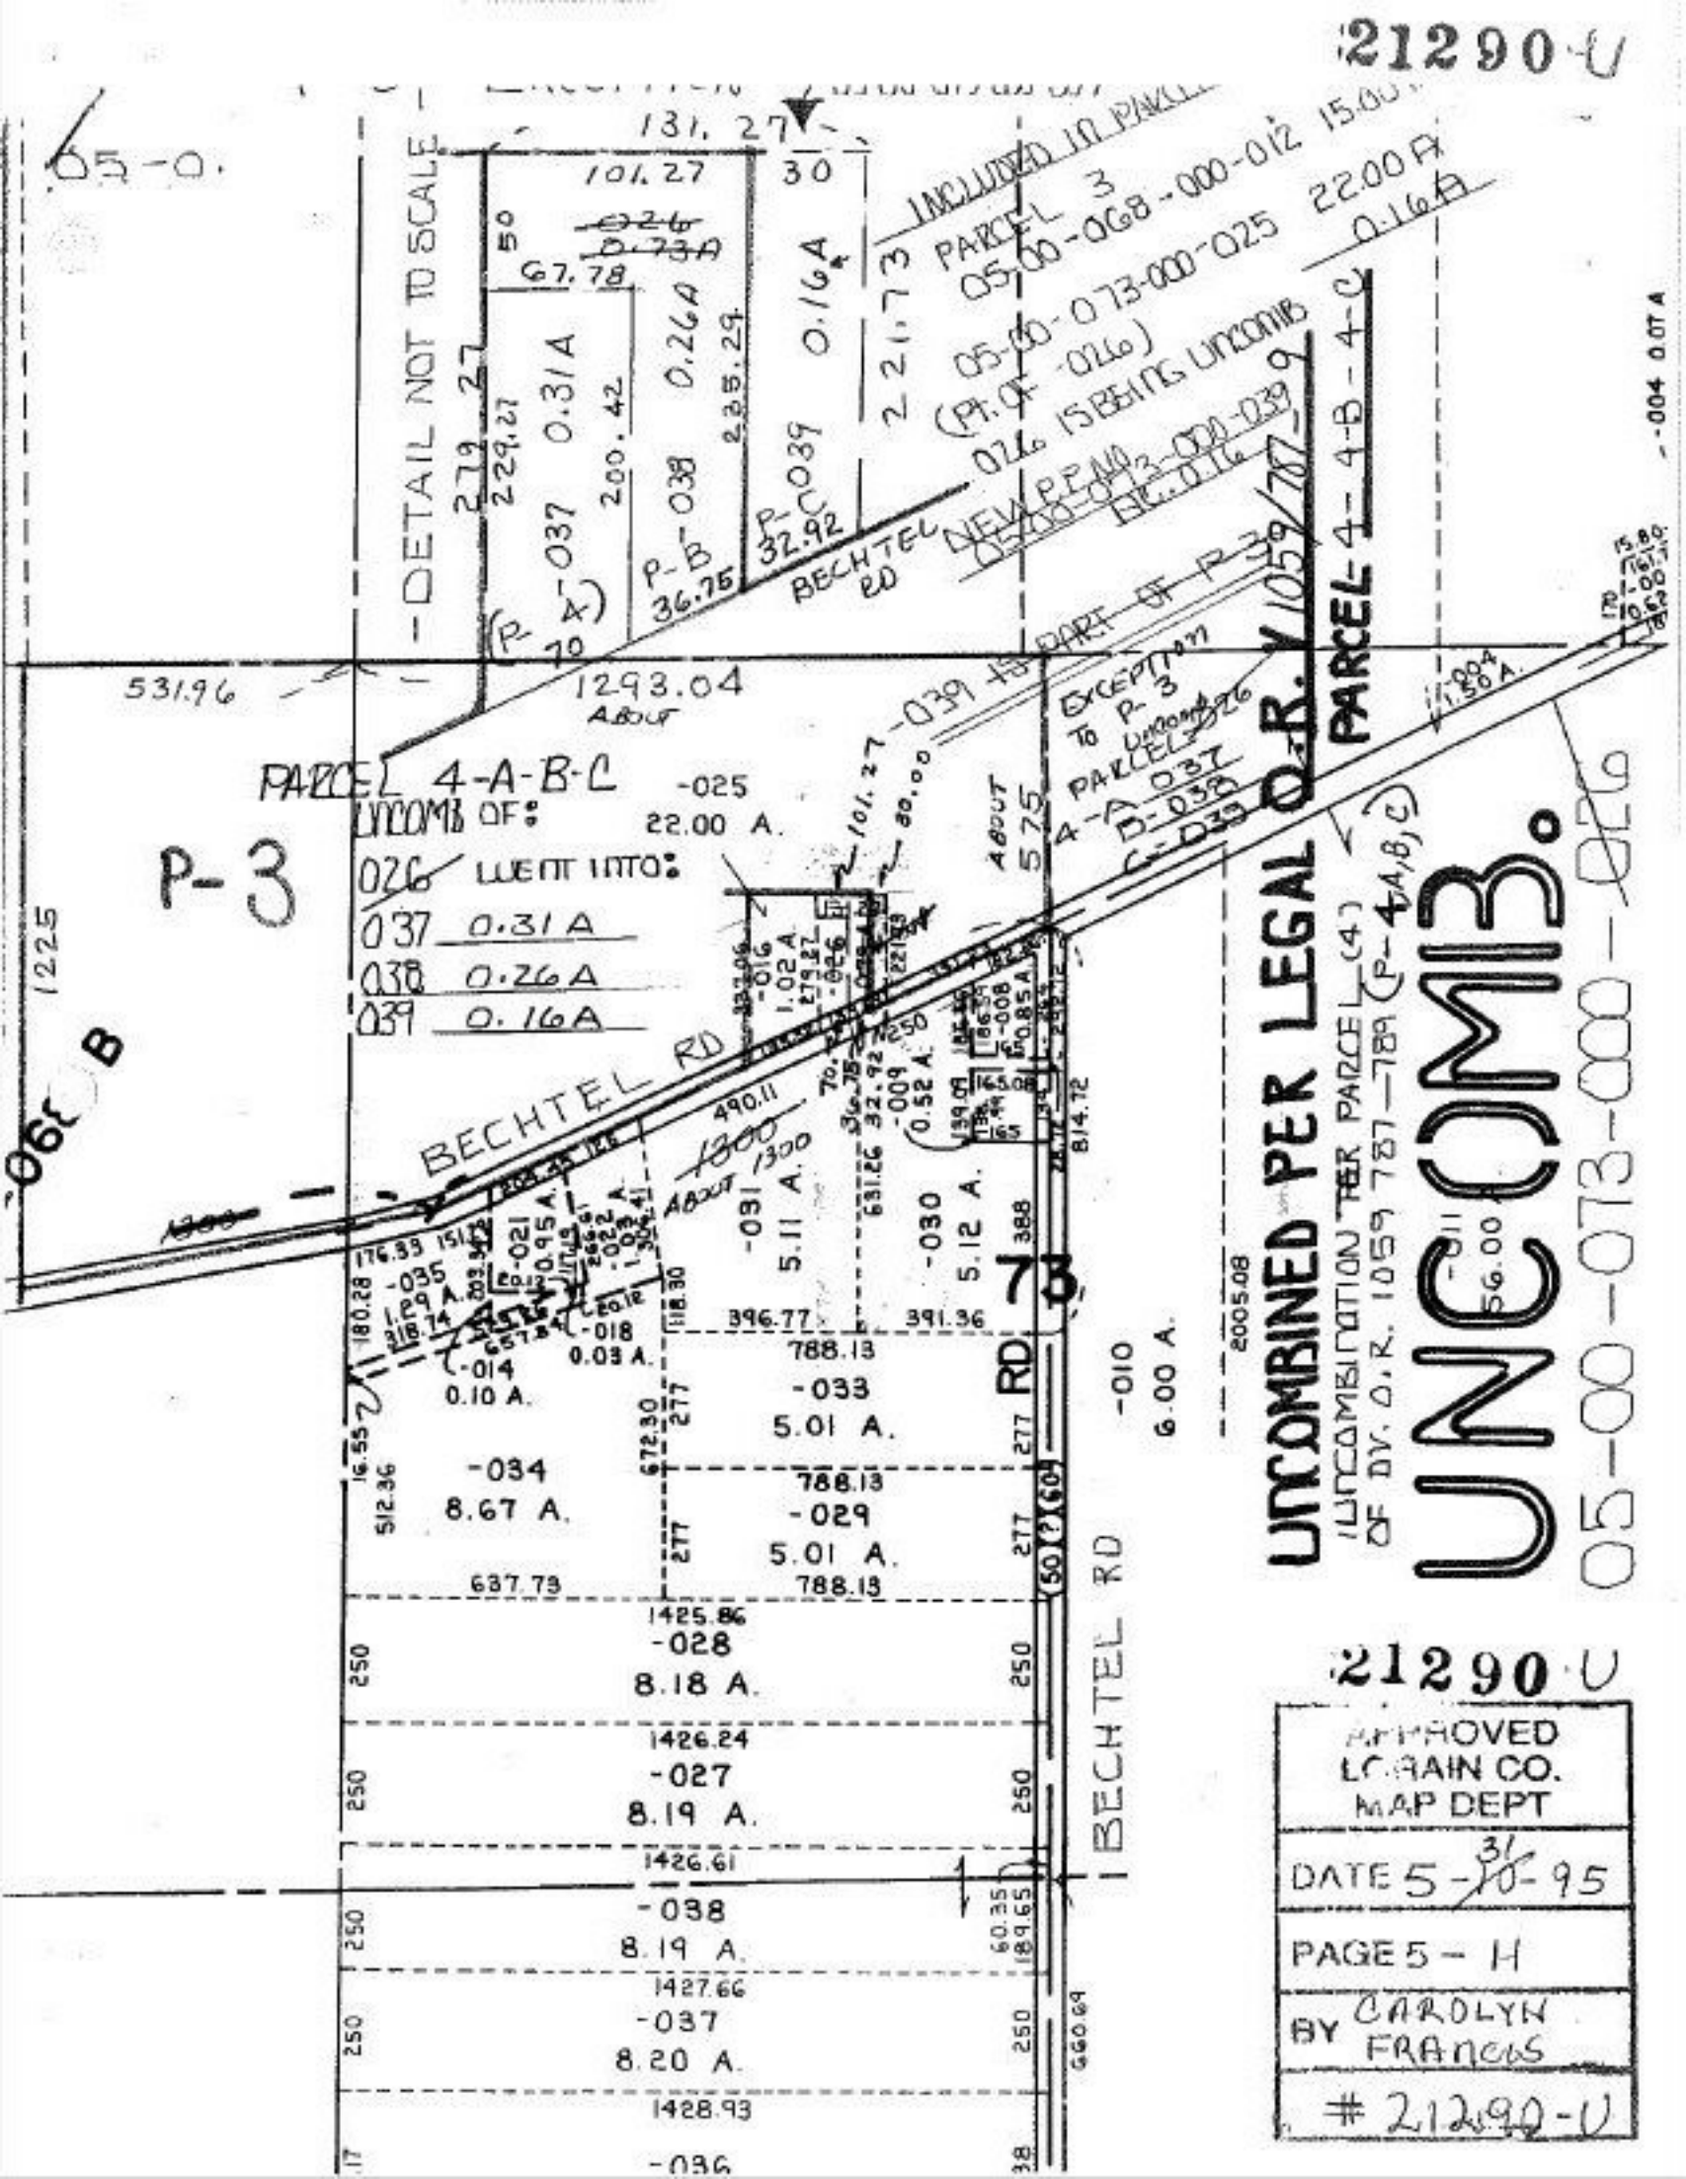

21290-U

APPROVED
LORAIN CO.
MAP DEPT
DATE 5-31-95
PAGE 5 - H
BY CAROLYN FRANCIS
#21290-U