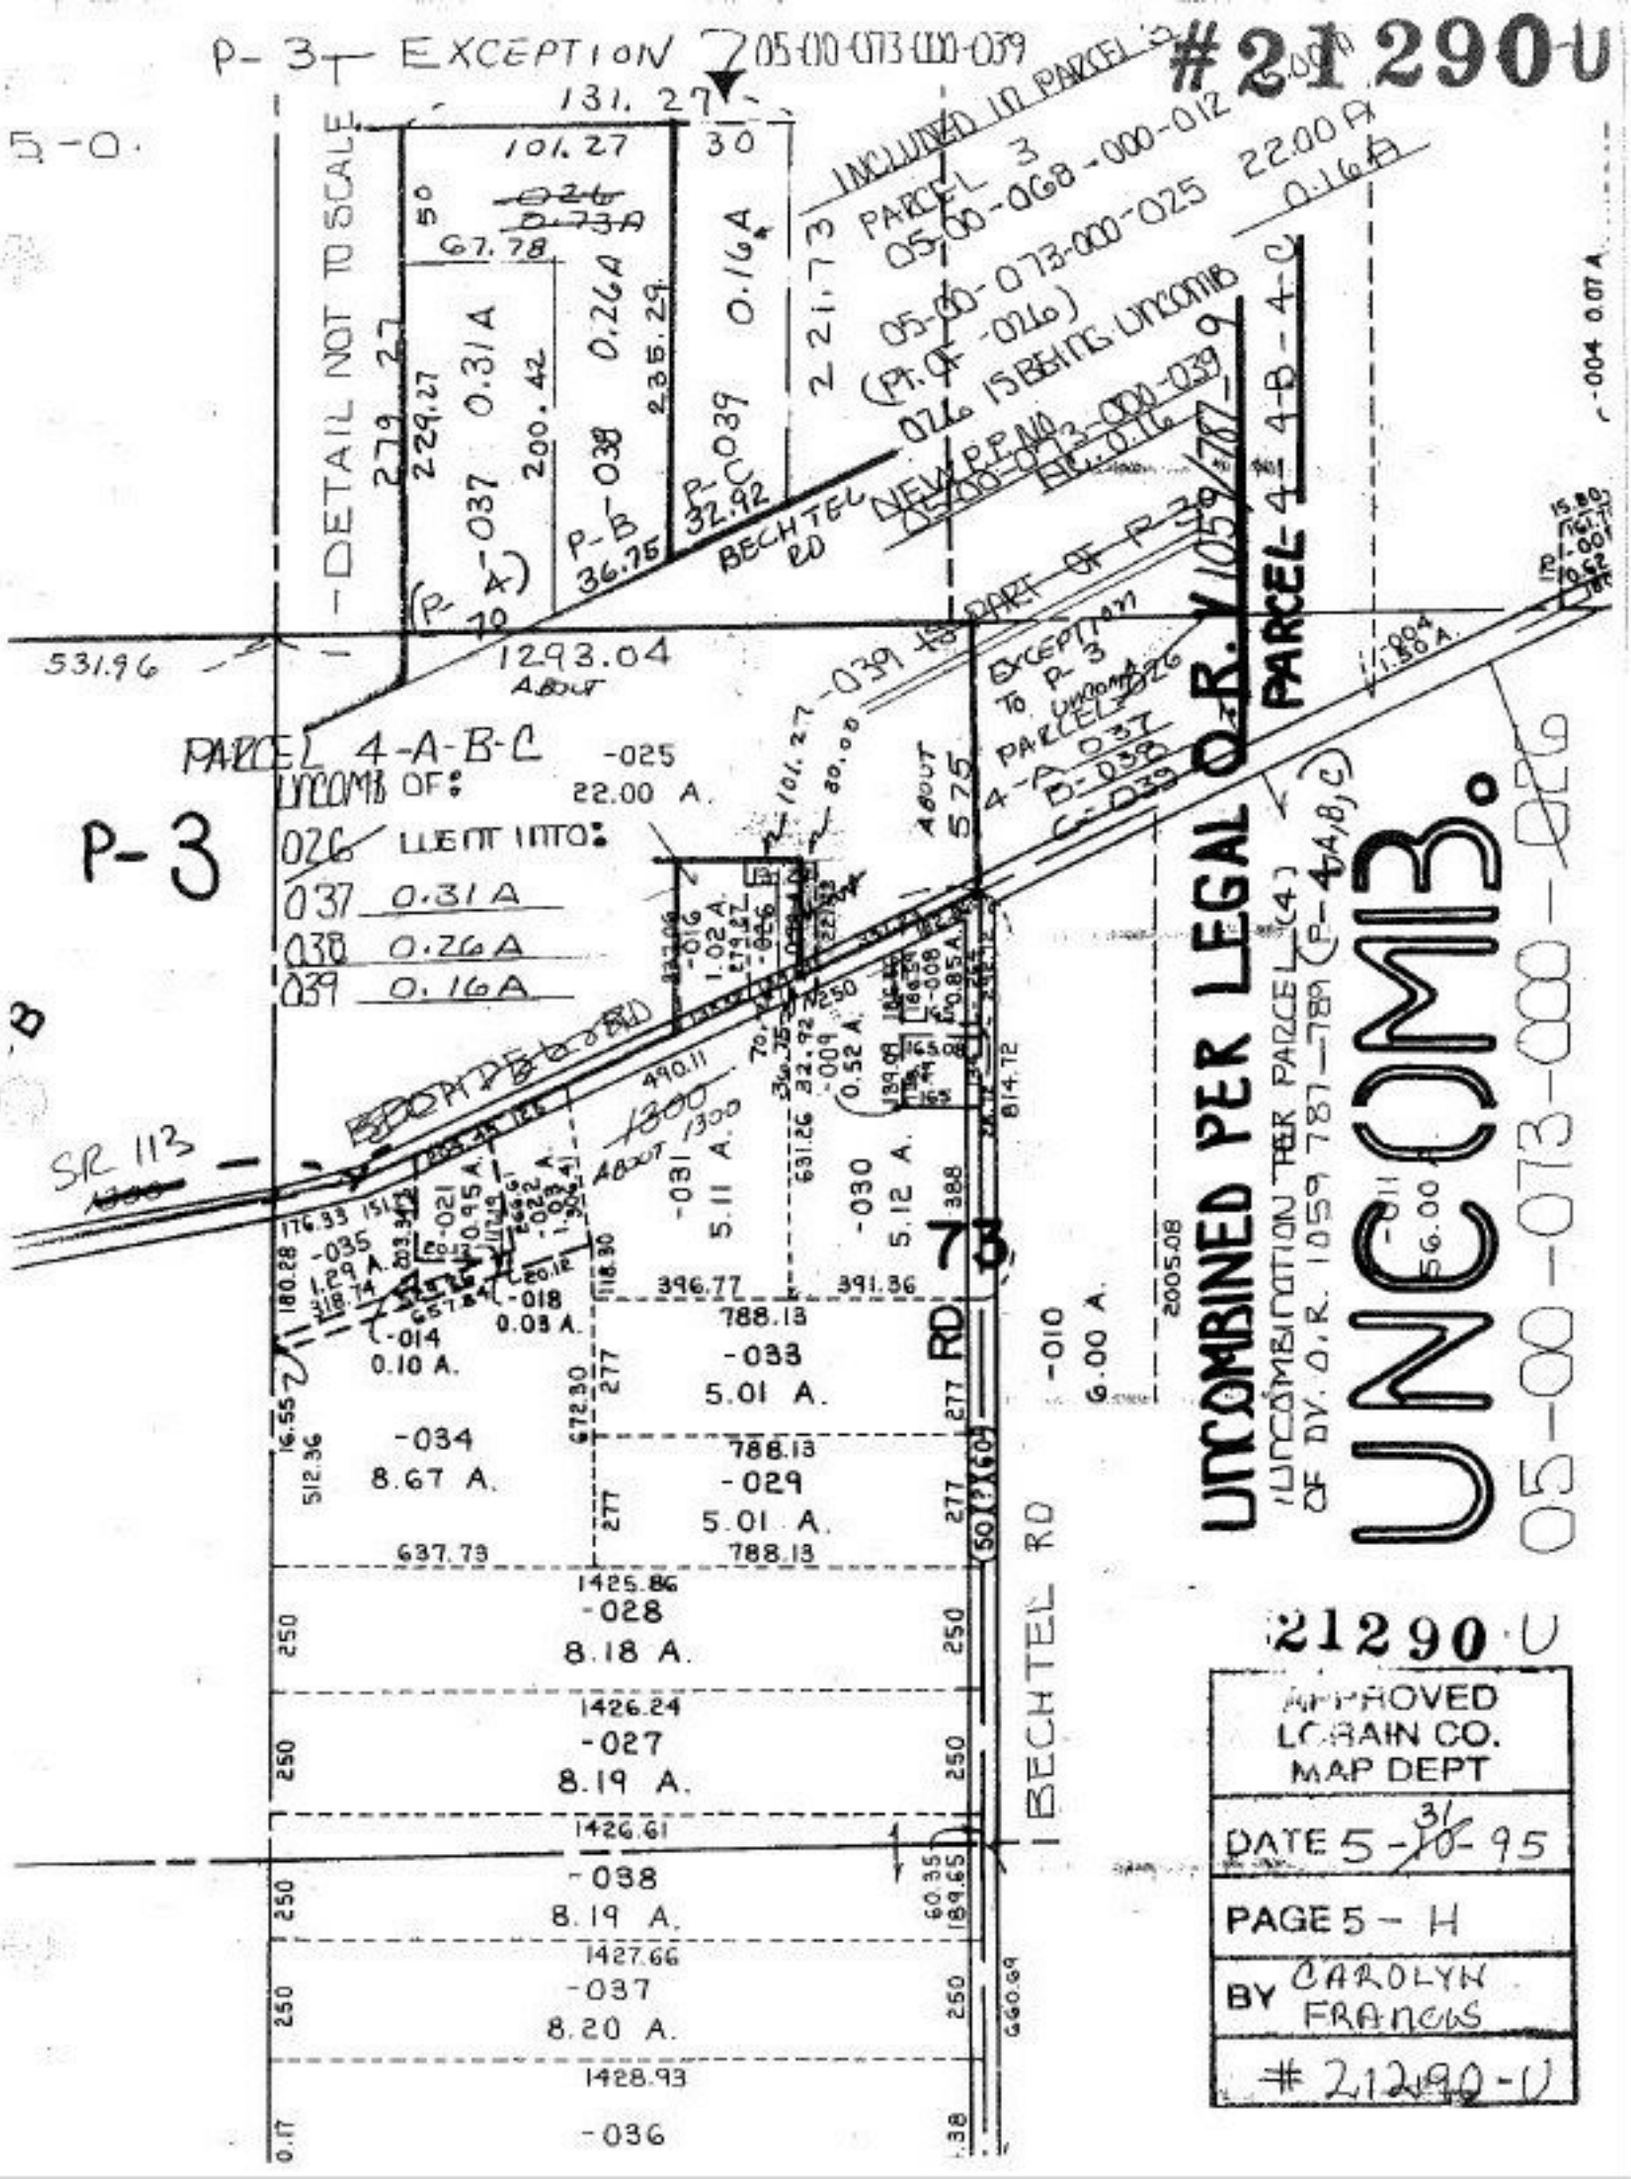

#21290-U
P-3 EXCEPTION 05-00-073-000-039
131.27
101.27
30
INCLUDED IN PARCEL 3
PARCEL 3
05-00-068-000-012
05-00-073-000-025 22.00 A
0.16 A
05-00-073-000-025
(PT. OF -026)
026 IS BEING UNCOMB
NEW P.P. NO.
05-00-073-000-039
BECHTEL RD
DETAIL NOT TO SCALE
0.31 A
0.26 A
0.16 A
P-B 36.75
P-C 32.92
(P-A) 70
531.96
1293.04 ABOUT
PARCEL 4-A-B-C
UNCOMB OF:
026 WENT INTO:
037 0.31 A
038 0.26 A
039 0.16 A
P-3
-025 22.00 A.
-039 IS PART OF P-3
EXCEPTION TO P-3
PARCEL 4-A 037
B-038
C-039
ABOUT 575
PARCEL 4-A-B-C
UNCOMBINED PER LEGAL O.R. 1059/787-9
UNCOMBINATION PER PARCEL (4) OF DV. O.R. 1059 787-789 (P-4A,B,C)
UNCOMB.
05-00-073-000-026
SR 113
-031 5.11 A.
-030 5.12 A.
-035 1.29 A.
-014 0.10 A.
-018 0.03 A.
-033 5.01 A.
-034 8.67 A.
-029 5.01 A.
-010 6.00 A.
-028 8.18 A.
-027 8.19 A.
-038 8.19 A.
-037 8.20 A.
-036
BECHTEL RD
73 RD
21290-U
APPROVED LORAIN CO. MAP DEPT
DATE 5-31-95
PAGE 5-H
BY CAROLYN FRANCIS
#21290-U