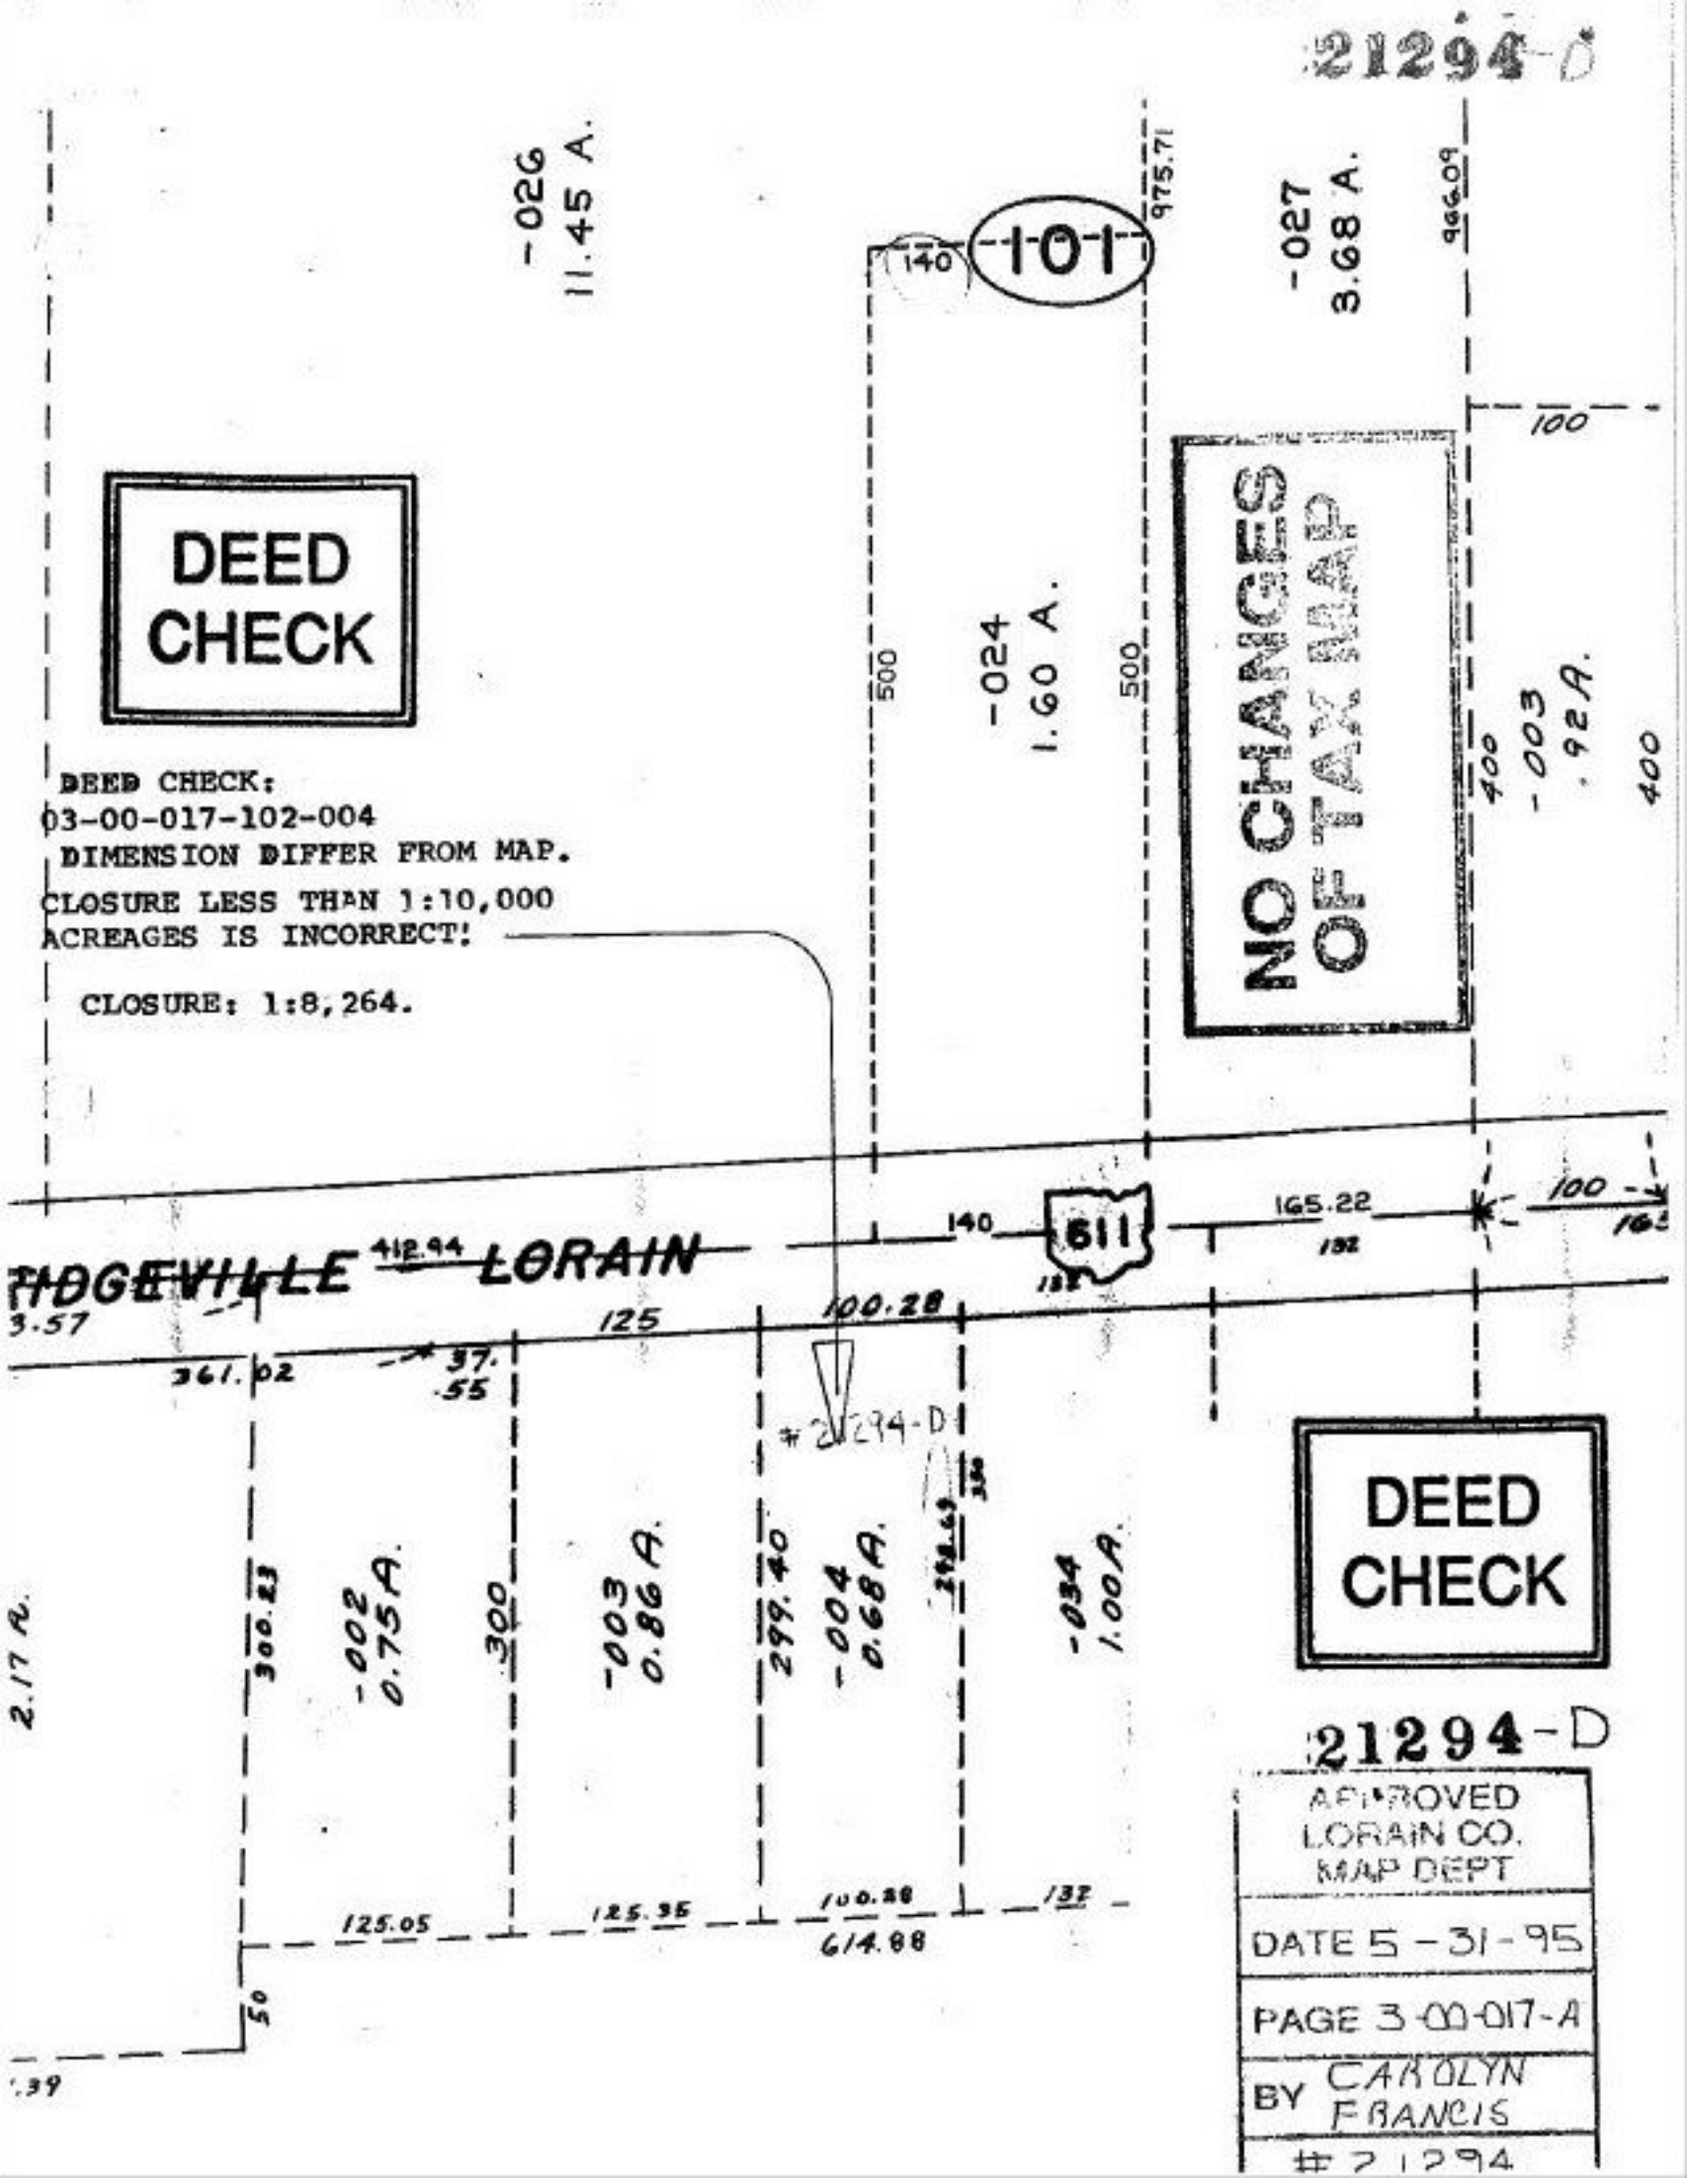
21294-D
-026
11.45 A.
101
140
975.71
-027
3.68 A.
966.09
100
DEED CHECK
500
-024
1.60 A.
500
NO CHANGES OF TAX MAP
400
-003
.92 A.
400
DEED CHECK:
03-00-017-102-004
DIMENSION DIFFER FROM MAP.
CLOSURE LESS THAN 1:10,000
ACREAGES IS INCORRECT!
CLOSURE: 1:8,264.
140
611
165.22
132
100
RIDGEVILLE
412.94
LORAIN
3.57
125
100.28
361.02
37.
.55
#21294-D
DEED CHECK
2.17 A.
300.23
-002
0.75 A.
300
-003
0.86 A.
299.40
-004
0.68 A.
-034
1.00 A.
125.05
125.35
100.28
132
614.88
50
.39
21294-D
APPROVED
LORAIN CO.
MAP DEPT
DATE 5-31-95
PAGE 3-00-017-A
BY CAROLYN FRANCIS
#21294