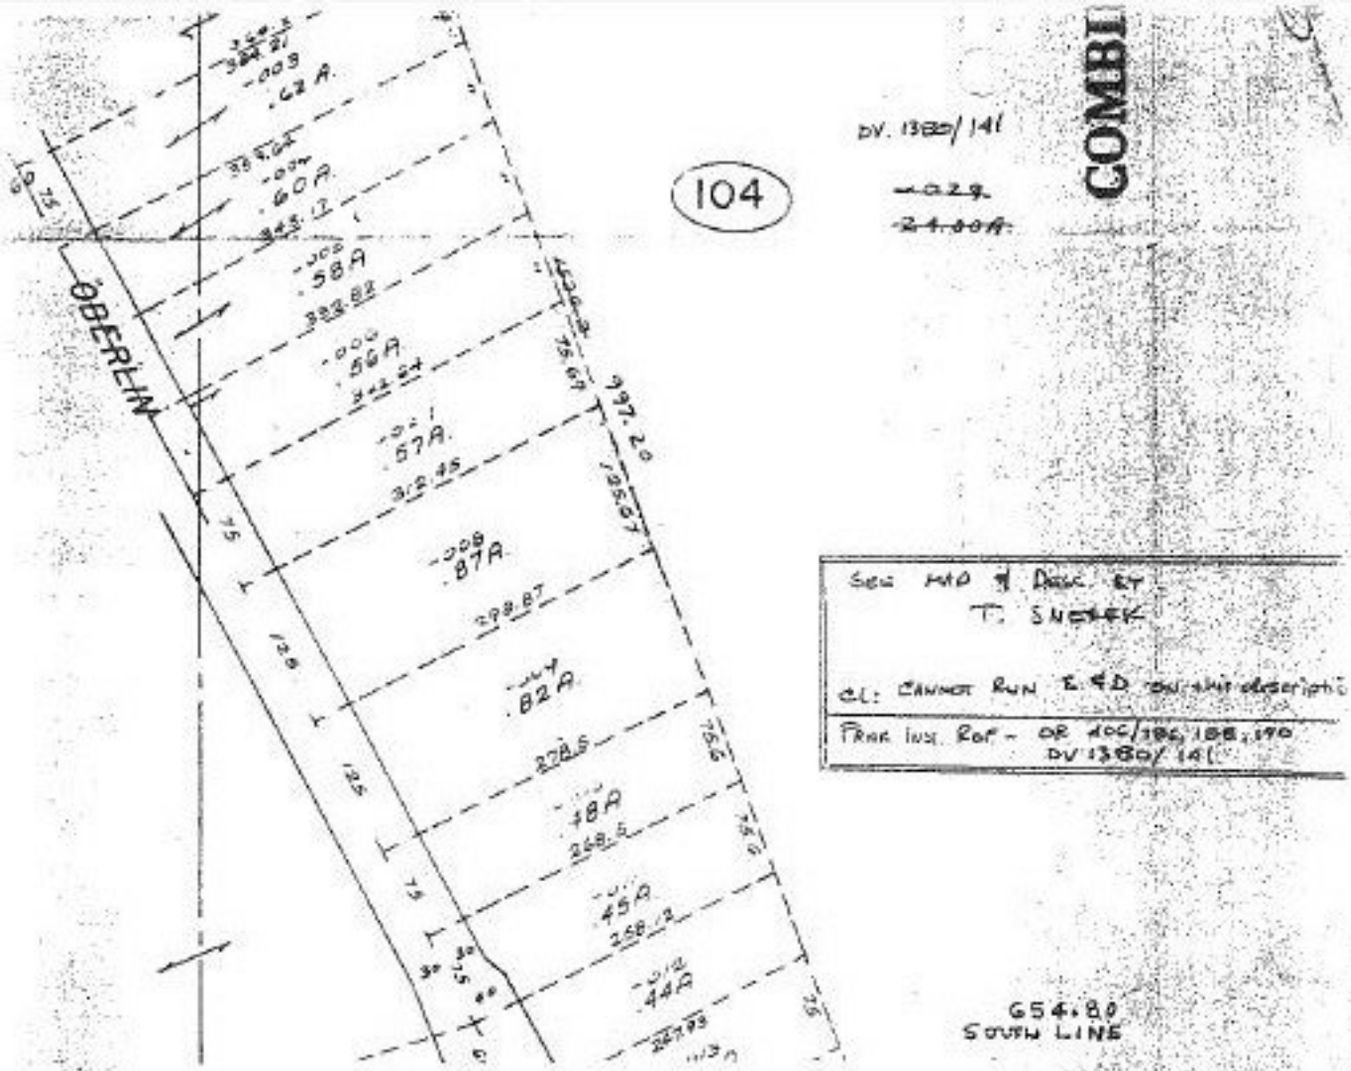
104
OBERLIN
COMBI
DV. 1380/141
-029
24.00A
997.20
654.80
SOUTH LINE
Sec 140 T Desc ET
T: SNEEK
CL: CANNOT RUN E-W on this description
Prior Inst. Ref - OR 100/186, 188, 190
DV 1380/141

21292