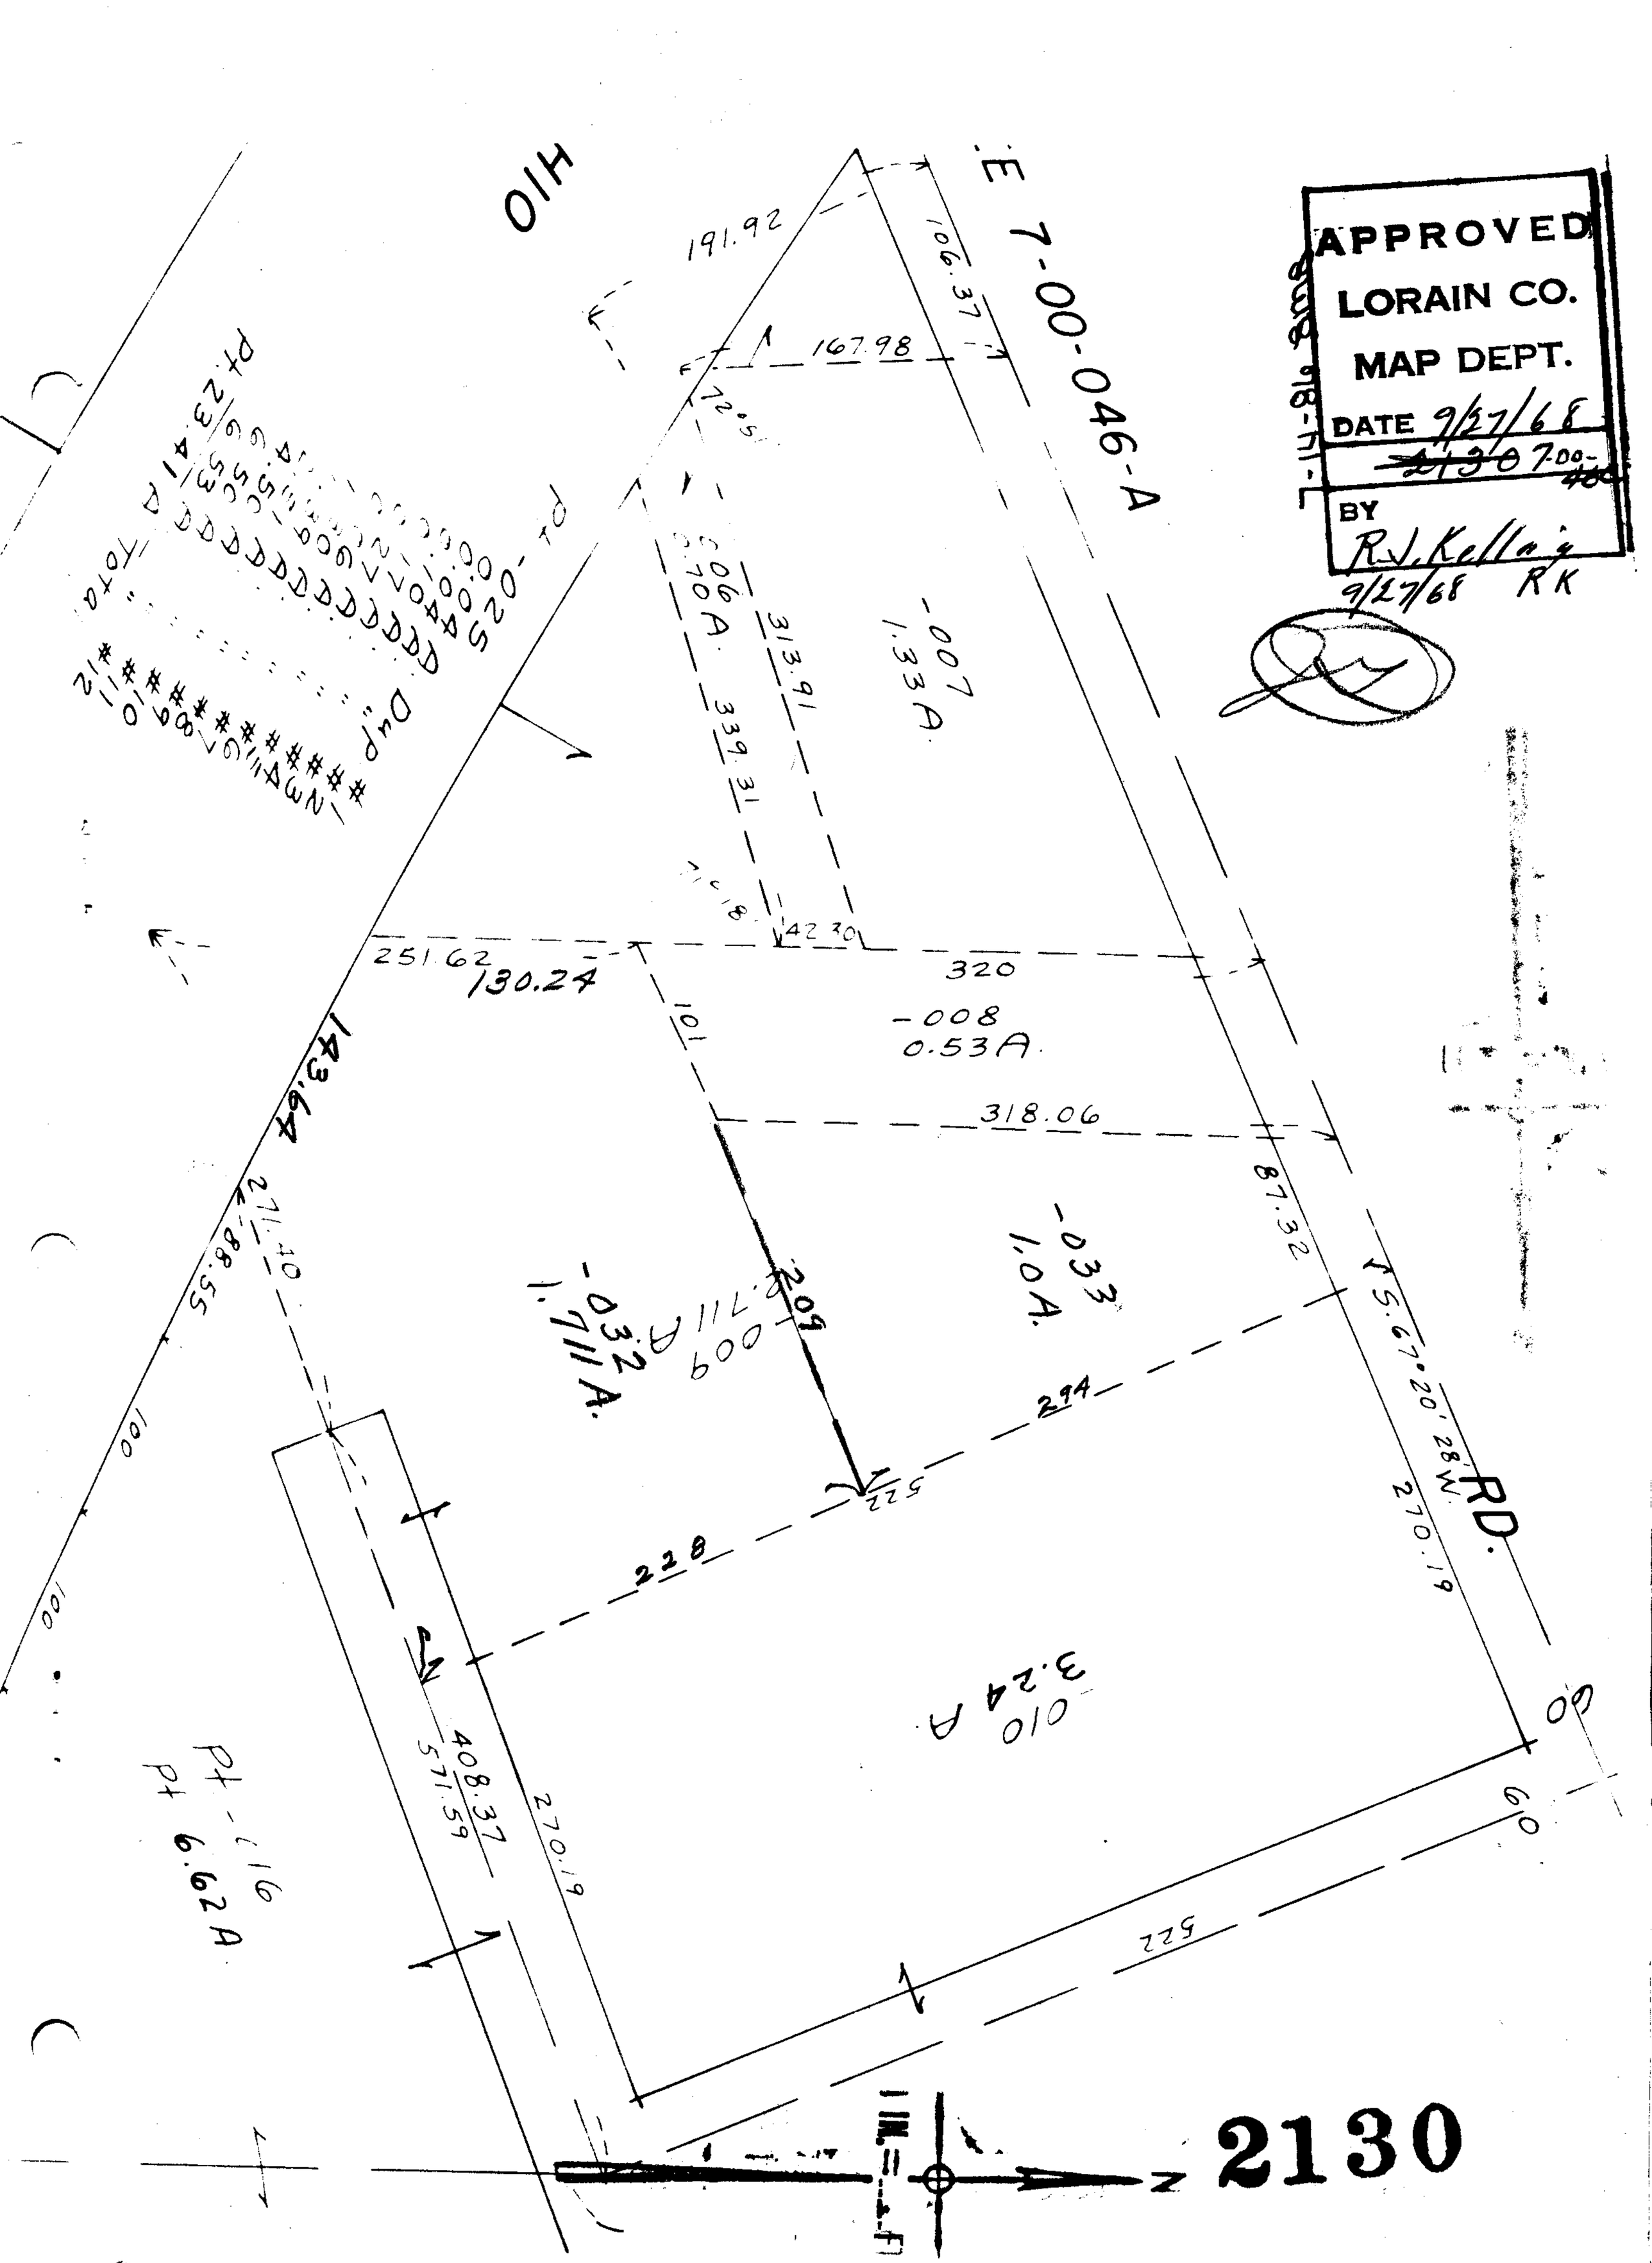
APPROVED
LORAIN CO.
MAP DEPT.
DATE 9/27/68
BY R.J. Kellar
9/27/68 RK
7-00-046-A
191.92
106.37
167.98
72.5
313.91
339.31
-007
1.33A.
251.62
130.24
320
-008
0.53A.
318.06
87.32
-033
1.0A.
-032
1.711A.
-009
0.711A.
294
228
222
209
S 67° 20' 28" W.
270.19
RD.
271.40
288.55
143.64
100
101
408.37
571.59
270.19
-010
3.24A.
522
60
Pt-116
Pt 6.62A
2130