21300-D

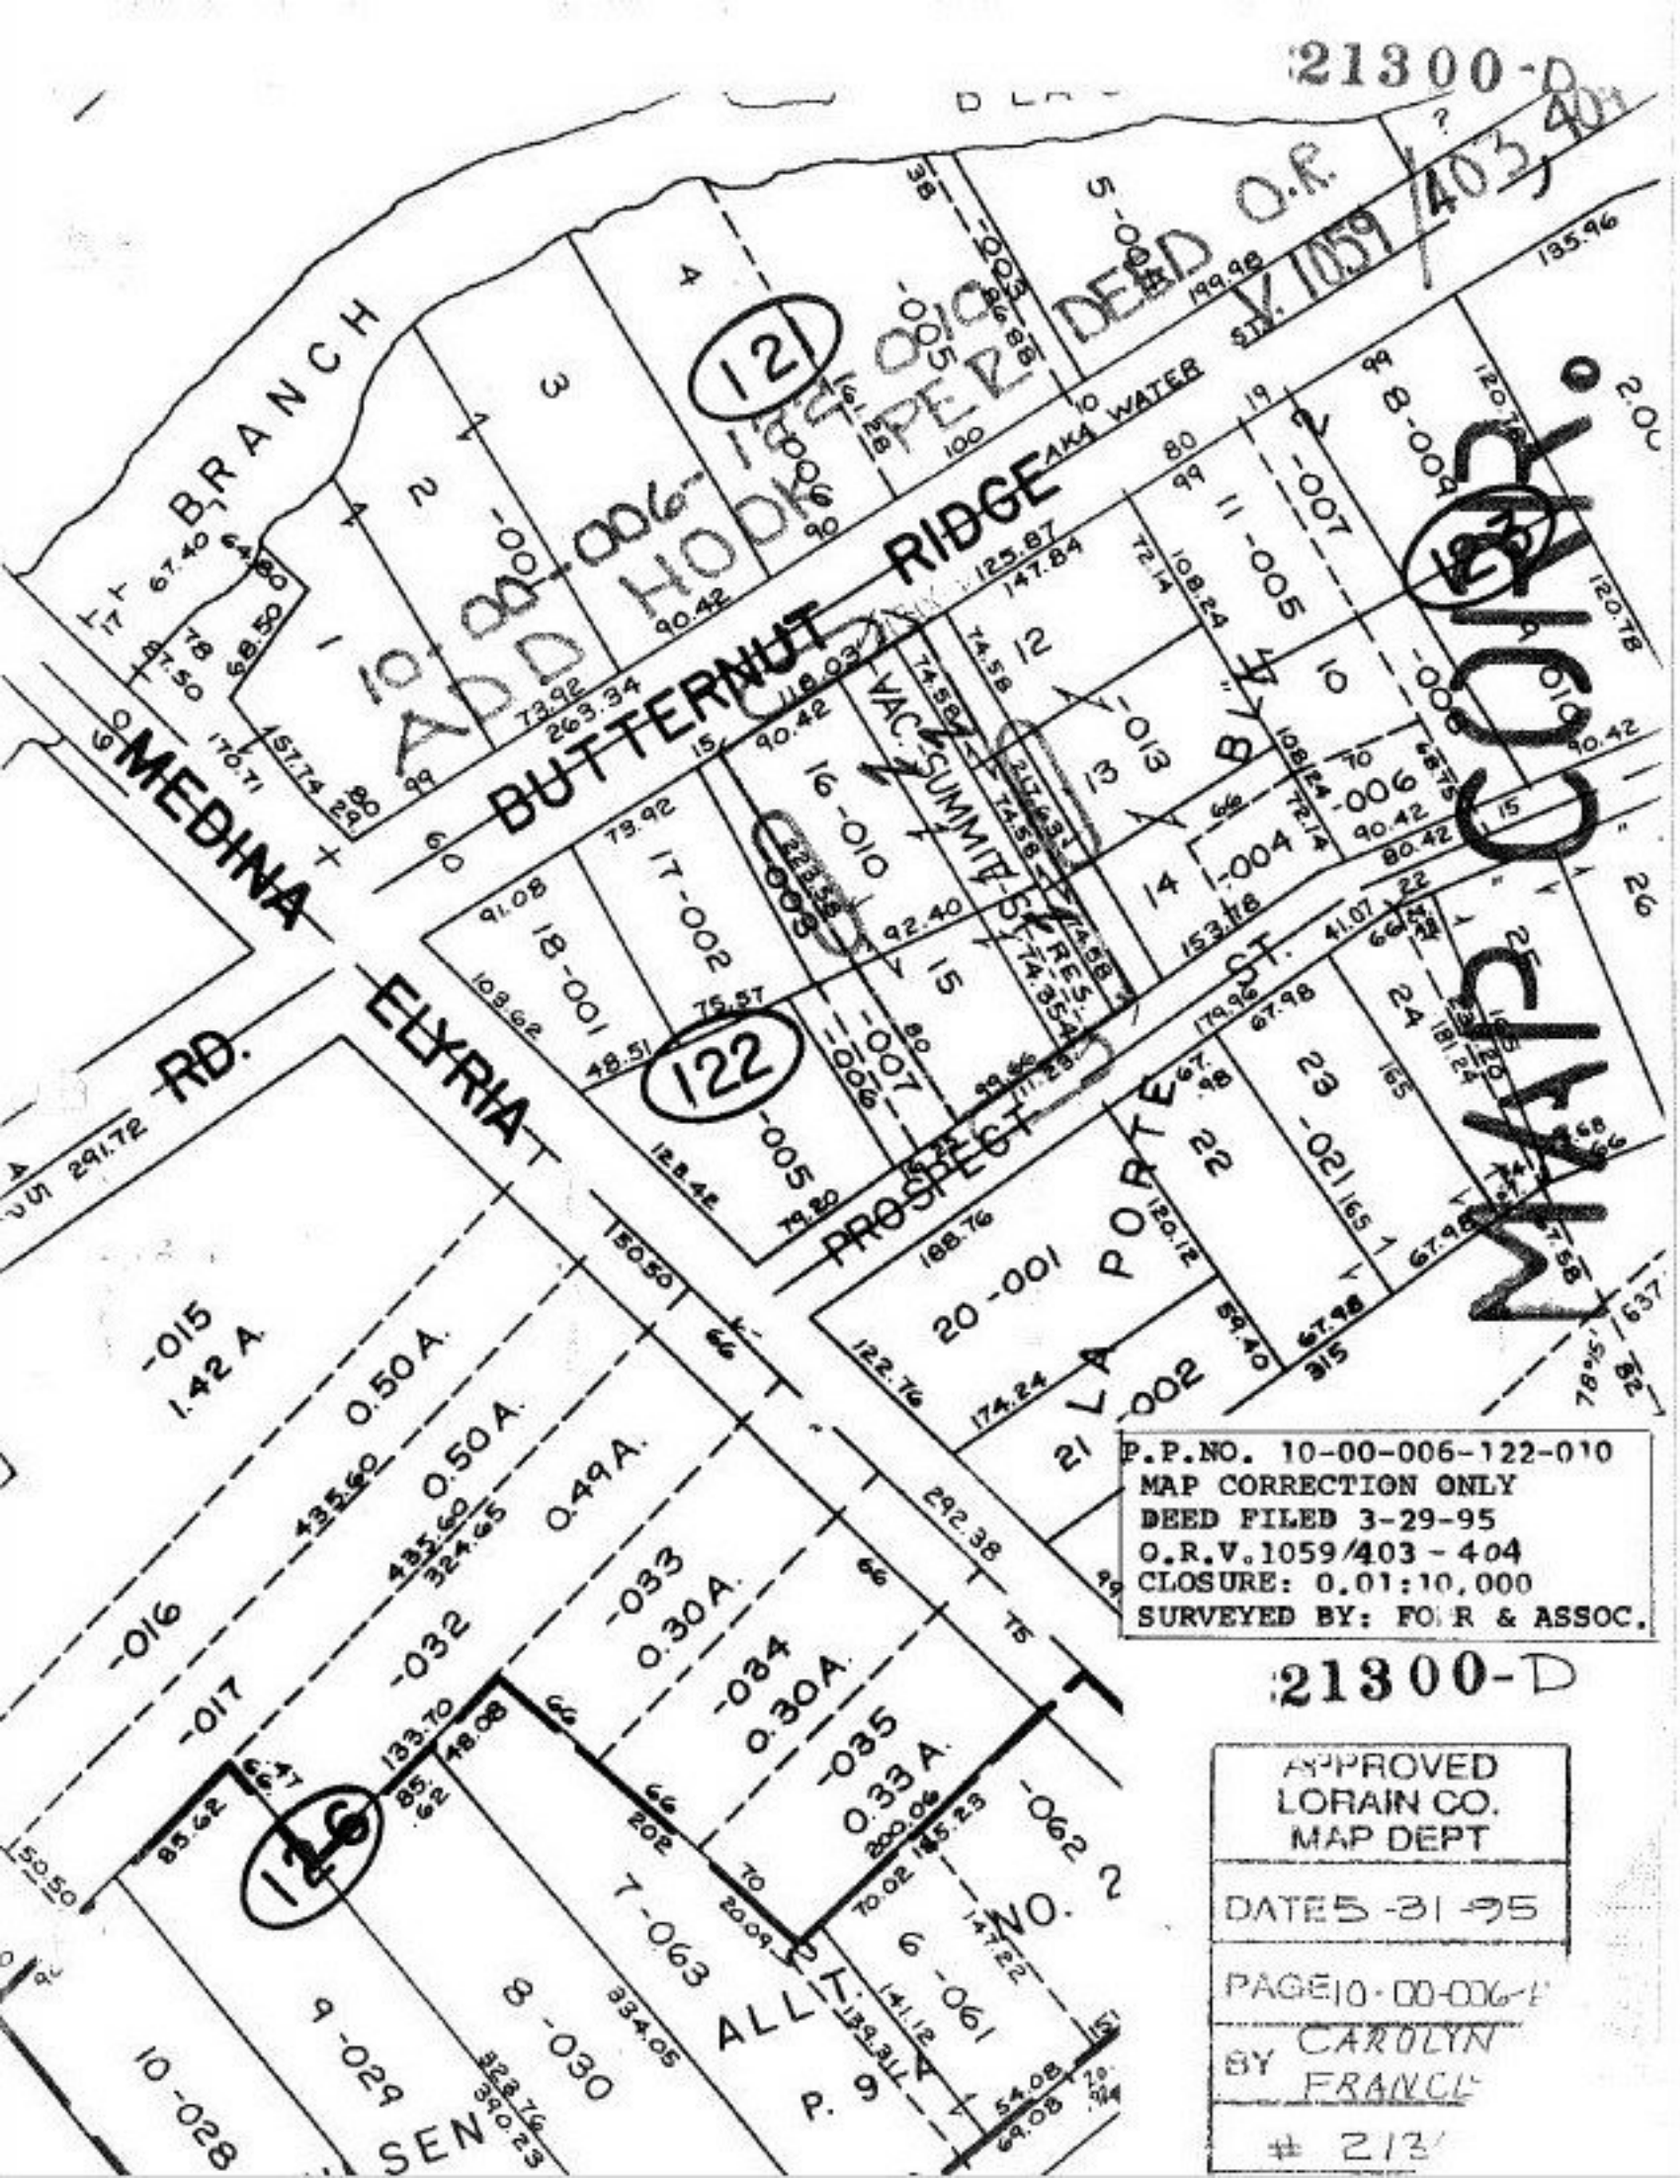

P.P.NO. 10-00-006-122-010
MAP CORRECTION ONLY
DEED FILED 3-29-95
O.R.V.1059/403 - 404
CLOSURE: 0.01:10,000
SURVEYED BY: FO R & ASSOC.

21300-D

APPROVED
LORAIN CO.
MAP DEPT

DATE 5-31-95

PAGE 10-00-006-

BY CAROLYN FRANCE

213