21300-D

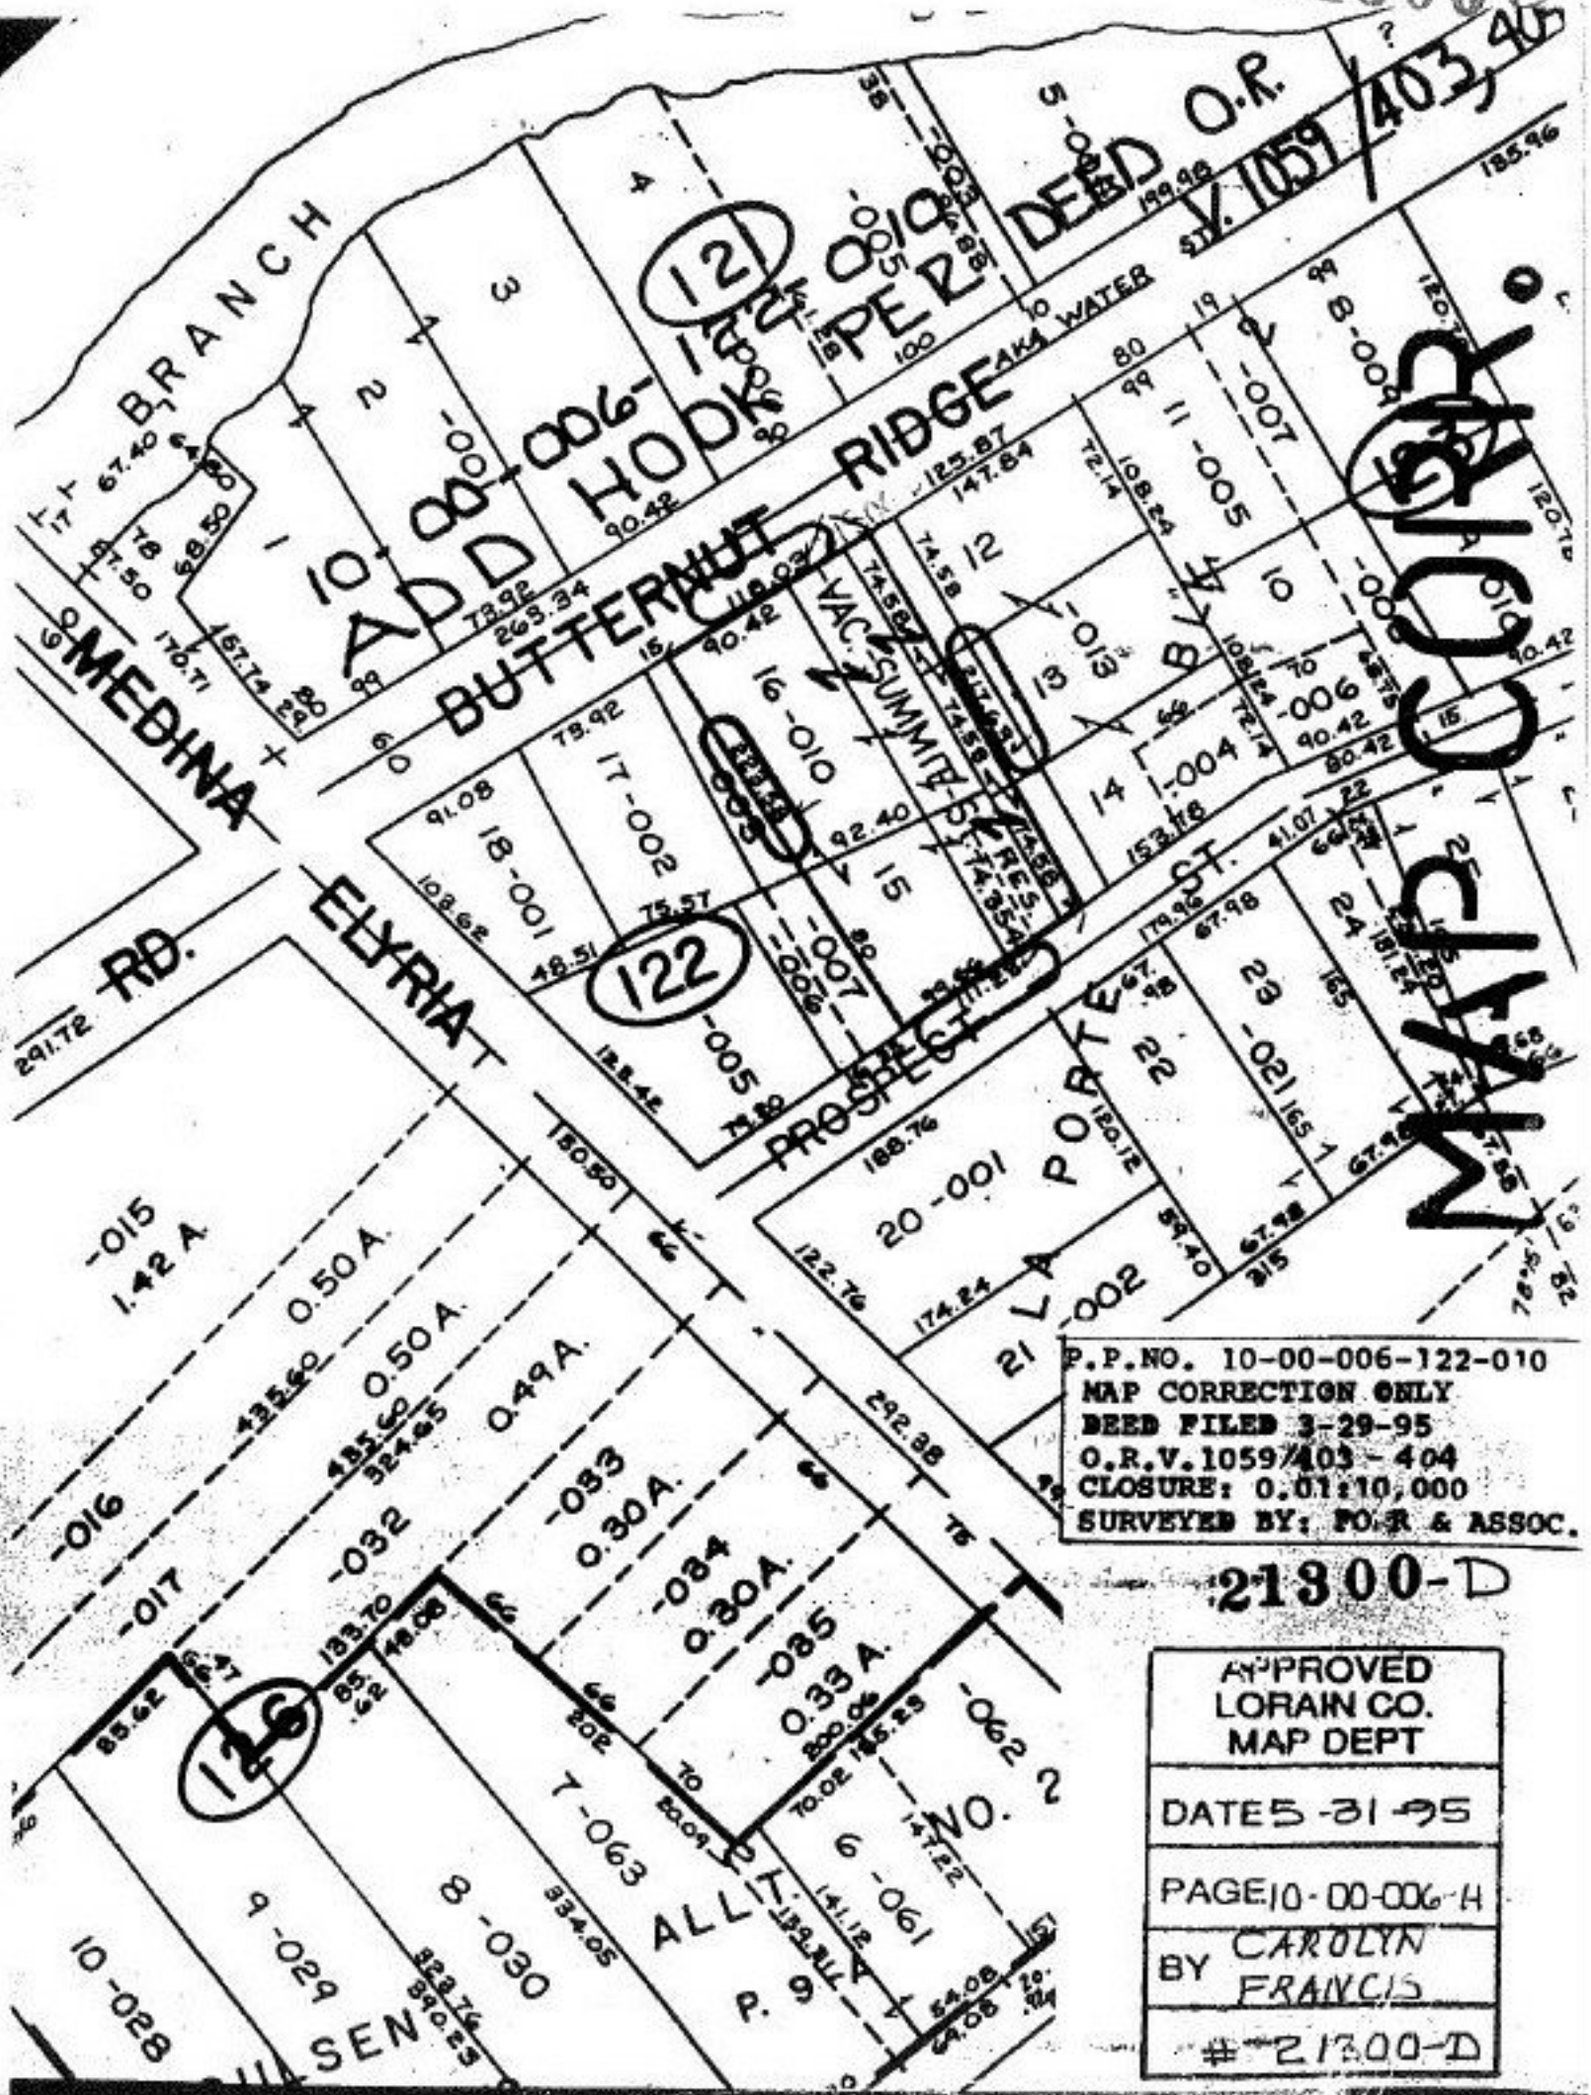

BRANCH
MEDINA
ELYRIA
RD.
BUTTERNUT RIDGE
ADD HOOK PER DEED O.R. V. 1059/403, 404
10-00-006-122-010
AKA WATER ST.
VAC. SUMMIT ST.
PROSPECT ST.
LA PORTE ST.
MAP CORR.
121
122
126
P.P.NO. 10-00-006-122-010
MAP CORRECTION ONLY
DEED FILED 3-29-95
O.R.V.1059/403 - 404
CLOSURE: 0.01:10,000
SURVEYED BY: FO.R & ASSOC.
21300-D
APPROVED
LORAIN CO.
MAP DEPT
DATE 5-31-95
PAGE 10-00-006-H
BY CAROLYN FRANCIS
21300-D