21302

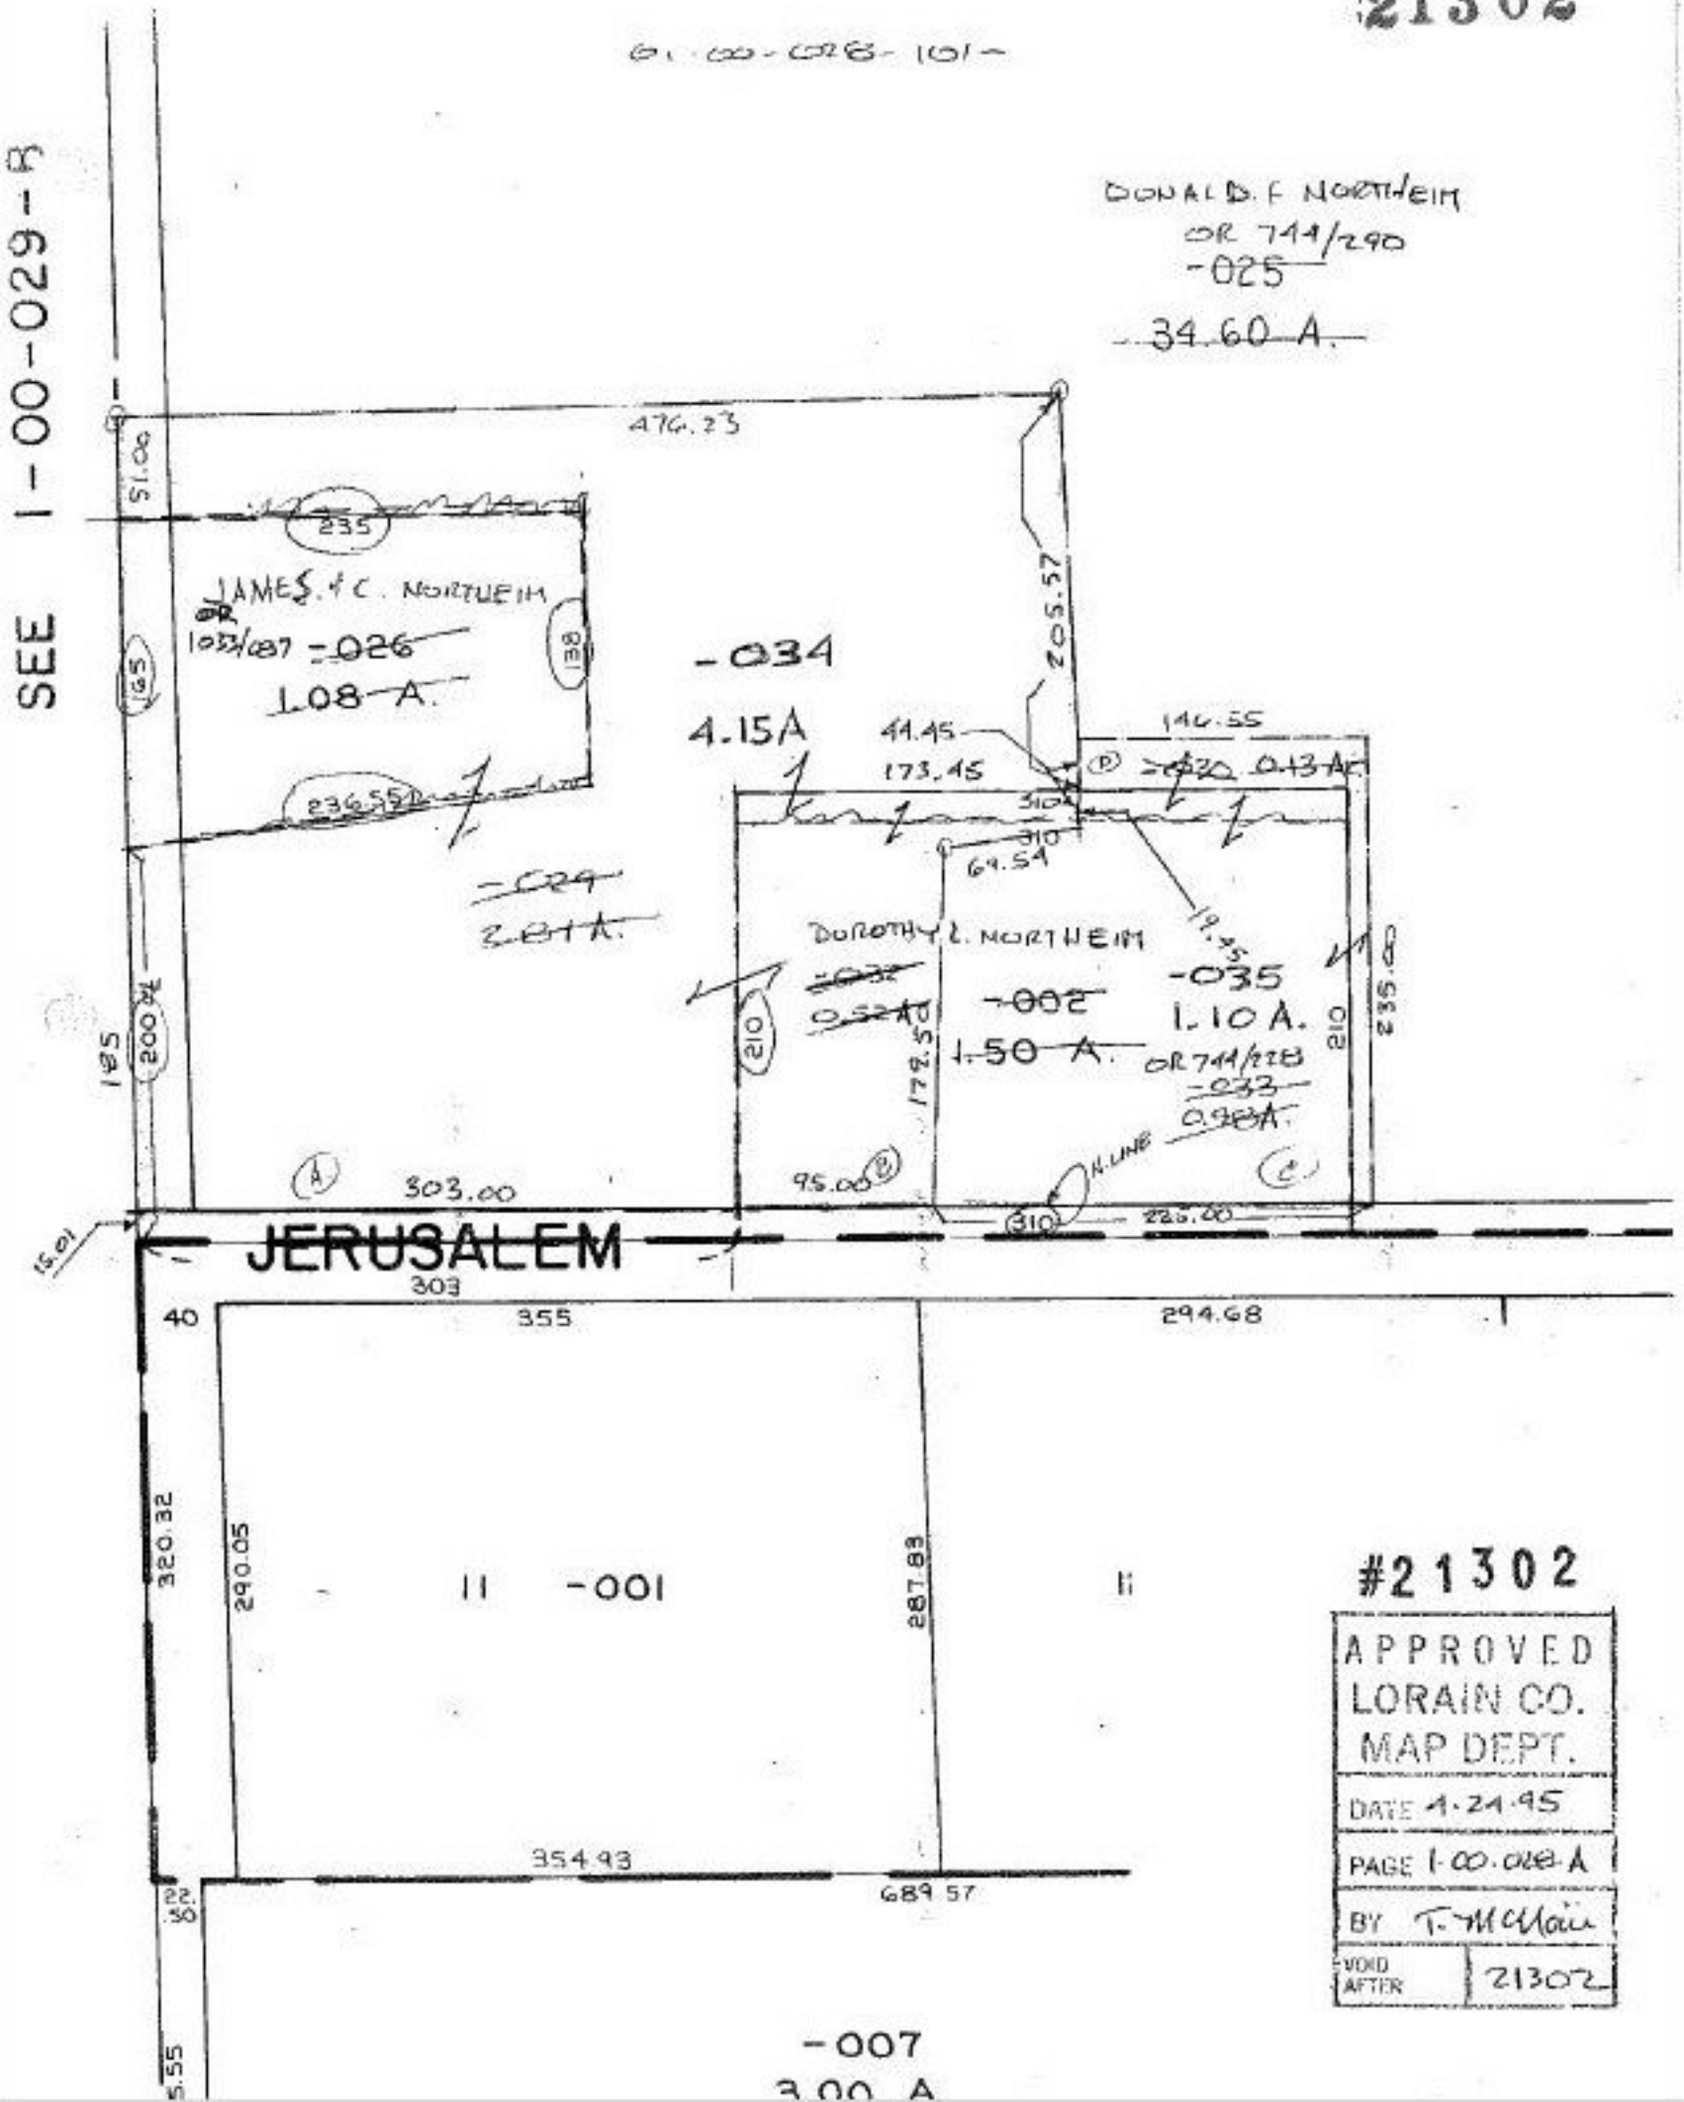

#21302

APPROVED
LORAIN CO.
MAP DEPT.

DATE 4-24-95

PAGE 1-00-028-A

BY T. McMain

VOID AFTER 21302