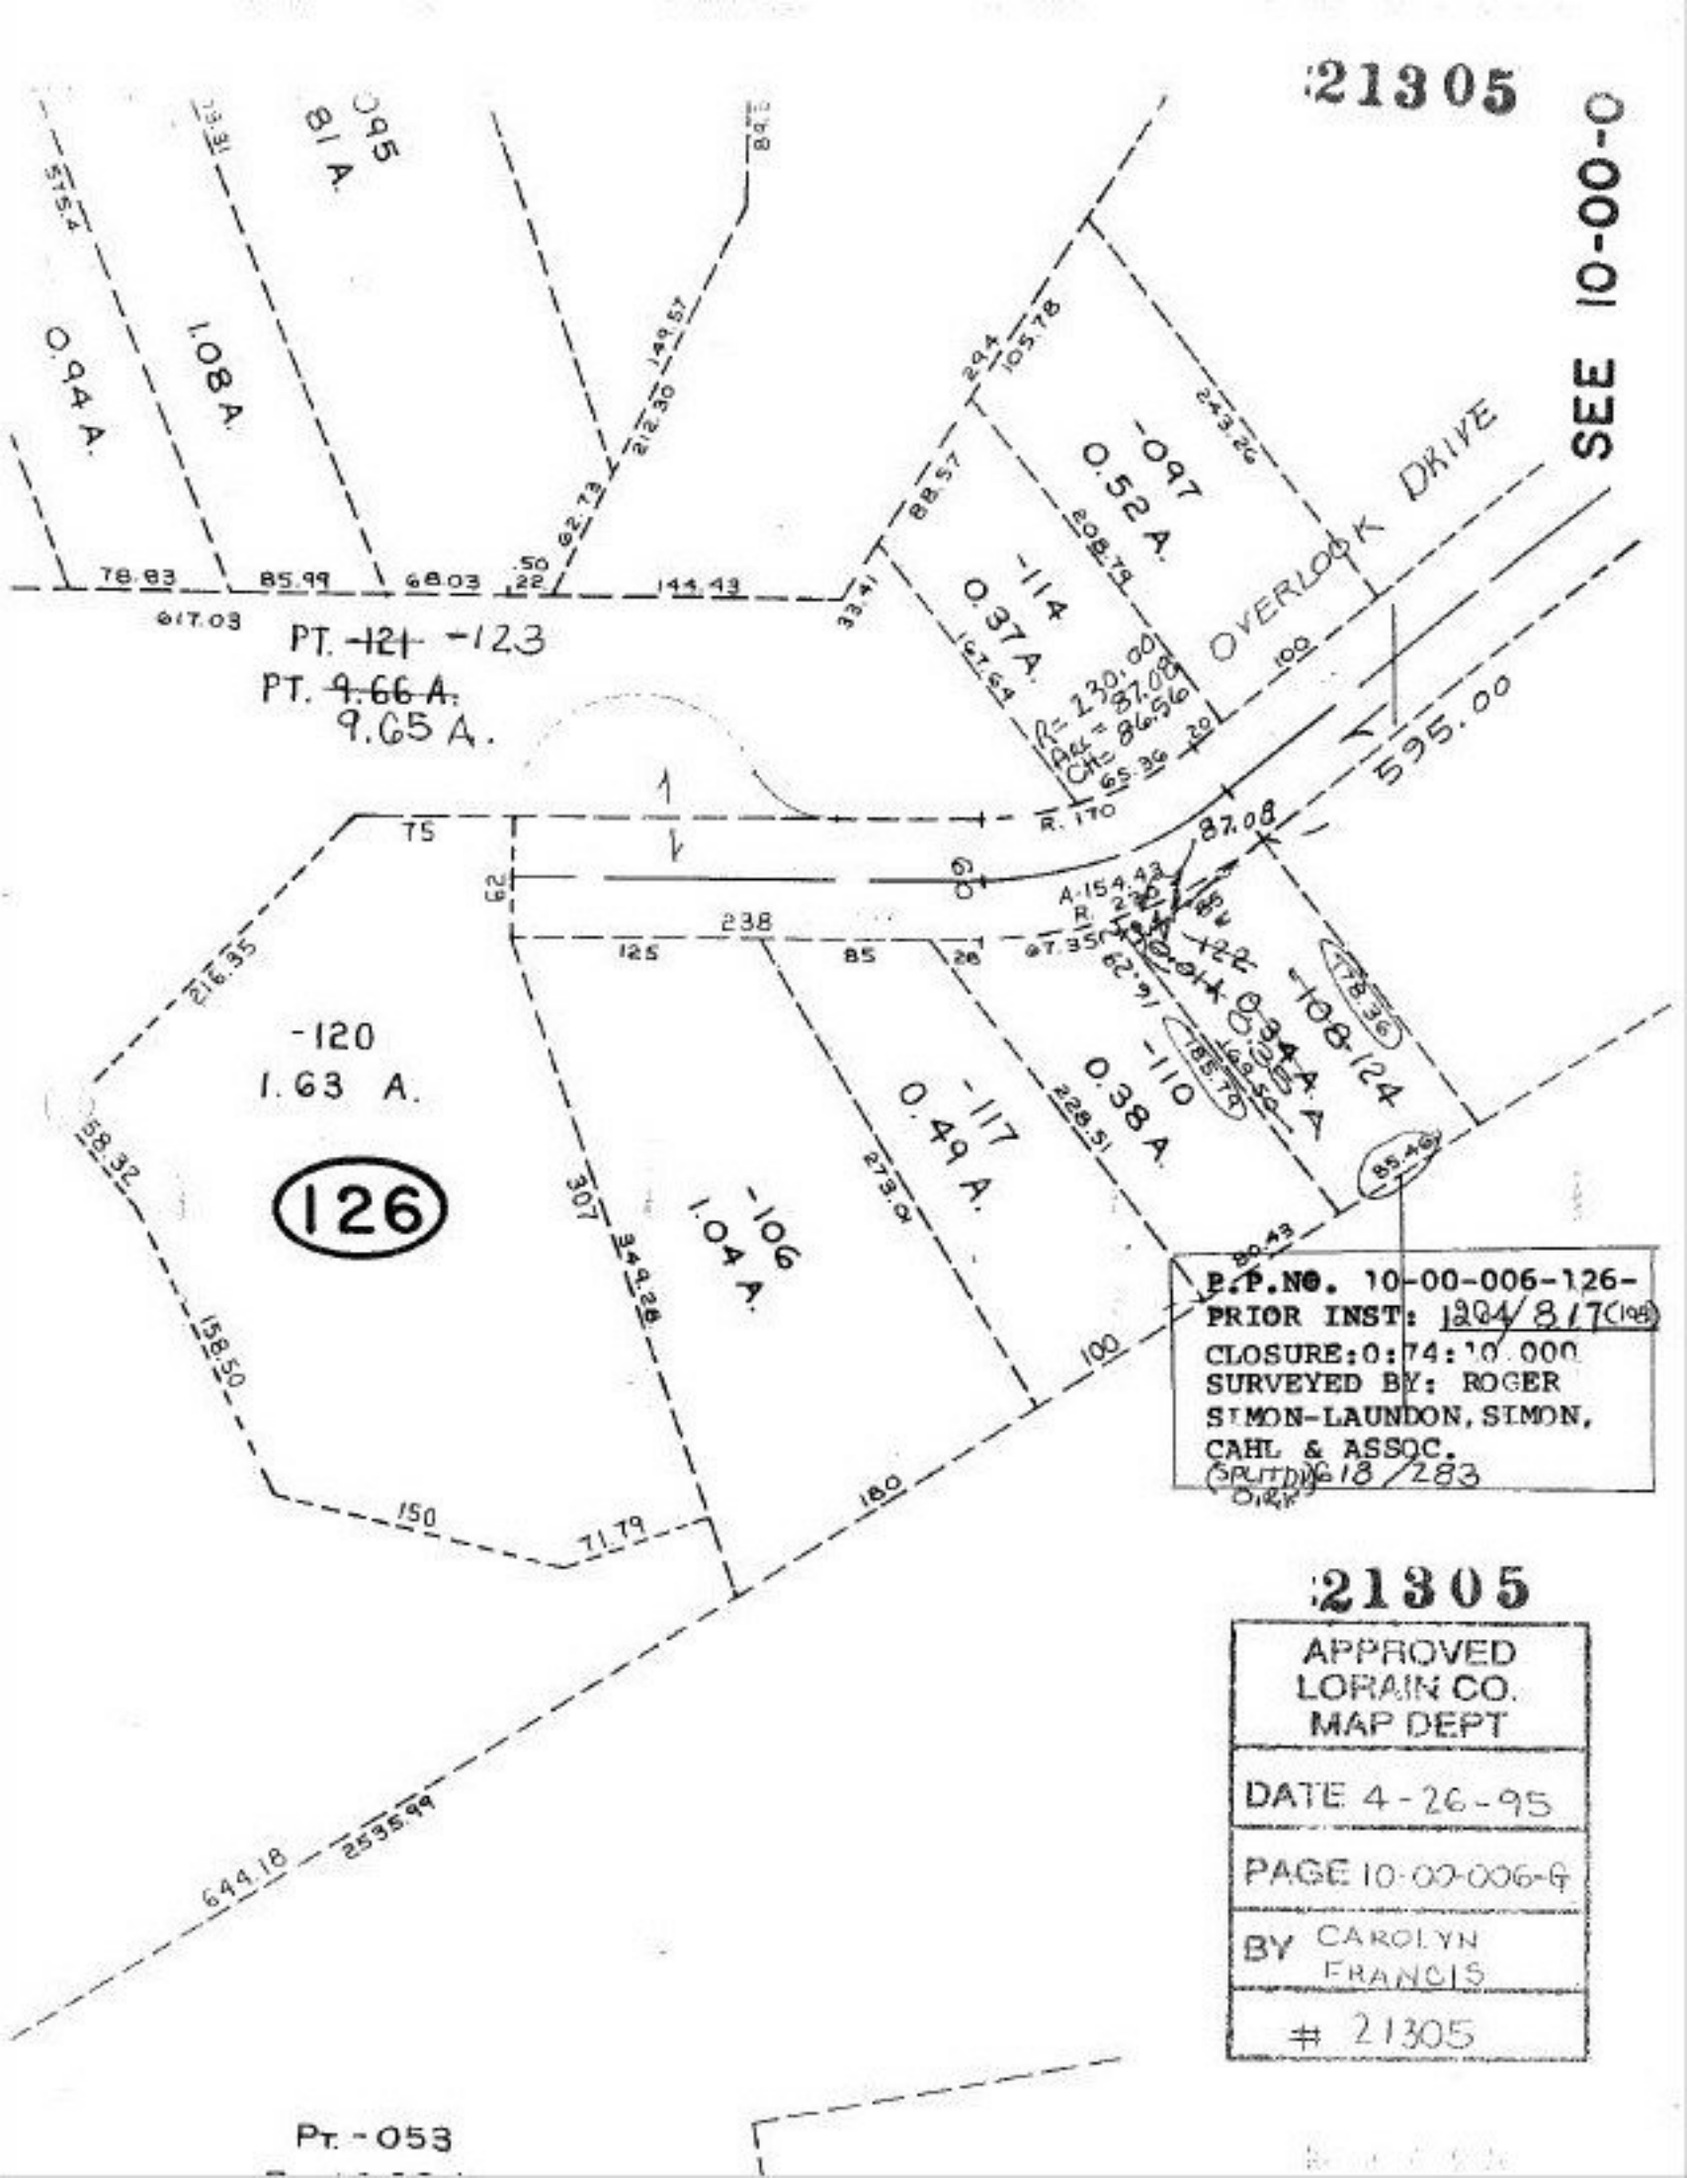
21305
SEE 10-00-0
0.94 A.
1.08 A.
0.95
81 A.
-097
0.52 A.
-114
0.37 A.
OVERLOOK DRIVE
R= 230.00
Arc= 87.08
Ch= 86.56
595.00
PT. ~~-121~~ -123
PT. ~~9.66 A.~~
9.65 A.
-120
1.63 A.
126
-106
1.04 A.
-117
0.49 A.
-110
0.38 A.
-108
124
-122
0.34 A.
PT. -053
P.P.NO. 10-00-006-126-
PRIOR INST: 1204/817(108)
CLOSURE:0:74:10.000
SURVEYED BY: ROGER
SIMON-LAUNDON, SIMON,
CAHL & ASSOC.
(SPLIT DIV) 618/283
21305
APPROVED
LORAIN CO.
MAP DEPT
DATE 4-26-95
PAGE 10-00-006-G
BY CAROLYN FRANCIS
21305