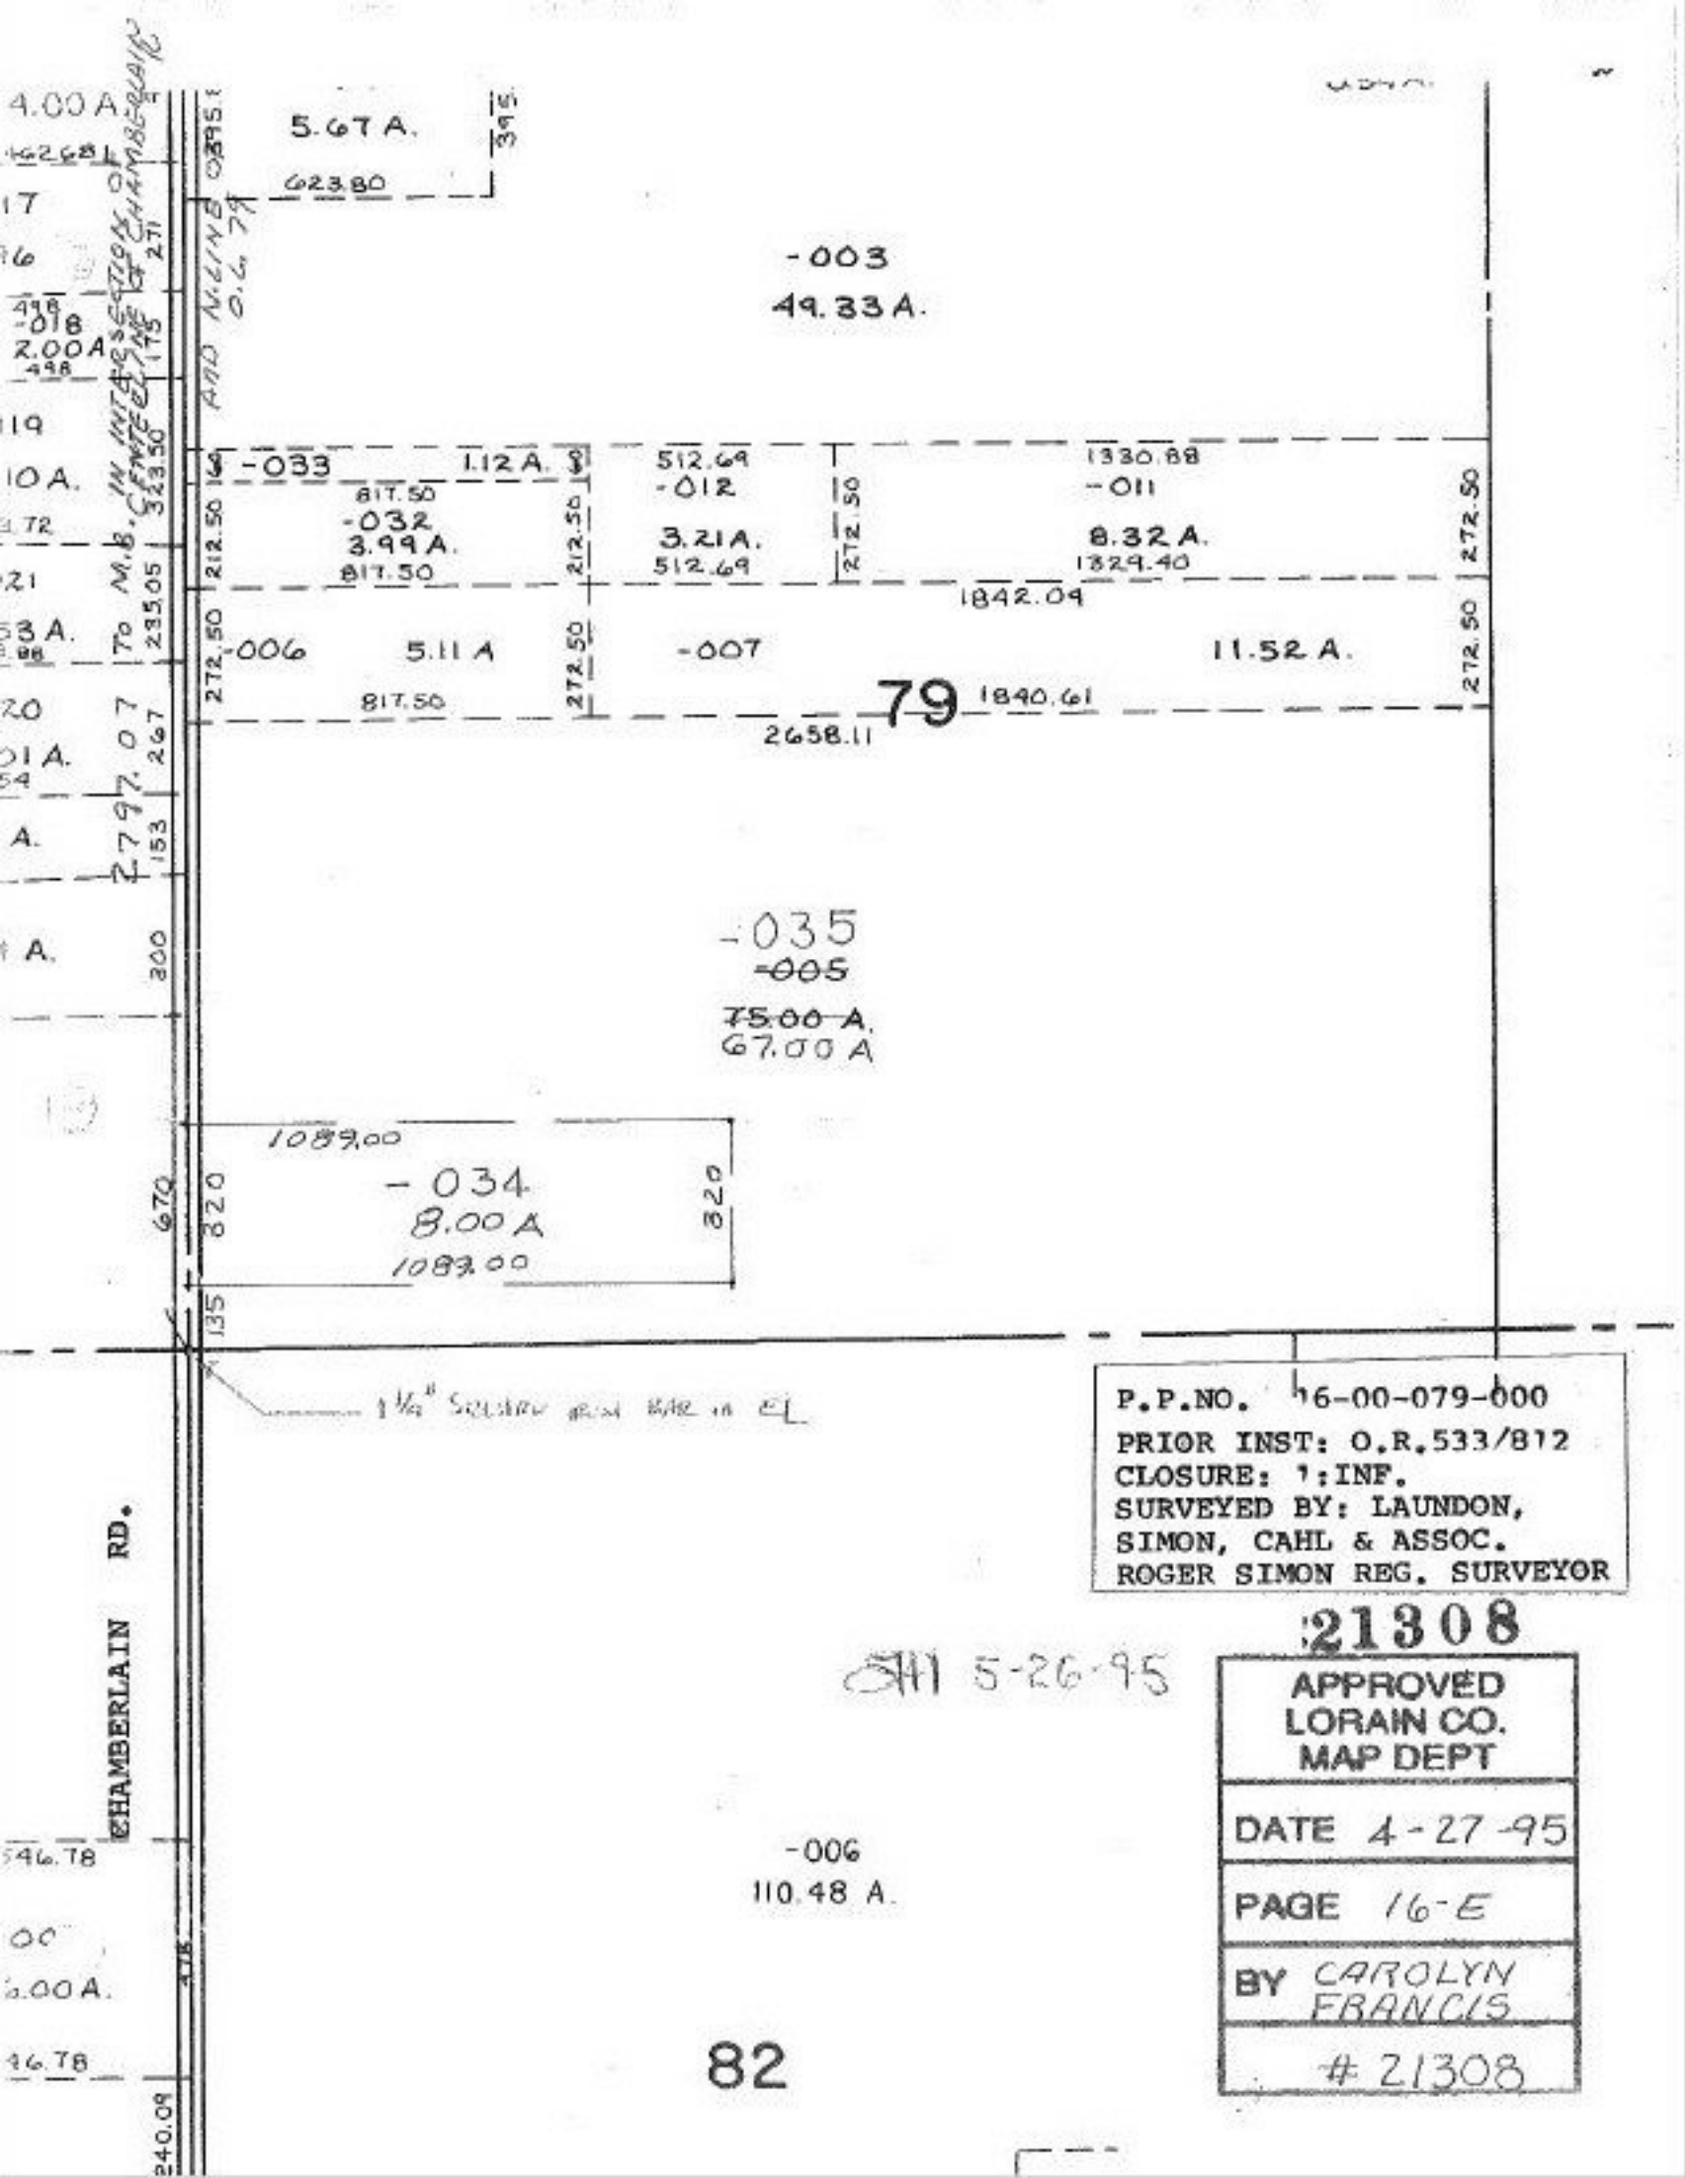

P.P.NO. 16-00-079-000
PRIOR INST: O.R.533/812
CLOSURE: 1:INF.
SURVEYED BY: LAUNDON, SIMON, CAHL & ASSOC.
ROGER SIMON REG. SURVEYOR

21308

5-26-95

APPROVED
LORAIN CO.
MAP DEPT

DATE 4-27-95

PAGE 16-E

BY CAROLYN FRANCIS

21308