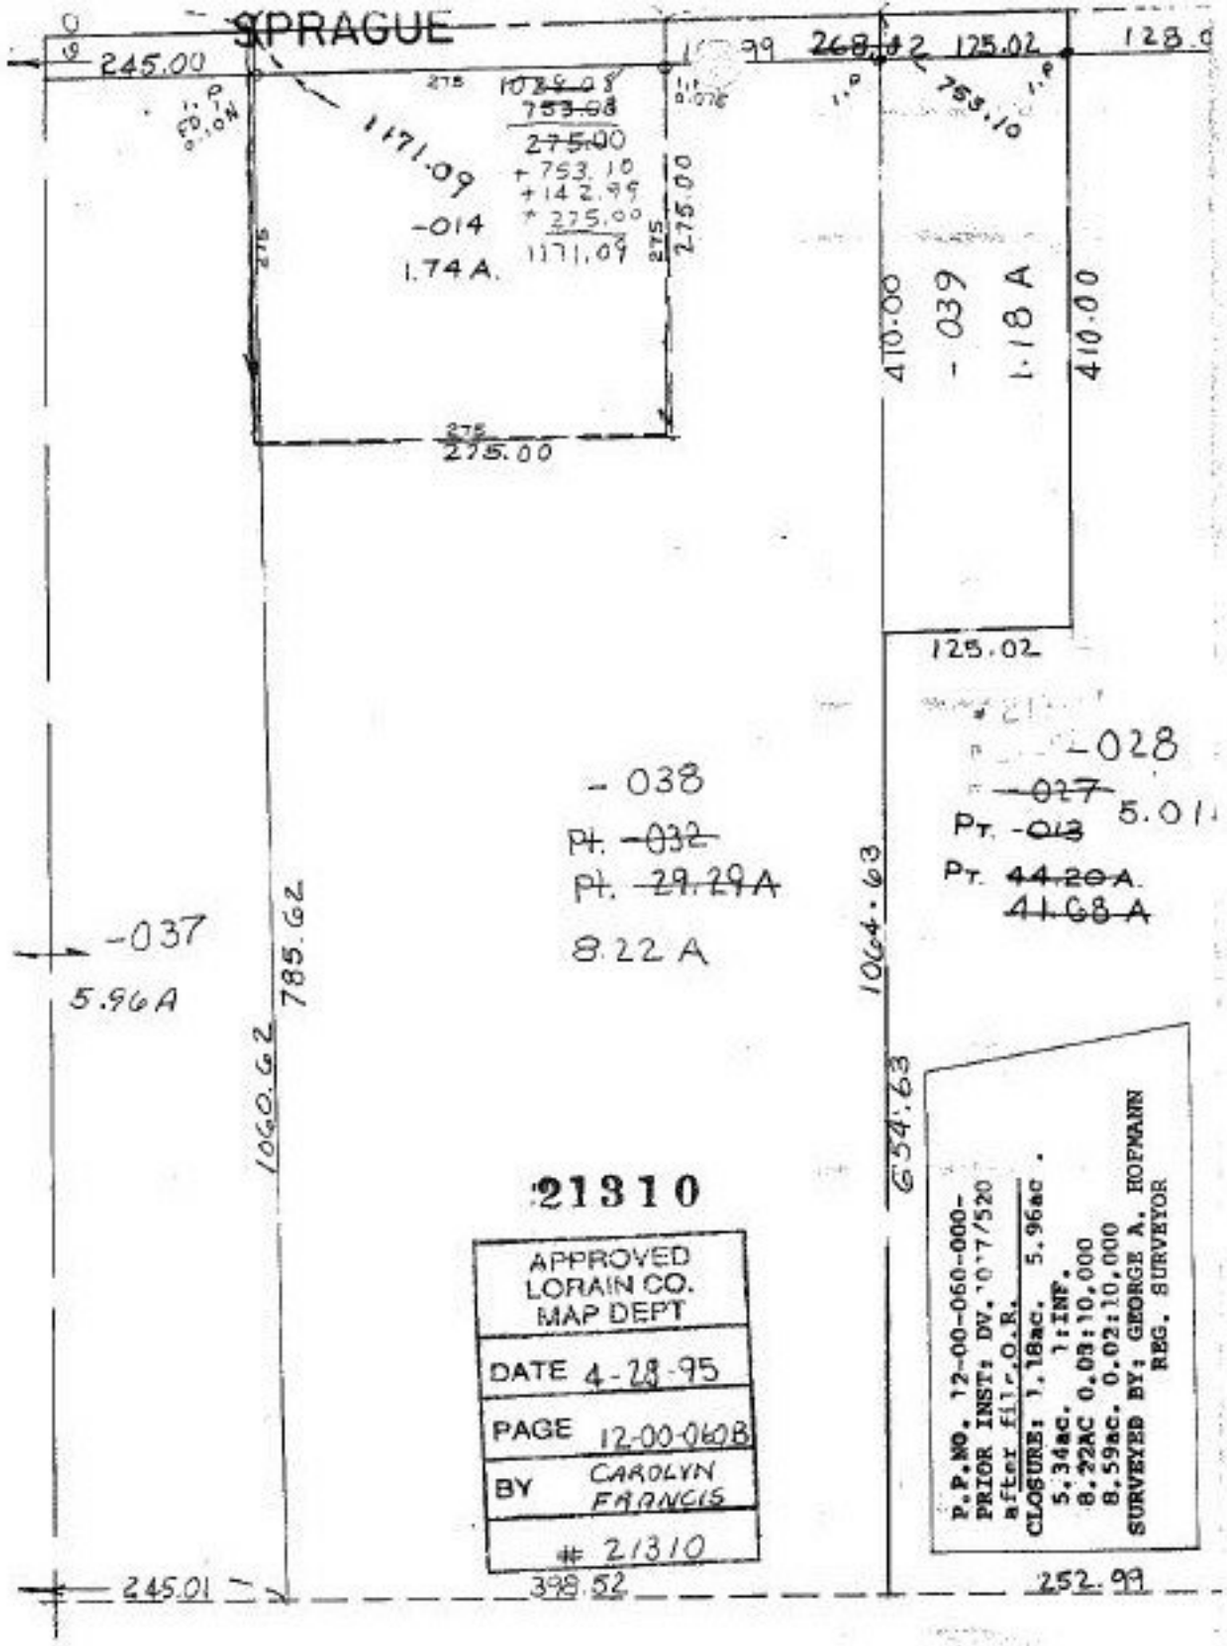
SPRAGUE
245.00
1171.09
-014
1.74 A.
275.00
275.00
125.02
125.02
410.00
410.00
-039
1.18 A
-038
Pt. -032
Pt. 29.29A
8.22 A
-028
-027
Pt. -013
Pt. 44.20A.
41.68 A
5.01
-037
5.96A
785.62
1060.62
1064.63
654.63
245.01
338.52
252.99
21310
APPROVED
LORAIN CO.
MAP DEPT
DATE 4-28-95
PAGE 12-00-060B
BY CAROLYN FRANCIS
21310
P.P.NO. 12-00-060-000-
PRIOR INST: DV. 1077/520
after file, O.R.
CLOSURE: 1.18ac. 5.96ac.
5.34ac. 1:INF.
8.22AC 0.03:10,000
8.59ac. 0.02:10,000
SURVEYED BY; GEORGE A. HOFMANN
REG. SURVEYOR

0178